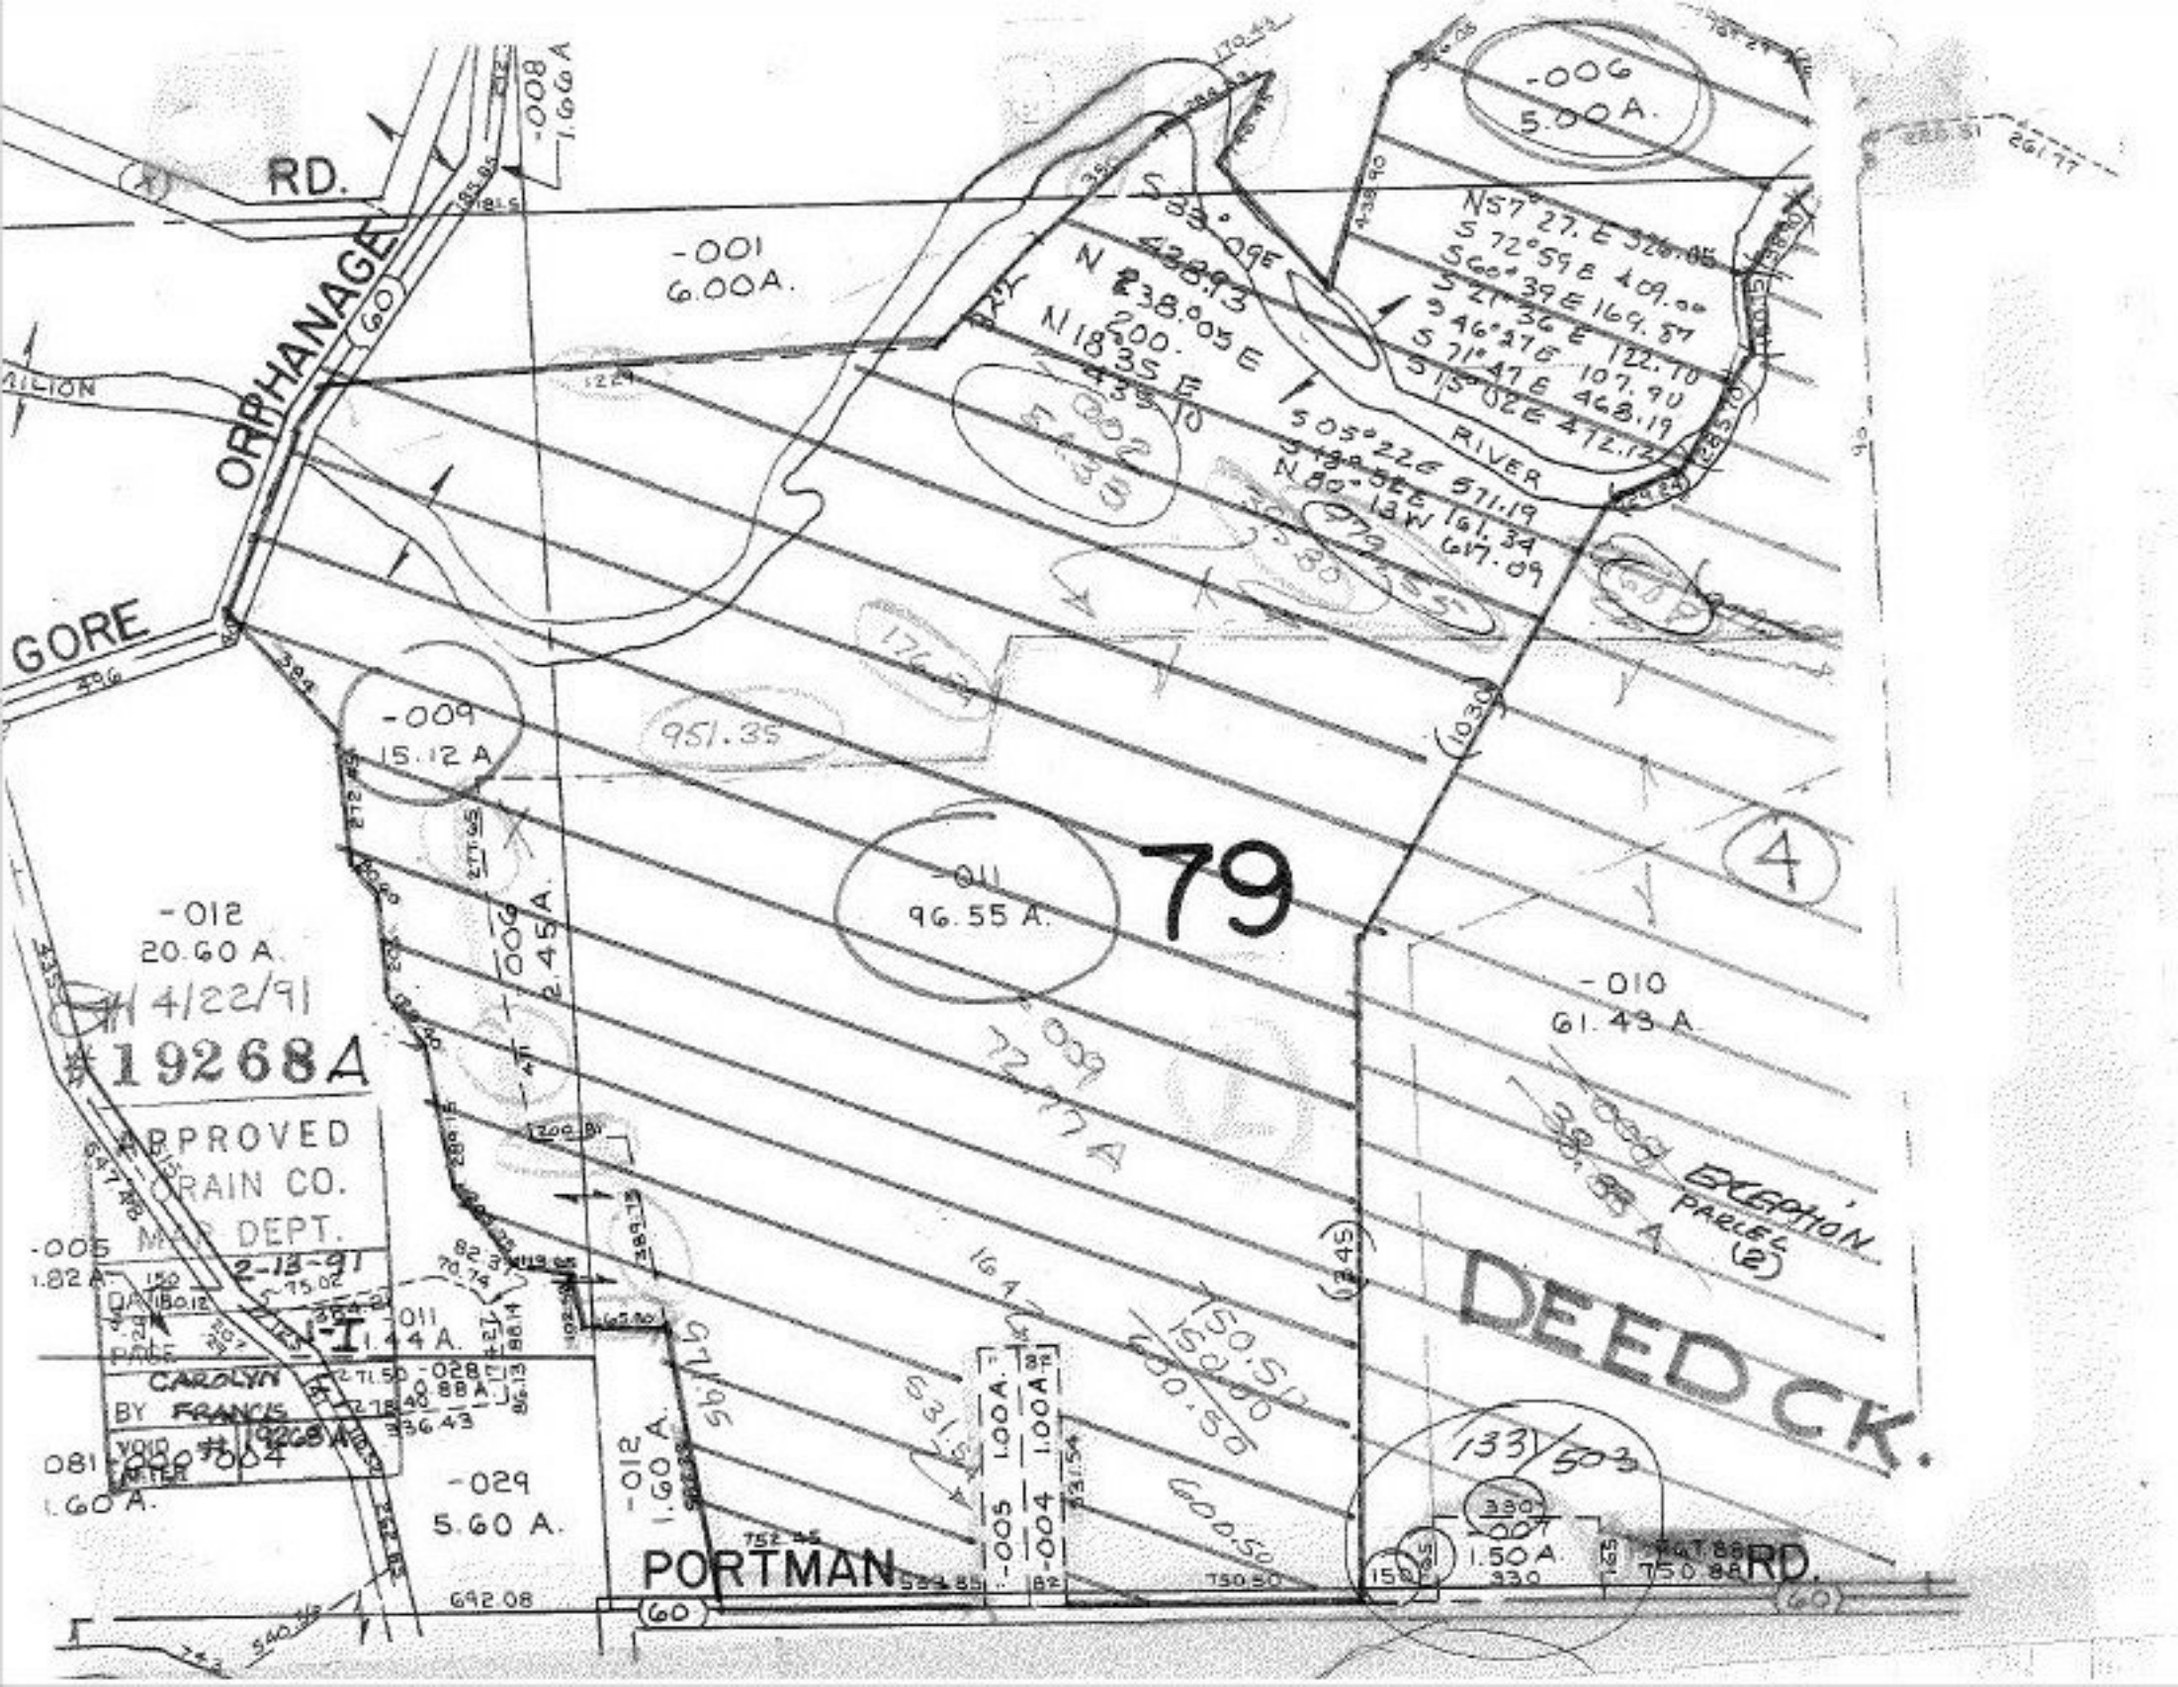
RD.
ORPHANAGE
GORE
-001
6.00A.
-006
5.00A.
-008
1.66A
-009
15.12 A
-011
96.55 A.
79
-012
20.60 A.
4/22/91
#19268A
APPROVED
DRAIN CO.
DEPT.
2-13-91
-005
1.82 A.
-I
1.44 A.
CAROLYN
BY FRANCIS
VOID
#19268A
-004
-029
5.60 A.
-012
1.60 A.
-010
61.43 A.
EXCEPTION
PARCEL (2)
DEED CK.
PORTMAN
RD.
-007
1.50 A.
-005
1.00A.
-004
1.00A.
RIVER
N57 27. E 326.05
S 72°59 E 109.00
S60°39 E 169.87
S 21°36 E 122.10
S 46°27 E 107.90
S 71°47 E 468.19
S 15°02 E 472.12
S 05°22 E 571.19
N 80°-58 E 181.34
N 18°35 E 617.09
S 33°09 E 388.13
N 38°05 E 200.
N 18°35 E 435.10
951.35
692.08