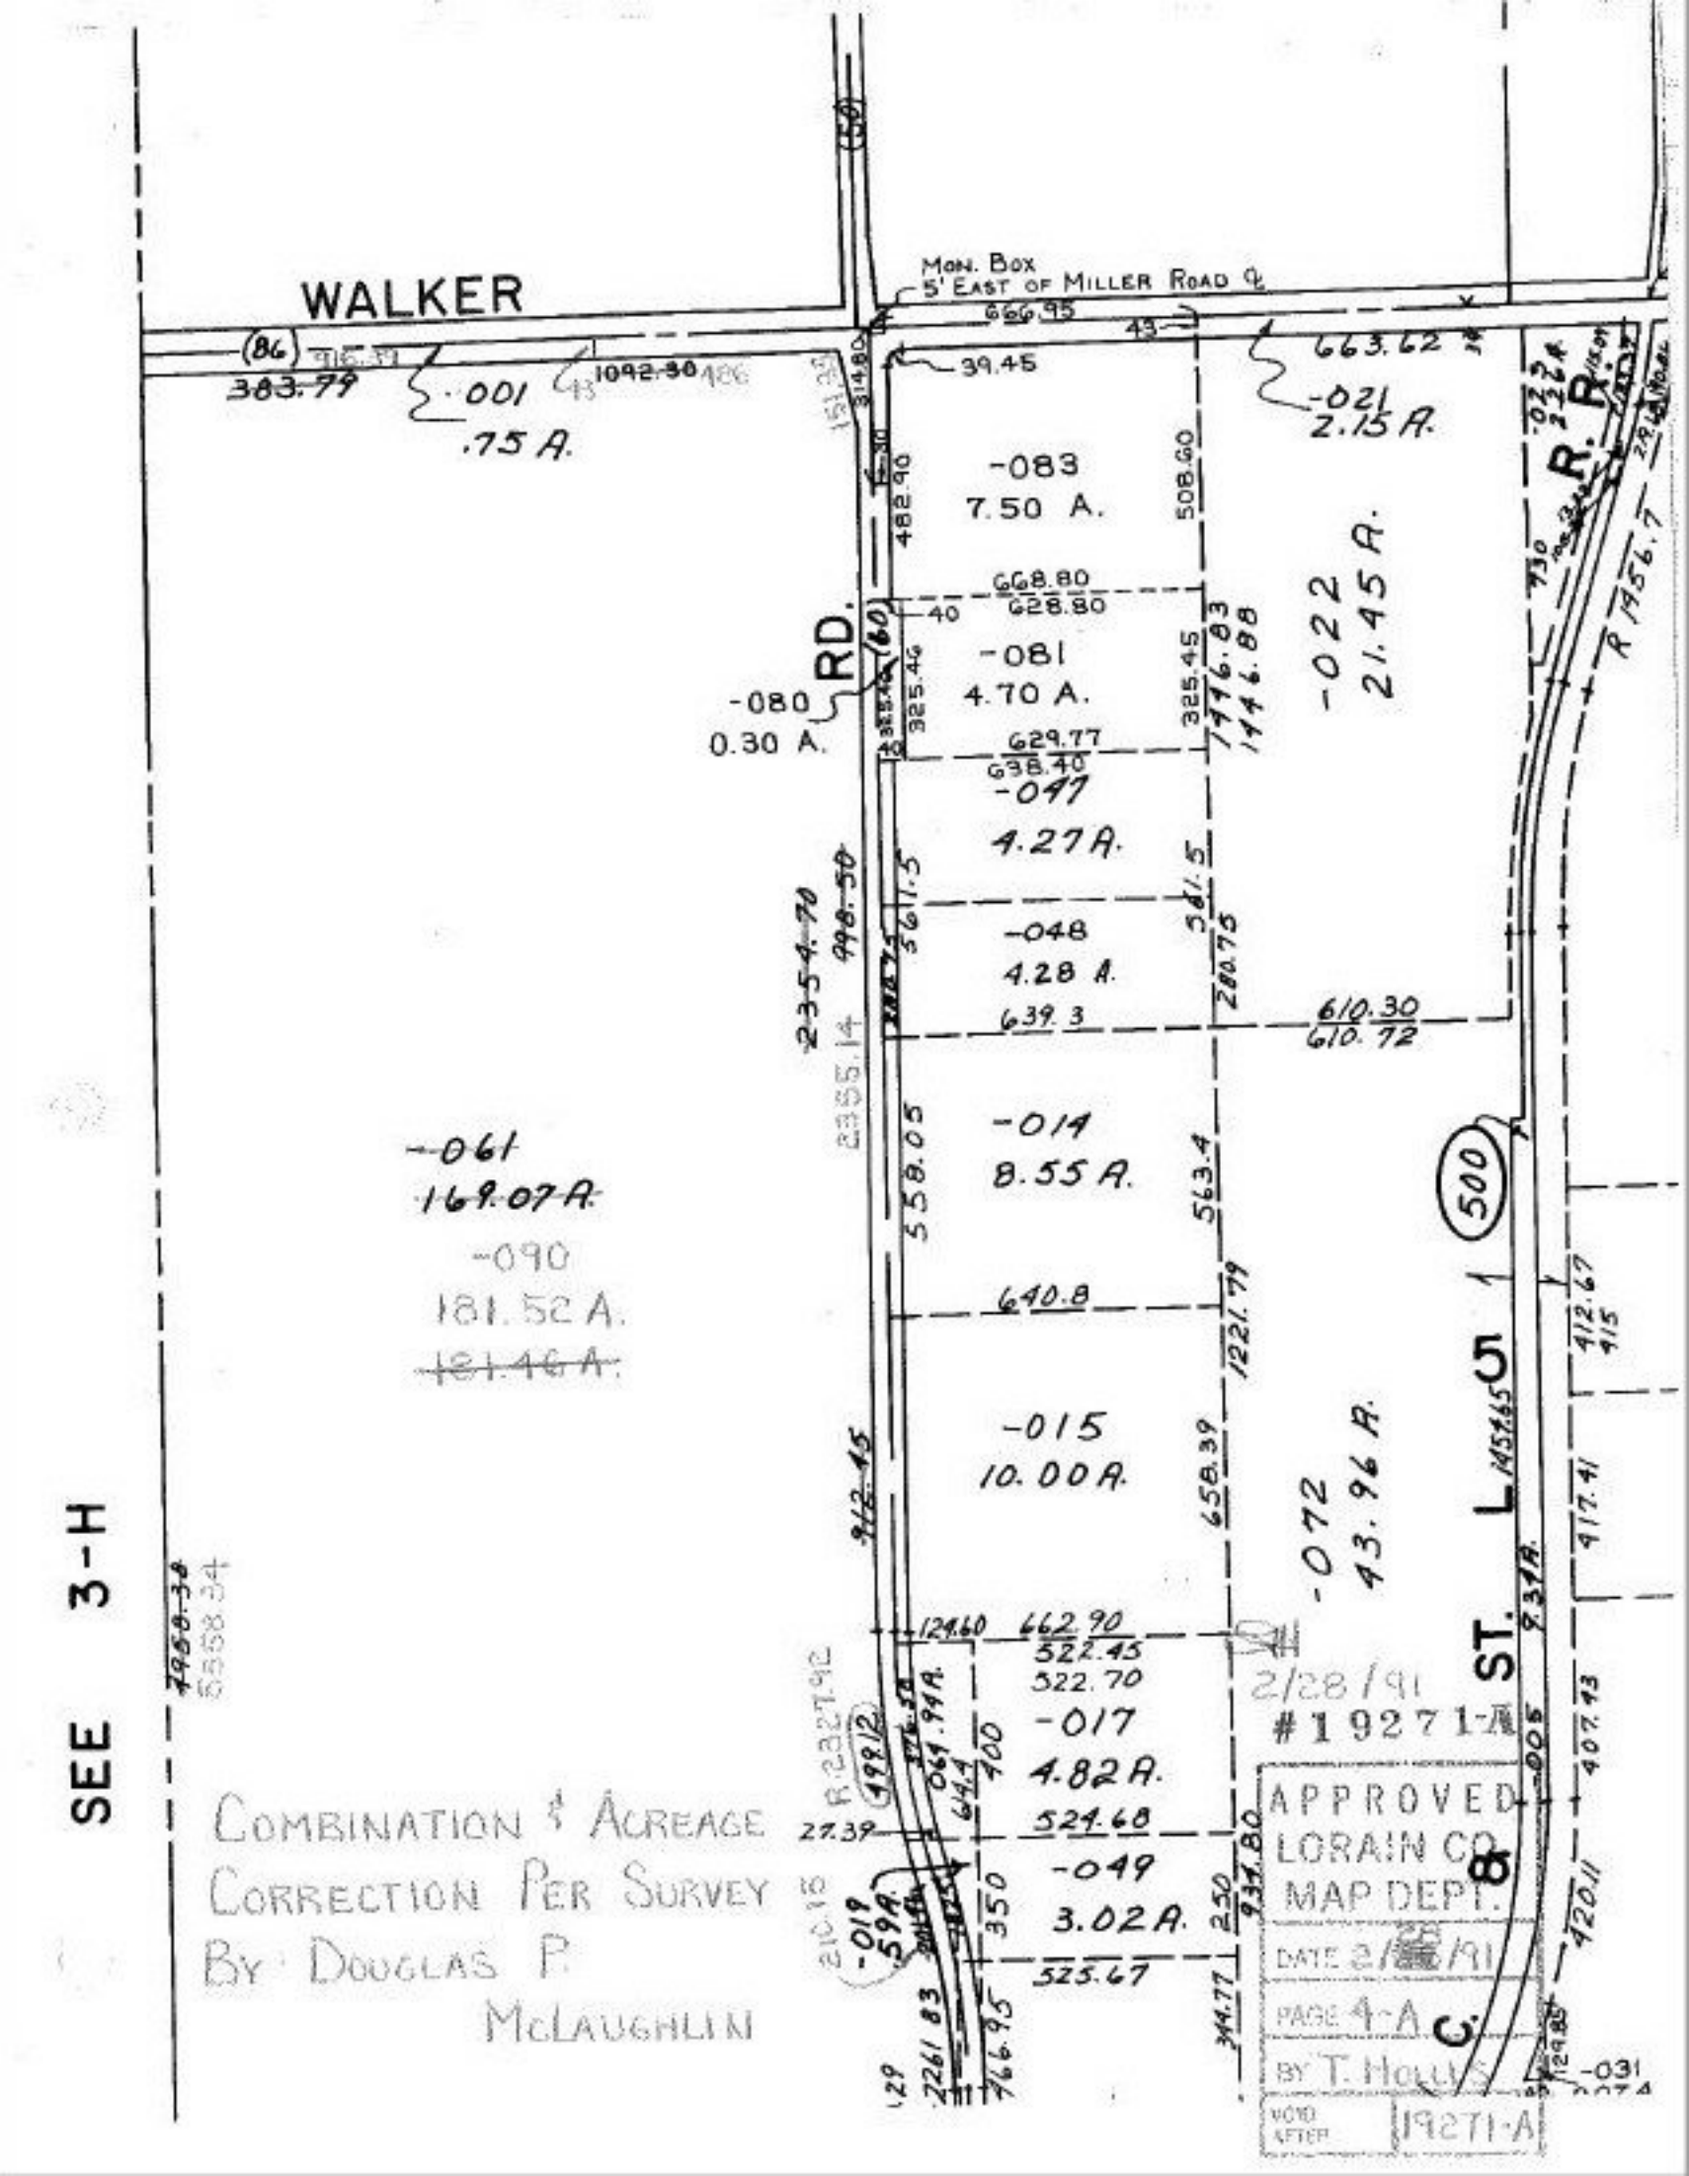
WALKER
MON. BOX
5' EAST OF MILLER ROAD ℄
666.95
39.45
663.62
-021
2.15 A.
-083
7.50 A.
-022
21.45 A.
-081
4.70 A.
-080
0.30 A.
RD.
-047
4.27 A.
-048
4.28 A.
-014
8.55 A.
-061
169.07 A.
-090
181.52 A.
181.46 A.
-015
10.00 A.
-072
43.96 A.
-017
4.82 A.
-049
3.02 A.
-019
59 A.
-001
.75 A.
383.79
1092.30
668.80
628.80
629.77
638.40
639.3
610.30
610.72
640.8
662.90
522.45
522.70
524.68
525.67
R. R.
C. & ST. L. 5
500
SEE 3-H
2/28/91
#19271-A
APPROVED
LORAIN CO.
MAP DEPT.
DATE 2/28/91
PAGE 4-A
BY T. HOLLIS
VOID AFTER 19271-A
COMBINATION & ACREAGE
CORRECTION PER SURVEY
BY DOUGLAS P.
McLAUGHLIN