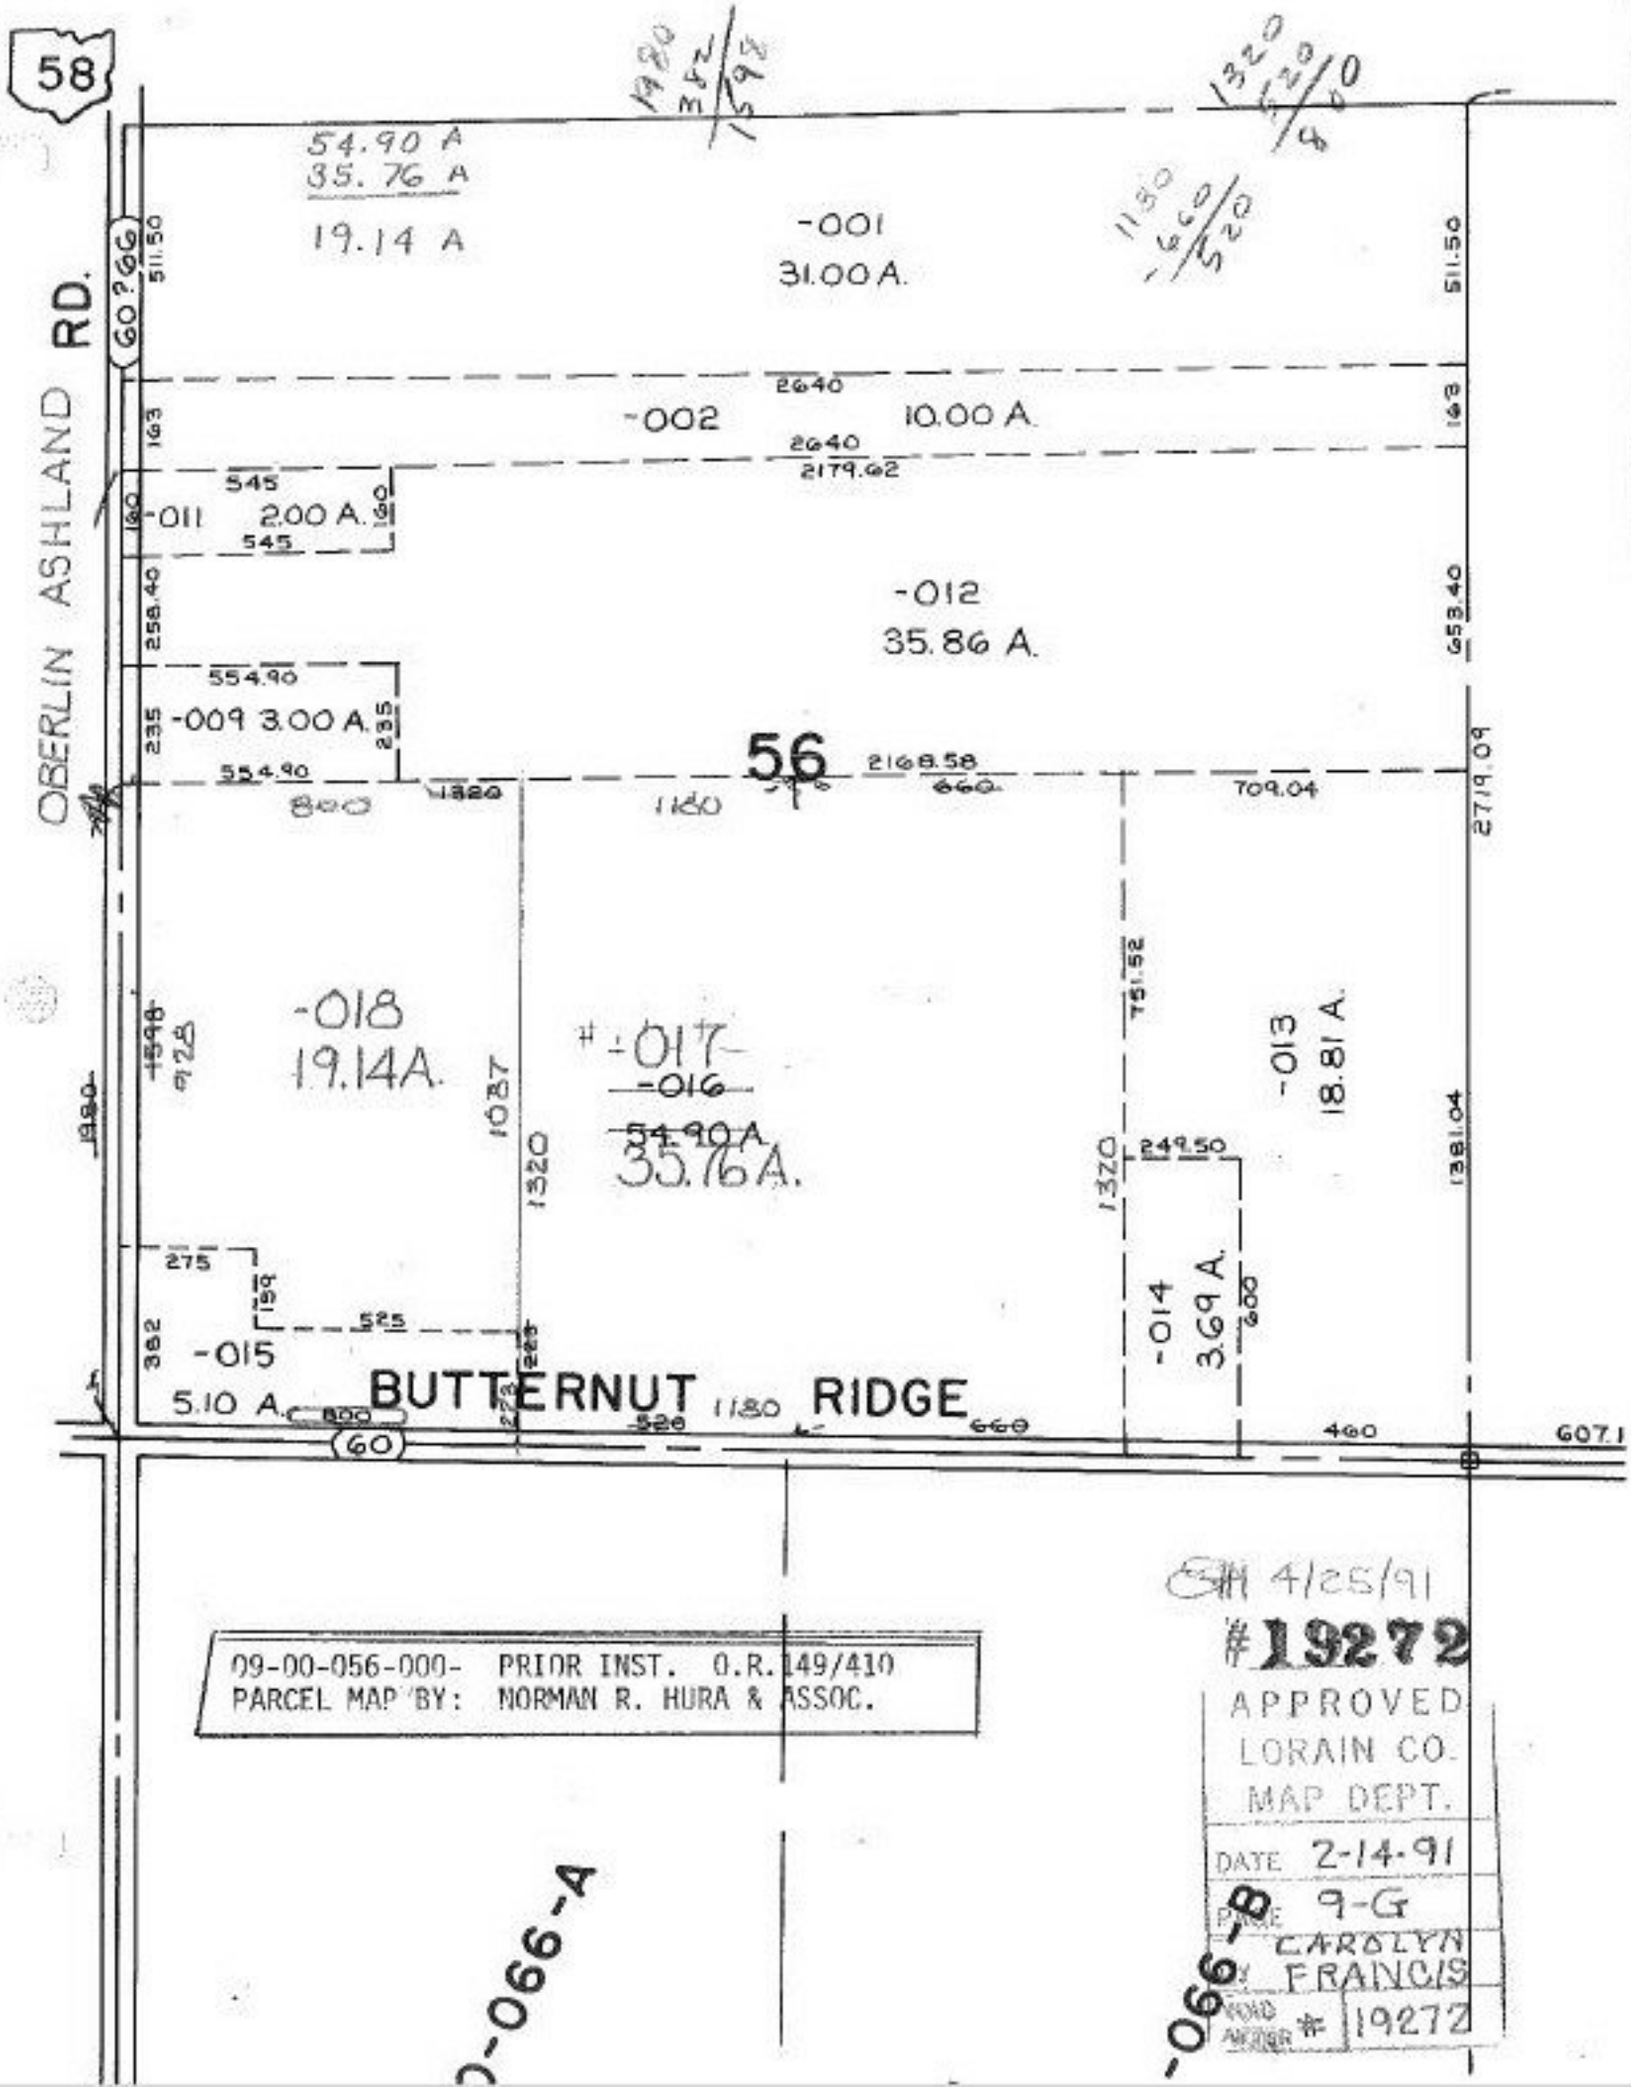
58
OBERLIN ASHLAND RD.
54.90 A
35.76 A
19.14 A
-001
31.00 A.
-002
10.00 A.
-011
2.00 A.
-012
35.86 A.
-009 3.00 A.
56
-018
19.14A.
-017
-016
54.90A
35.76A.
-013
18.81 A.
-014
3.69 A.
-015
5.10 A.
BUTTERNUT RIDGE
60
09-00-056-000- PRIOR INST. O.R. 149/410
PARCEL MAP BY: NORMAN R. HURA & ASSOC.
4/25/91
#19272
APPROVED
LORAIN CO.
MAP DEPT.
DATE 2-14-91
PAGE 9-G
CAROLYN FRANCIS
HOLD AFTER # 19272
-066-A
-066-B