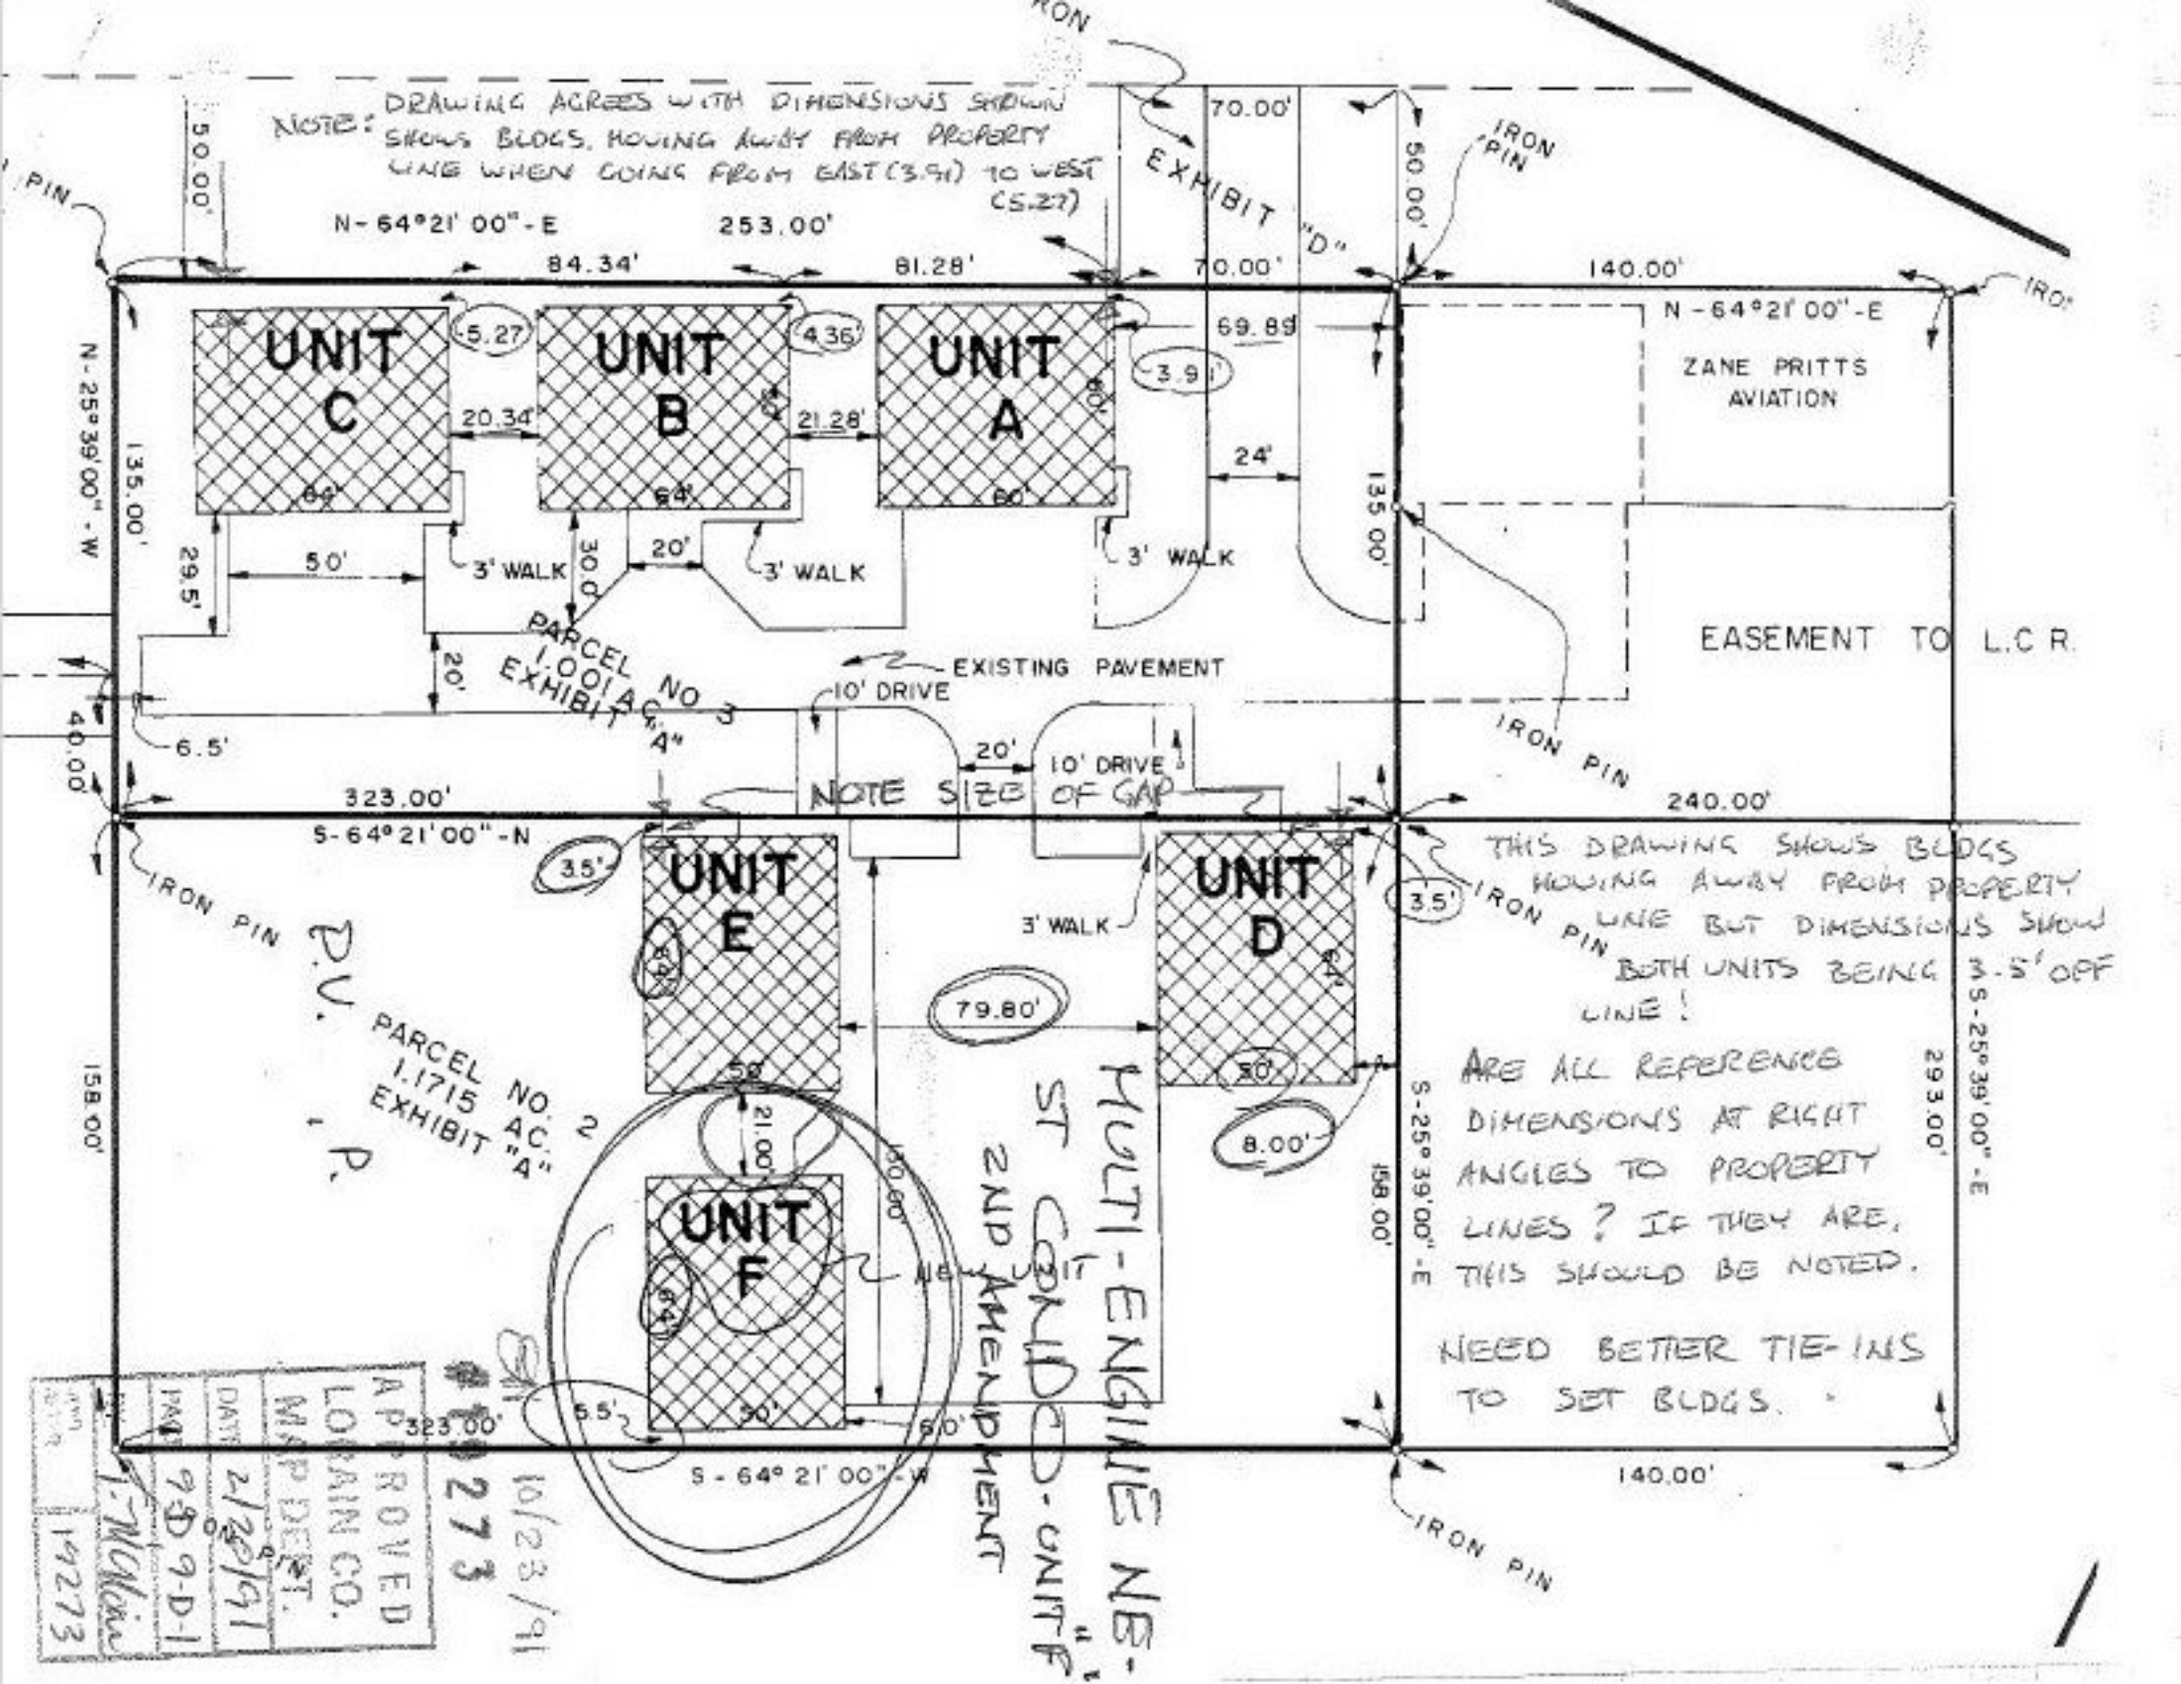
NOTE: DRAWING AGREES WITH DIMENSIONS SHOWN SHOWS BLDGS. MOVING AWAY FROM PROPERTY LINE WHEN GOING FROM EAST (3.91) TO WEST (5.27)
EXHIBIT "D"
IRON PIN
N-64°21'00"-E
253.00'
84.34'
81.28'
70.00'
140.00'
50.00'
UNIT C
UNIT B
UNIT A
UNIT D
UNIT E
UNIT F
5.27
4.36
3.91
69.89
20.34'
21.28'
24'
3' WALK
50'
20'
29.5'
30.0'
135.00'
N-25°39'00"-W
PARCEL NO 3 1.001 AC. EXHIBIT "A"
EXISTING PAVEMENT
10' DRIVE
6.5'
40.00'
323.00'
S-64°21'00"-N
NOTE SIZE OF GAP
240.00'
ZANE PRITTS AVIATION
EASEMENT TO L.C.R.
3.5'
79.80'
8.00'
21.00'
150.00'
158.00'
S-25°39'00"-E
293.00'
P.V. P.
PARCEL NO. 2 1.1715 AC. EXHIBIT "A"
NEW UNIT
5.5'
6.0'
S-64°21'00"-W
MULTI-ENGINE NE-ST CONDO-UNIT "F" 2ND AMENDMENT
THIS DRAWING SHOWS BLDGS MOVING AWAY FROM PROPERTY LINE BUT DIMENSIONS SHOW BOTH UNITS BEING 3.5' OFF LINE!
ARE ALL REFERENCE DIMENSIONS AT RIGHT ANGLES TO PROPERTY LINES? IF THEY ARE, THIS SHOULD BE NOTED.
NEED BETTER TIE-INS TO SET BLDGS.
APPROVED LORAIN CO. MAP DEPT.
DATE 2/20/91
PAGE 9-D 9-D-1
BY T. McKim
19273
10/23/91
#19273