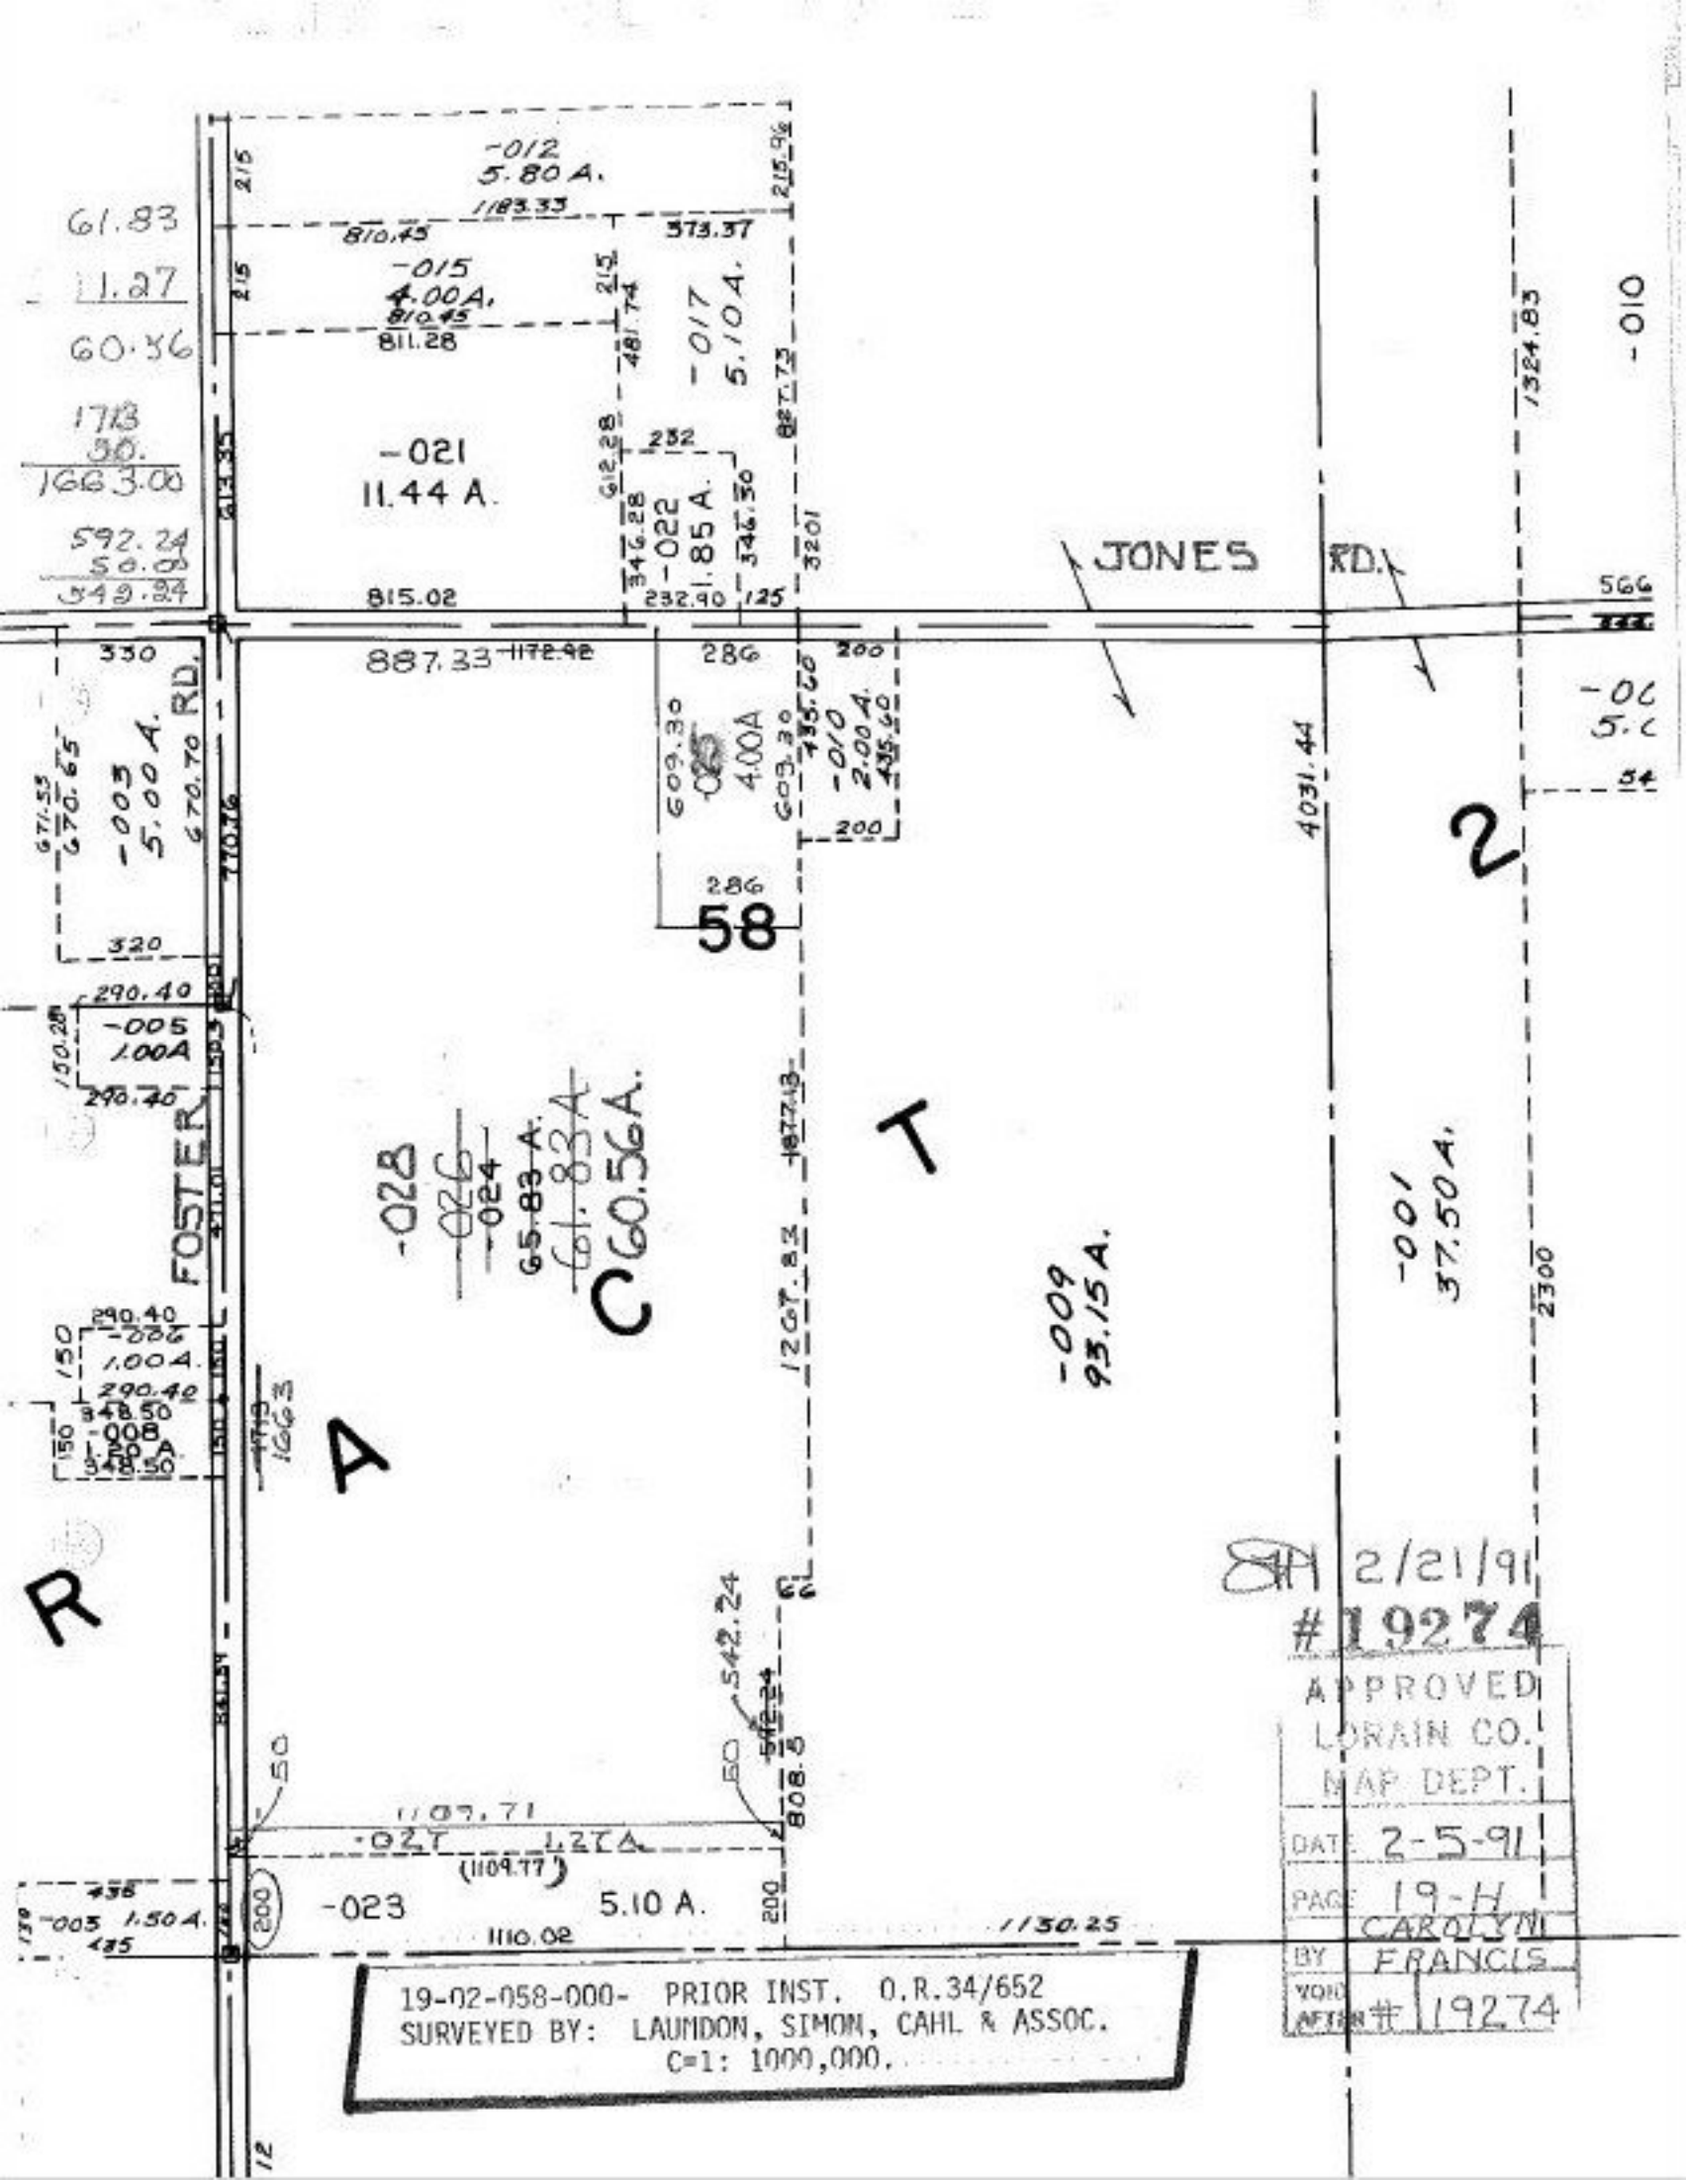
JONES RD.
FOSTER RD.
-012
5.80 A.
-015
4.00A.
-021
11.44 A.
-022
1.85 A.
-017
5.10A.
-010
-005
5.00 A.
-005
1.00A
-028
-026
-024
65.83 A.
60.56A.
-009
93.15A.
-001
37.50A.
-008
.50A.
-027
1.27A.
-023
5.10 A.
-005
1.50A.
58
T
A
R
2
2/21/91
#19274
APPROVED
LORAIN CO.
MAP DEPT.
DATE 2-5-91
PAGE 19-H
BY CAROLYN FRANCIS
VOID AFTER # 19274
19-02-058-000- PRIOR INST. O.R.34/652
SURVEYED BY: LAUNDON, SIMON, CAHL & ASSOC.
C=1: 1000,000.