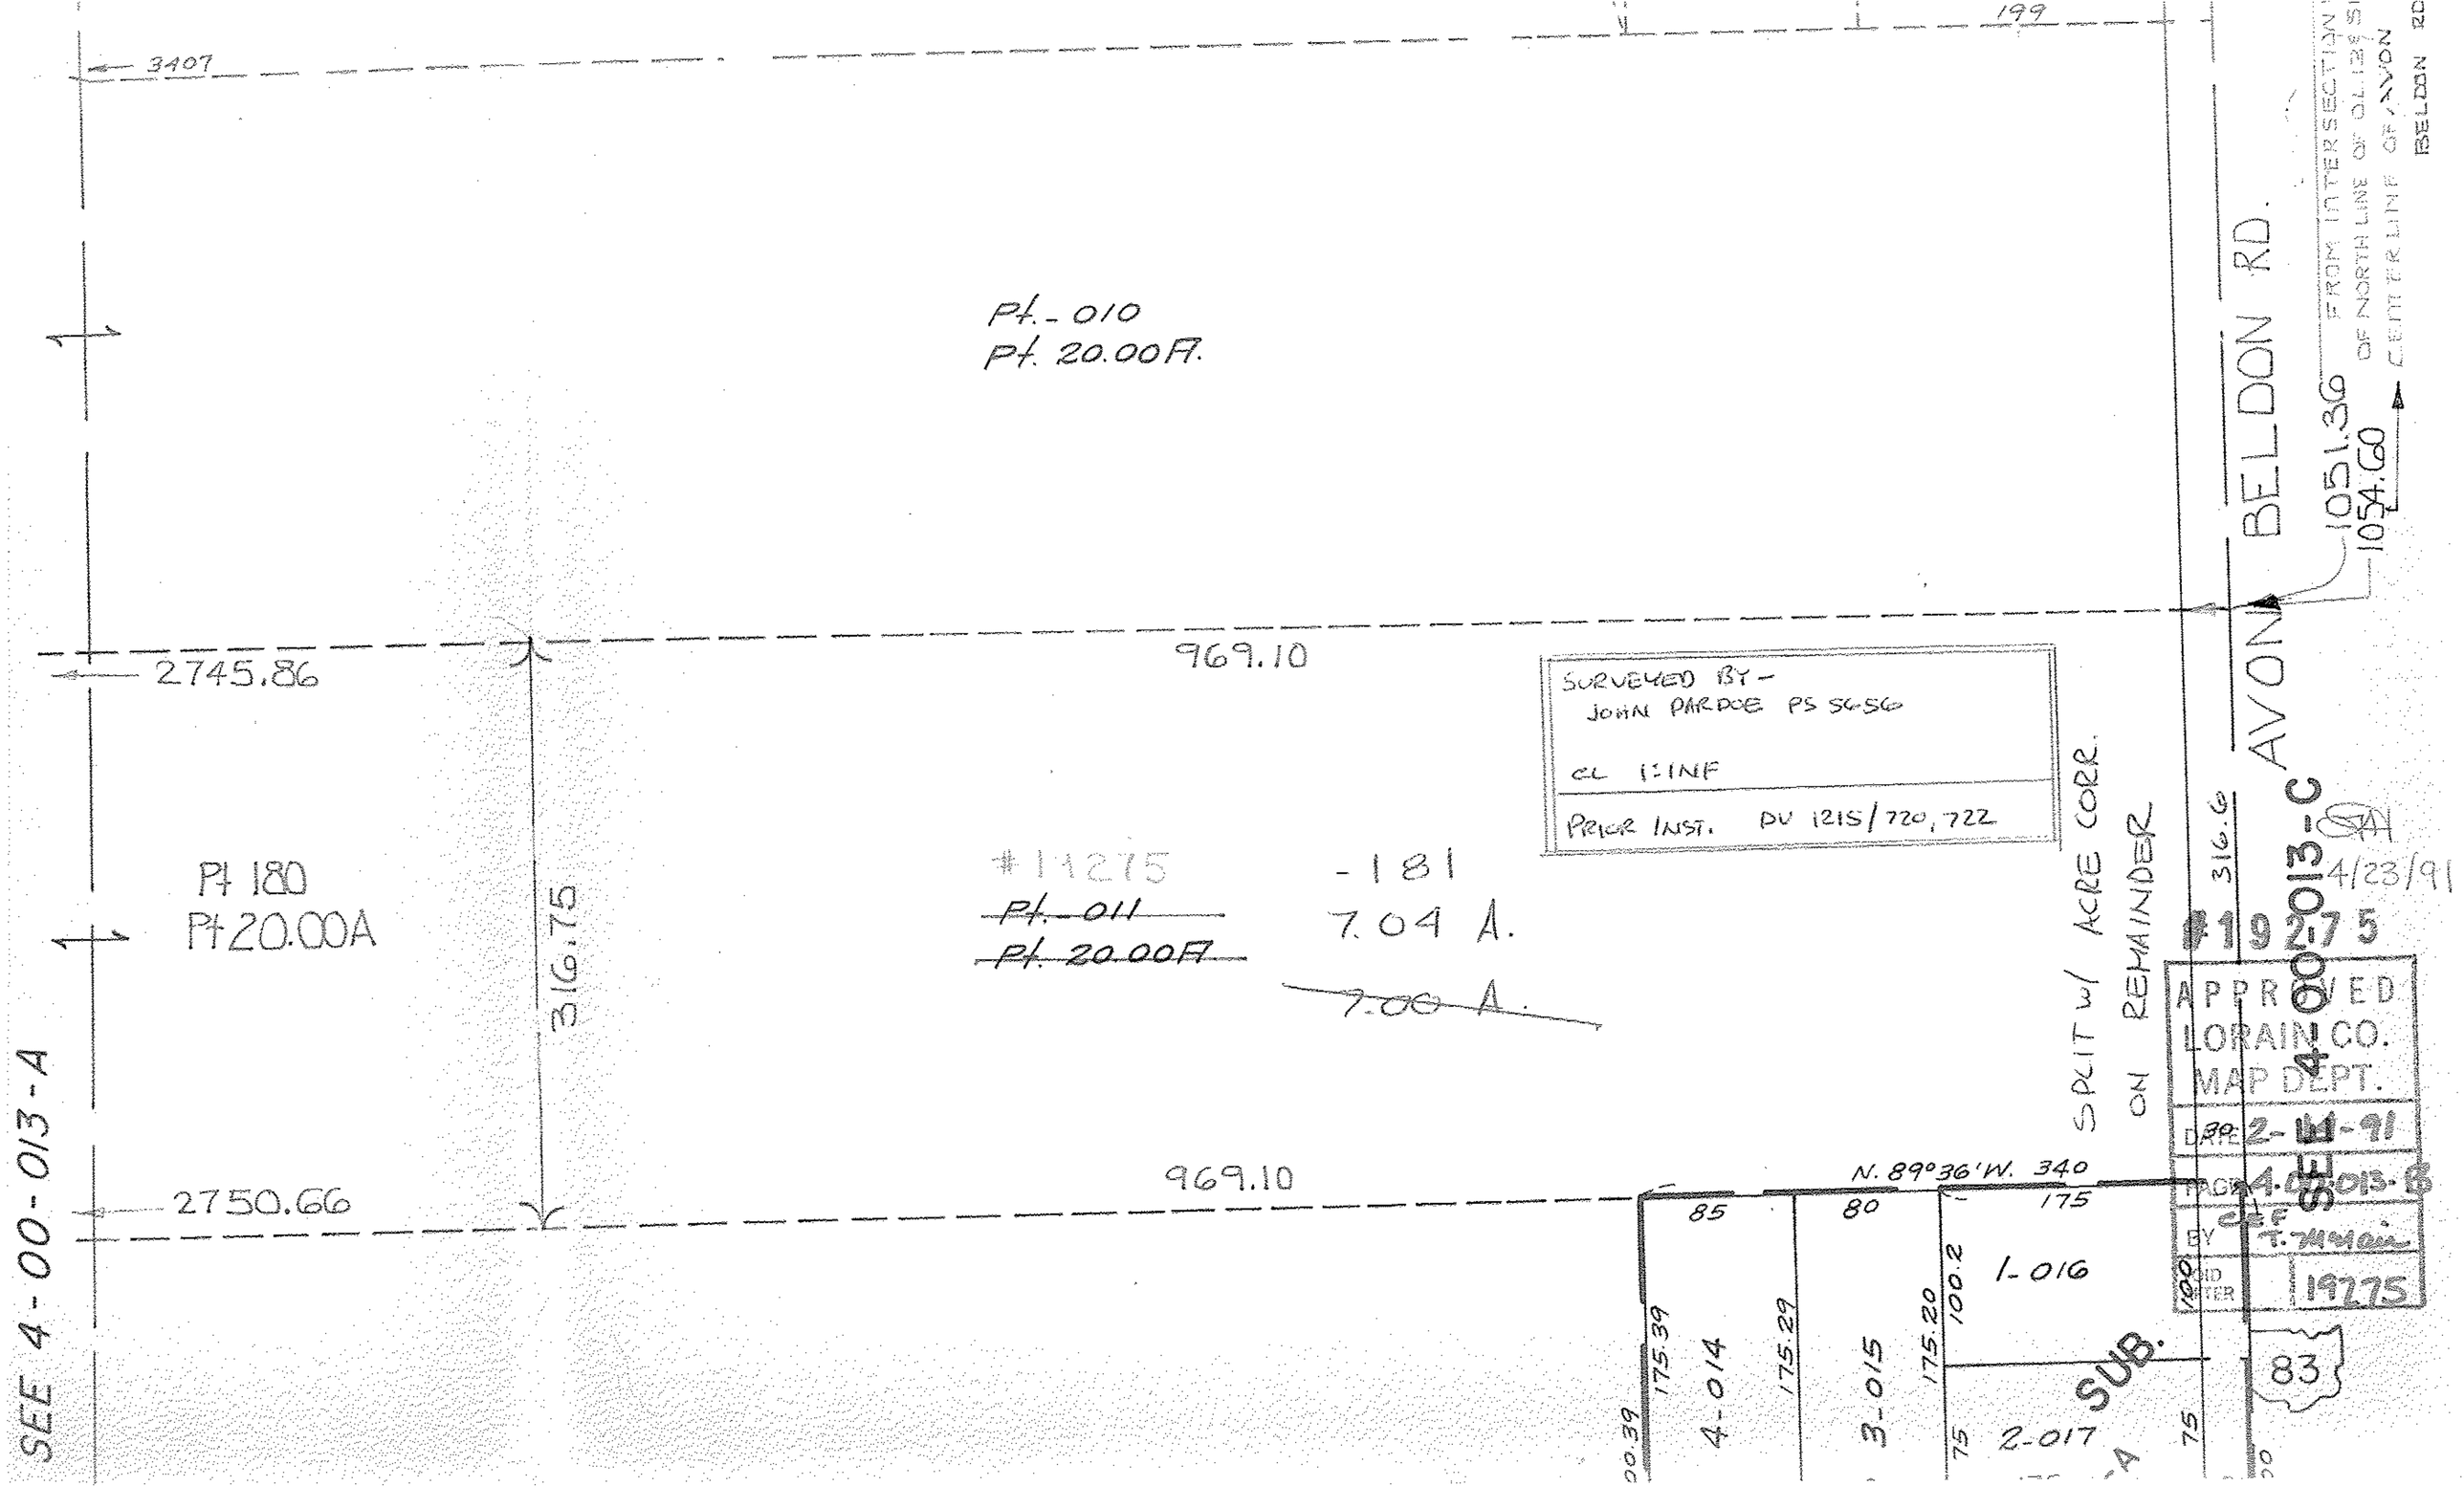

3407
199
Pt.-010
Pt. 20.00A.
2745.86
969.10
SURVEYED BY -
JOHN PARDOE PS 5656
CL 1:INF
PRIOR INST. DV 1215/720, 722
Pt 180
Pt 20.00A
316.75
#19275
Pt.-011
Pt. 20.00A
-181
7.04 A.
7.00 A.
SPLIT W/ ACRE CORR.
ON REMAINDER
316.6
AVON BELDON RD.
1051.36
1054.60
FROM INTERSECTION OF NORTH LINE OF OLIVE ST CENTERLINE OF AVON BELDON RD
4/23/91
#19275
APPROVED
LORAIN CO.
MAP DEPT.
DATE 2-11-91
PAGE 4-00-013-B
BY
OLD ENTER 19275
SEE 4-00-013-C
2750.66
969.10
N. 89°36'W. 340
85
80
175
1-016
100.2
175.39
175.29
175.20
4-014
3-015
2-017
SUB.
83
SEE 4-00-013-A