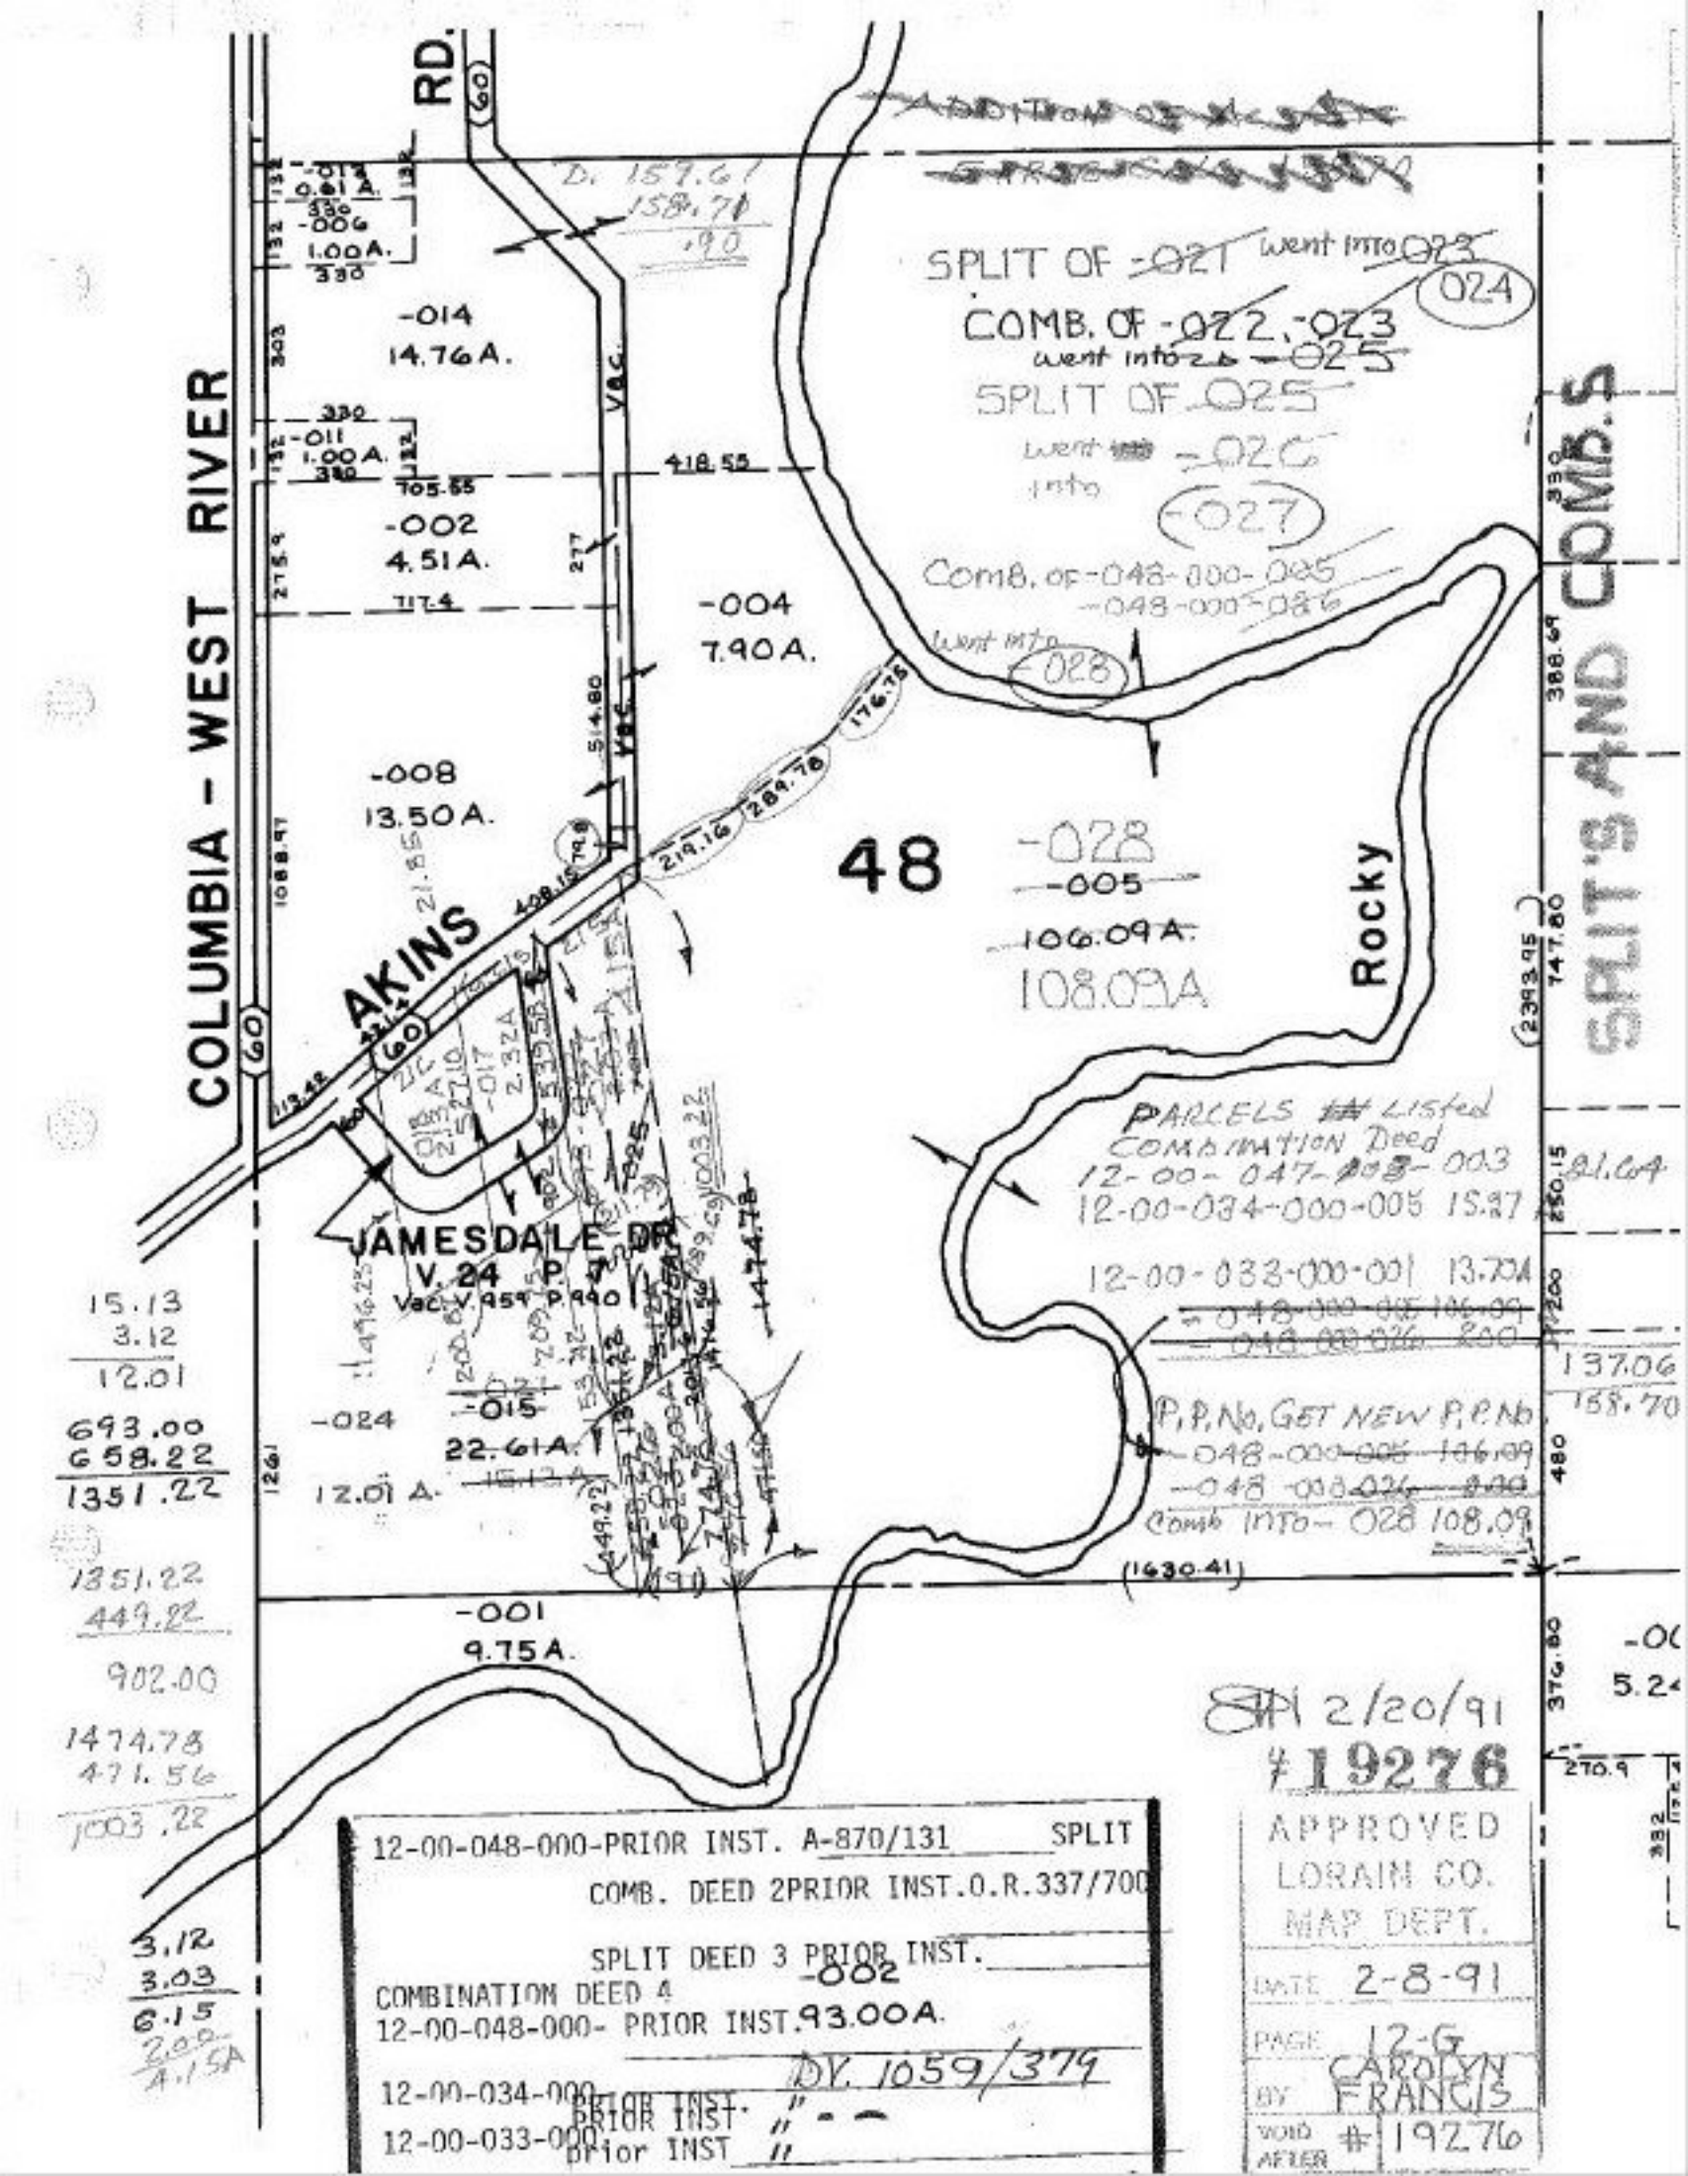

COLUMBIA - WEST RIVER
RD.
AKINS
JAMESDALE DR
V. 24 P. 7
Vac. V. 959 P. 990
48
Rocky
SPLIT'S AND COMB.S
SPLIT OF -021 went into 023
024
COMB. OF -022, -023
went into 025
SPLIT OF 025
went into -026
-027
COMB. OF -048-000-005
-048-000-026
went into -028
-028
-005
106.09A.
108.09A
PARCELS Listed
COMBINATION Deed
12-00-047-008-003
12-00-034-000-005 15.27
12-00-033-000-001 13.70A
P.P. No. GET NEW P.P. No.
Comb into -028 108.09
-014
14.76A.
-002
4.51A.
-004
7.90A.
-008
13.50A.
-015
22.61A.
-024
12.01 A.
-001
9.75A.
15.13
3.12
12.01
693.00
658.22
1351.22
1351.22
449.22
902.00
1474.78
471.56
1003.22
3.12
3.03
6.15
2.00
4.15A
137.06
158.70
2/20/91
#19276
APPROVED
LORAIN CO.
MAP DEPT.
DATE 2-8-91
PAGE 12-G
BY CAROLYN FRANCIS
VOID AFTER # 19276
12-00-048-000-PRIOR INST. A-870/131 SPLIT
COMB. DEED 2PRIOR INST.O.R.337/700
SPLIT DEED 3 PRIOR INST.
COMBINATION DEED 4
12-00-048-000- PRIOR INST. -002 93.00A.
DY. 1059/379
12-00-034-000 PRIOR INST. "
12-00-033-000 prior INST "