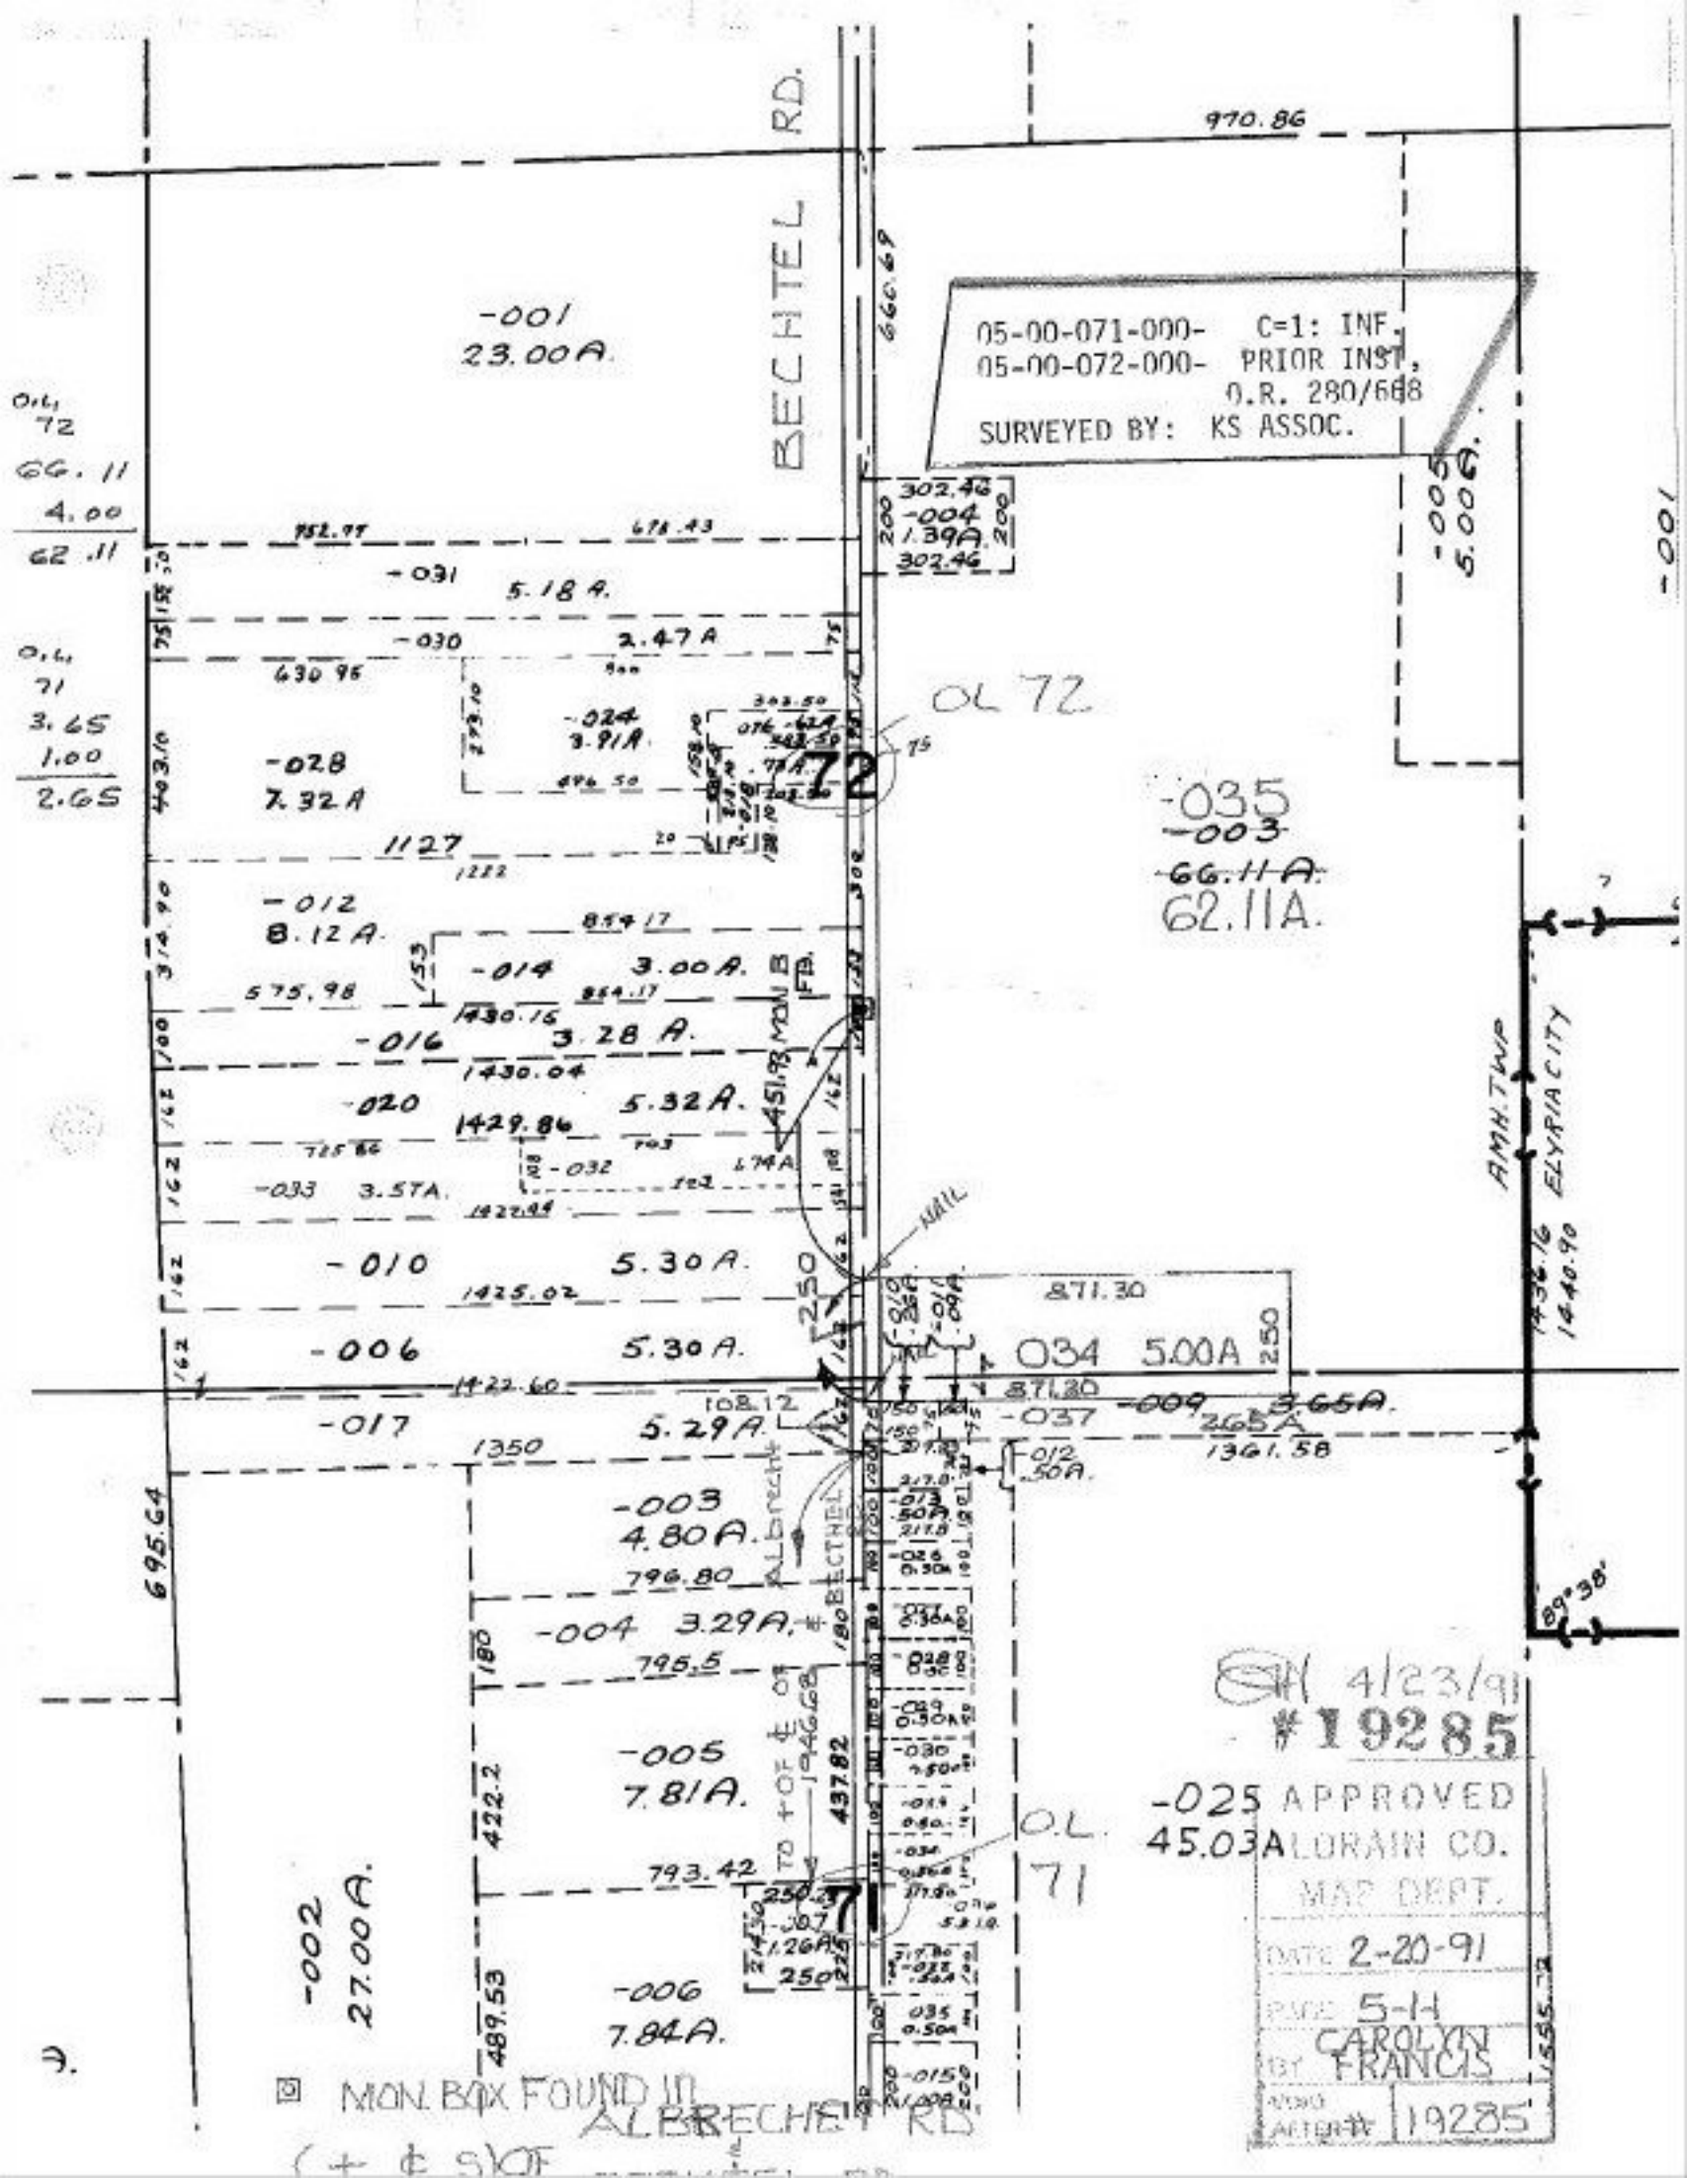

BECHTEL RD.
970.86
05-00-071-000- C=1: INF.
05-00-072-000- PRIOR INST,
O.R. 280/668
SURVEYED BY: KS ASSOC.
-001
23.00A.
-031
5.18 A.
-030
2.47 A
-024
3.91A
-028
7.32 A
OL 72
72
-035
-003
66.11 A.
62.11A.
-012
8.12 A.
-014
3.00 A.
-016
3.28 A.
-020
5.32 A.
-033
3.57A.
-010
5.30 A.
-006
5.30 A.
-017
5.29 A.
-003
4.80 A.
-004
3.29 A.
-005
7.81 A.
-006
7.84 A.
-002
27.00 A.
-025
45.03A
O.L.
71
71
-009
3.65A.
-037
-012
.50A.
-005
5.00A.
AMH. TWP
ELYRIA CITY
ALBRECHT
BECHTEL RD
TO + OF ℄ OF
MON. BOX FOUND IN
ALBRECHT RD
(+ ℄ S) OF
4/23/91
#19285
APPROVED
LORAIN CO.
MAP DEPT.
DATE 2-20-91
PAGE 5-11
BY CAROLYN FRANCIS
19285