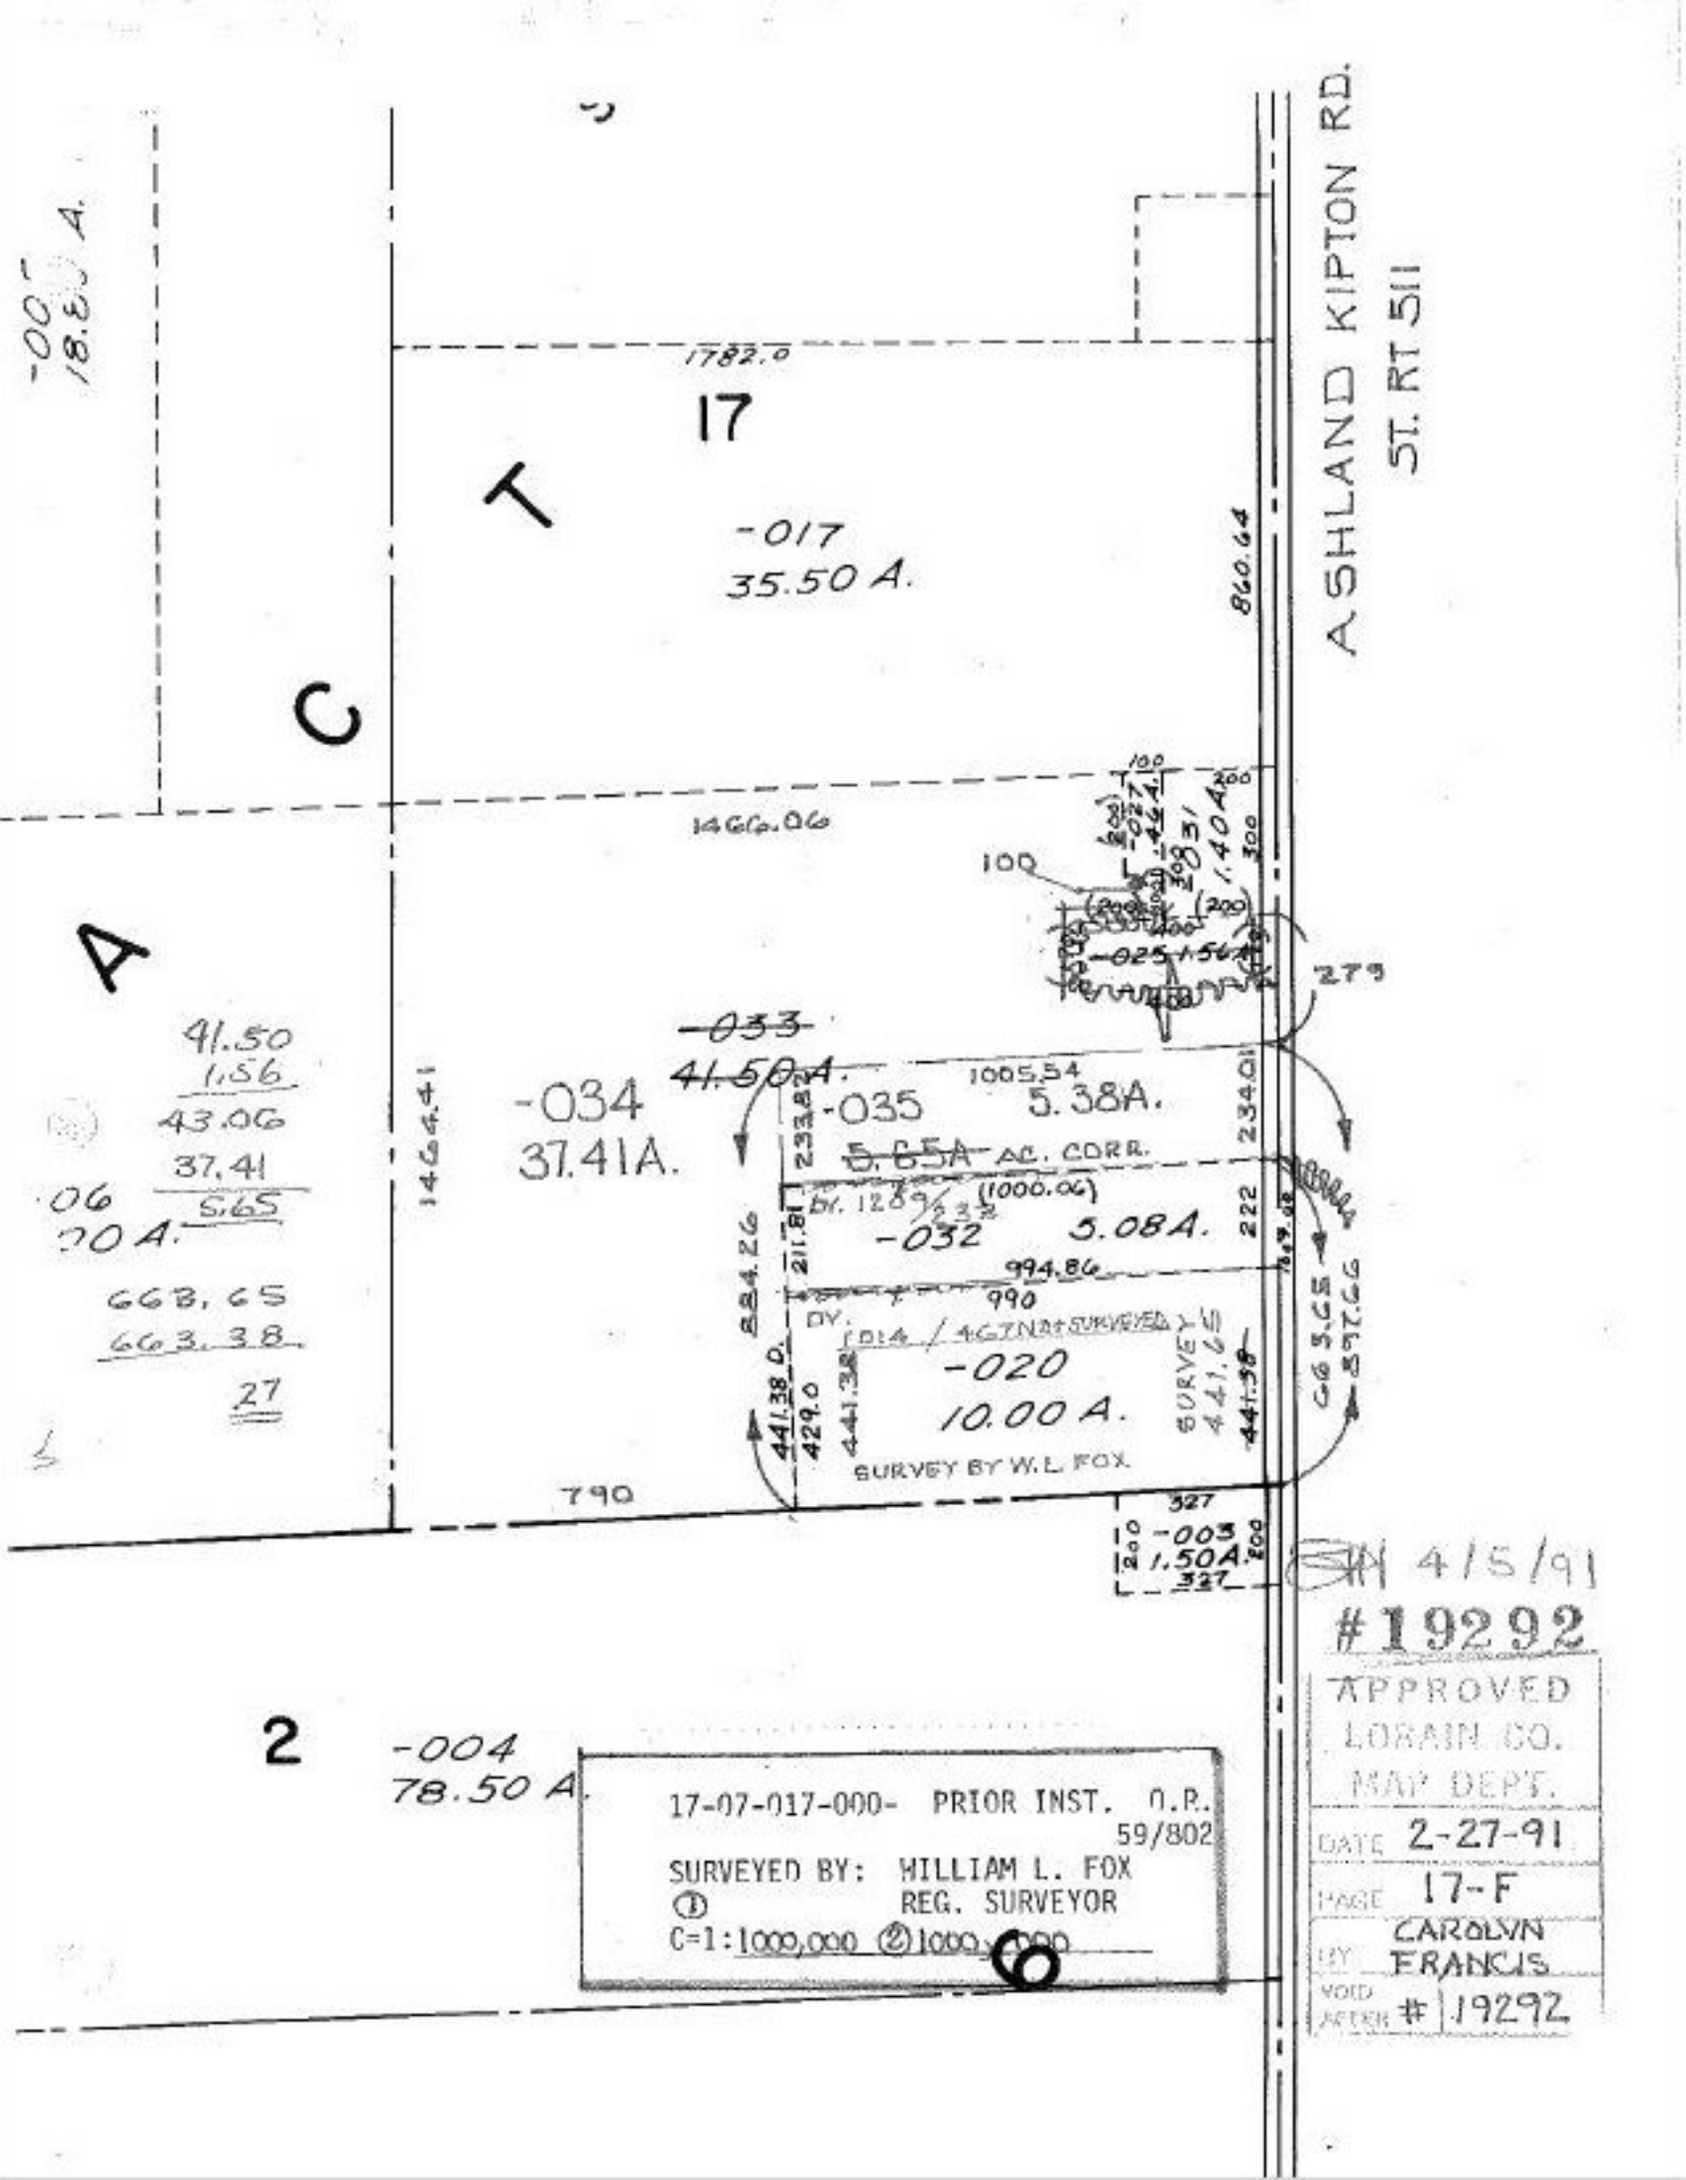

17-07-017-000- PRIOR INST. O.R. 59/802

SURVEYED BY: WILLIAM L. FOX
① REG. SURVEYOR
C=1:1000,000 ②1000,000

4/5/91
#19292
APPROVED
LORAIN CO.
MAP DEPT.
DATE 2-27-91
PAGE 17-F
BY CAROLYN FRANCIS
VOID AFTER # 19292