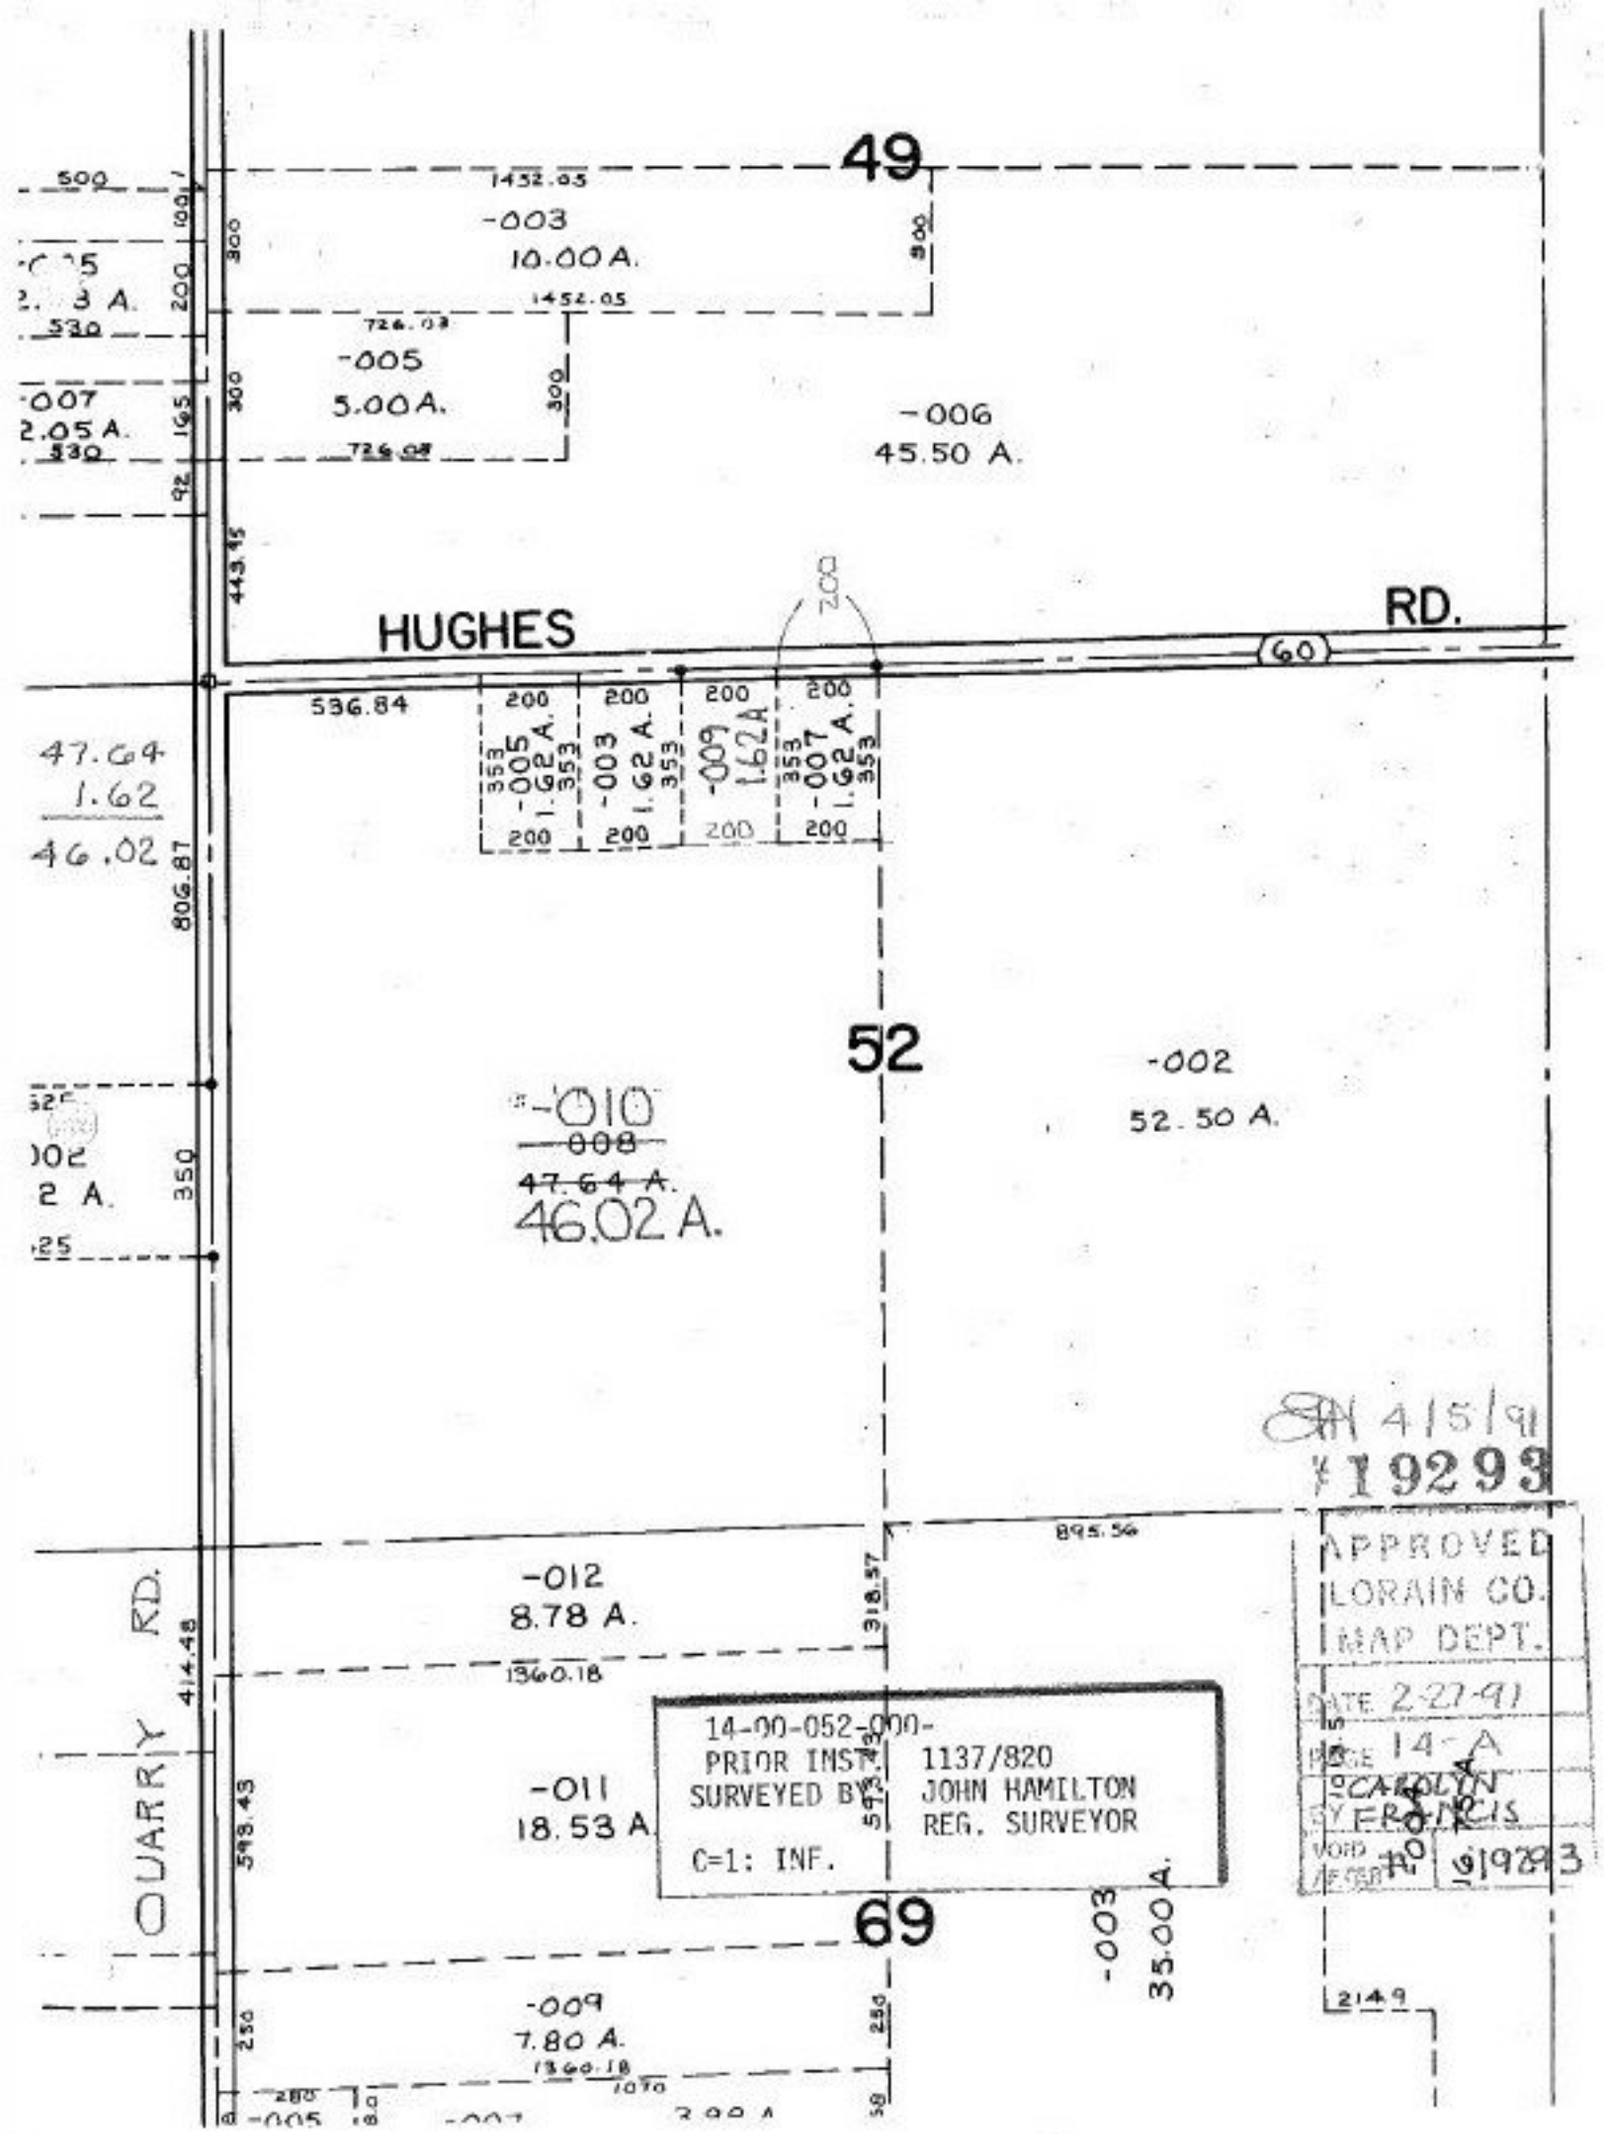
49
-003
10.00 A.
1452.05
-005
5.00 A.
726.03
726.08
-006
45.50 A.
HUGHES
RD.
60
536.84
200
353
-005
1.62 A.
-003
1.62 A.
-009
1.62 A.
-007
1.62 A.
47.64
1.62
46.02
806.87
52
-002
52.50 A.
-010
~~-008~~
~~47.64 A.~~
46.02 A.
895.56
-012
8.78 A.
318.57
1360.18
QUARRY RD.
414.48
-011
18.53 A.
593.43
14-00-052-000-
PRIOR INST. 1137/820
SURVEYED BY JOHN HAMILTON
REG. SURVEYOR
C=1: INF.
69
-003
35.00 A.
-009
7.80 A.
1360.18
2149
4/5/91
#19293
APPROVED
LORAIN CO.
MAP DEPT.
DATE 2-27-91
PAGE 14-A
BY CAROLYN FRANCIS
VOID AFTER #19293