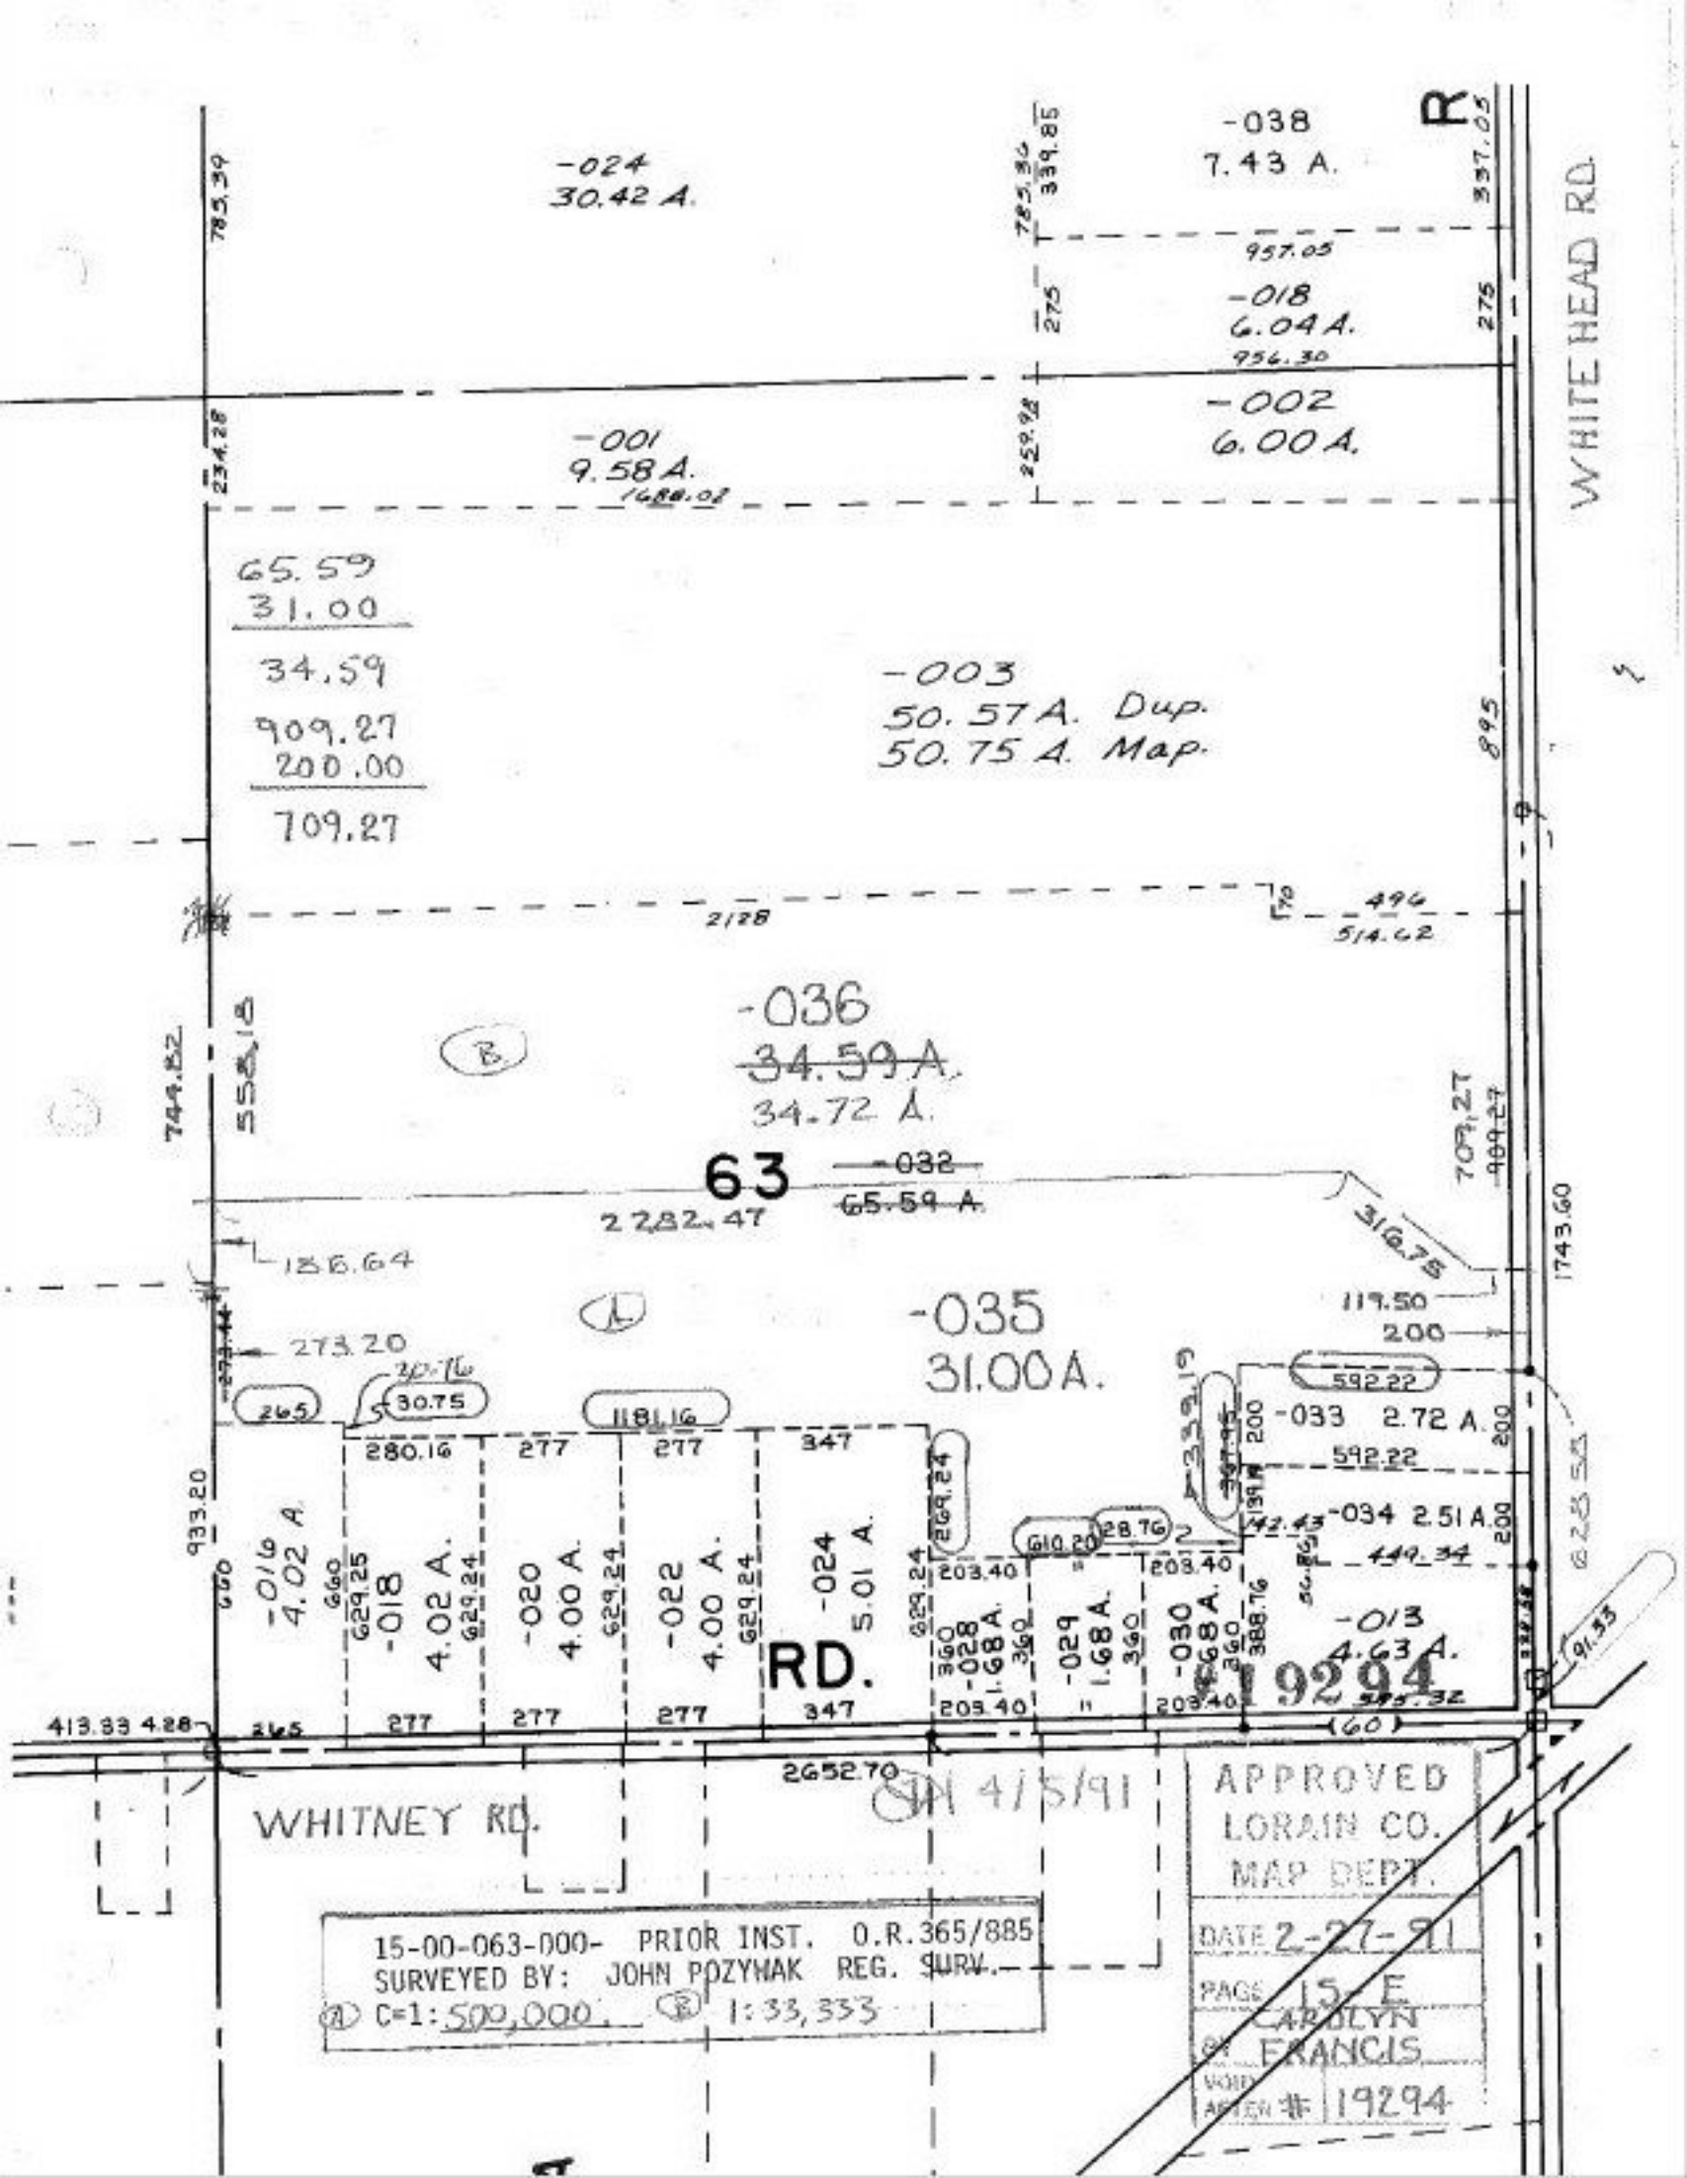
-024
30.42 A.
-038
7.43 A.
-018
6.04 A.
-002
6.00 A.
-001
9.58 A.
-003
50.57 A. Dup.
50.75 A. Map.
-036
34.59 A.
34.72 A.
63
-032
65.59 A.
-035
31.00 A.
-033 2.72 A.
-034 2.51 A.
-013
4.63 A.
-016
4.02 A.
-018
4.02 A.
-020
4.00 A.
-022
4.00 A.
-024
5.01 A.
-028
1.68 A.
-029
1.68 A.
-030
1.68 A.
RD.
WHITE HEAD RD.
WHITNEY RD.
19294
APPROVED
LORAIN CO.
MAP DEPT.
DATE 2-27-91
PAGE 15 E
BY CAROLYN FRANCIS
VOID ARTEN # 19294
15-00-063-000- PRIOR INST. O.R. 365/885
SURVEYED BY: JOHN POZYMAK REG. SURV.
(A) C=1: 500,000. (B) 1:33,333