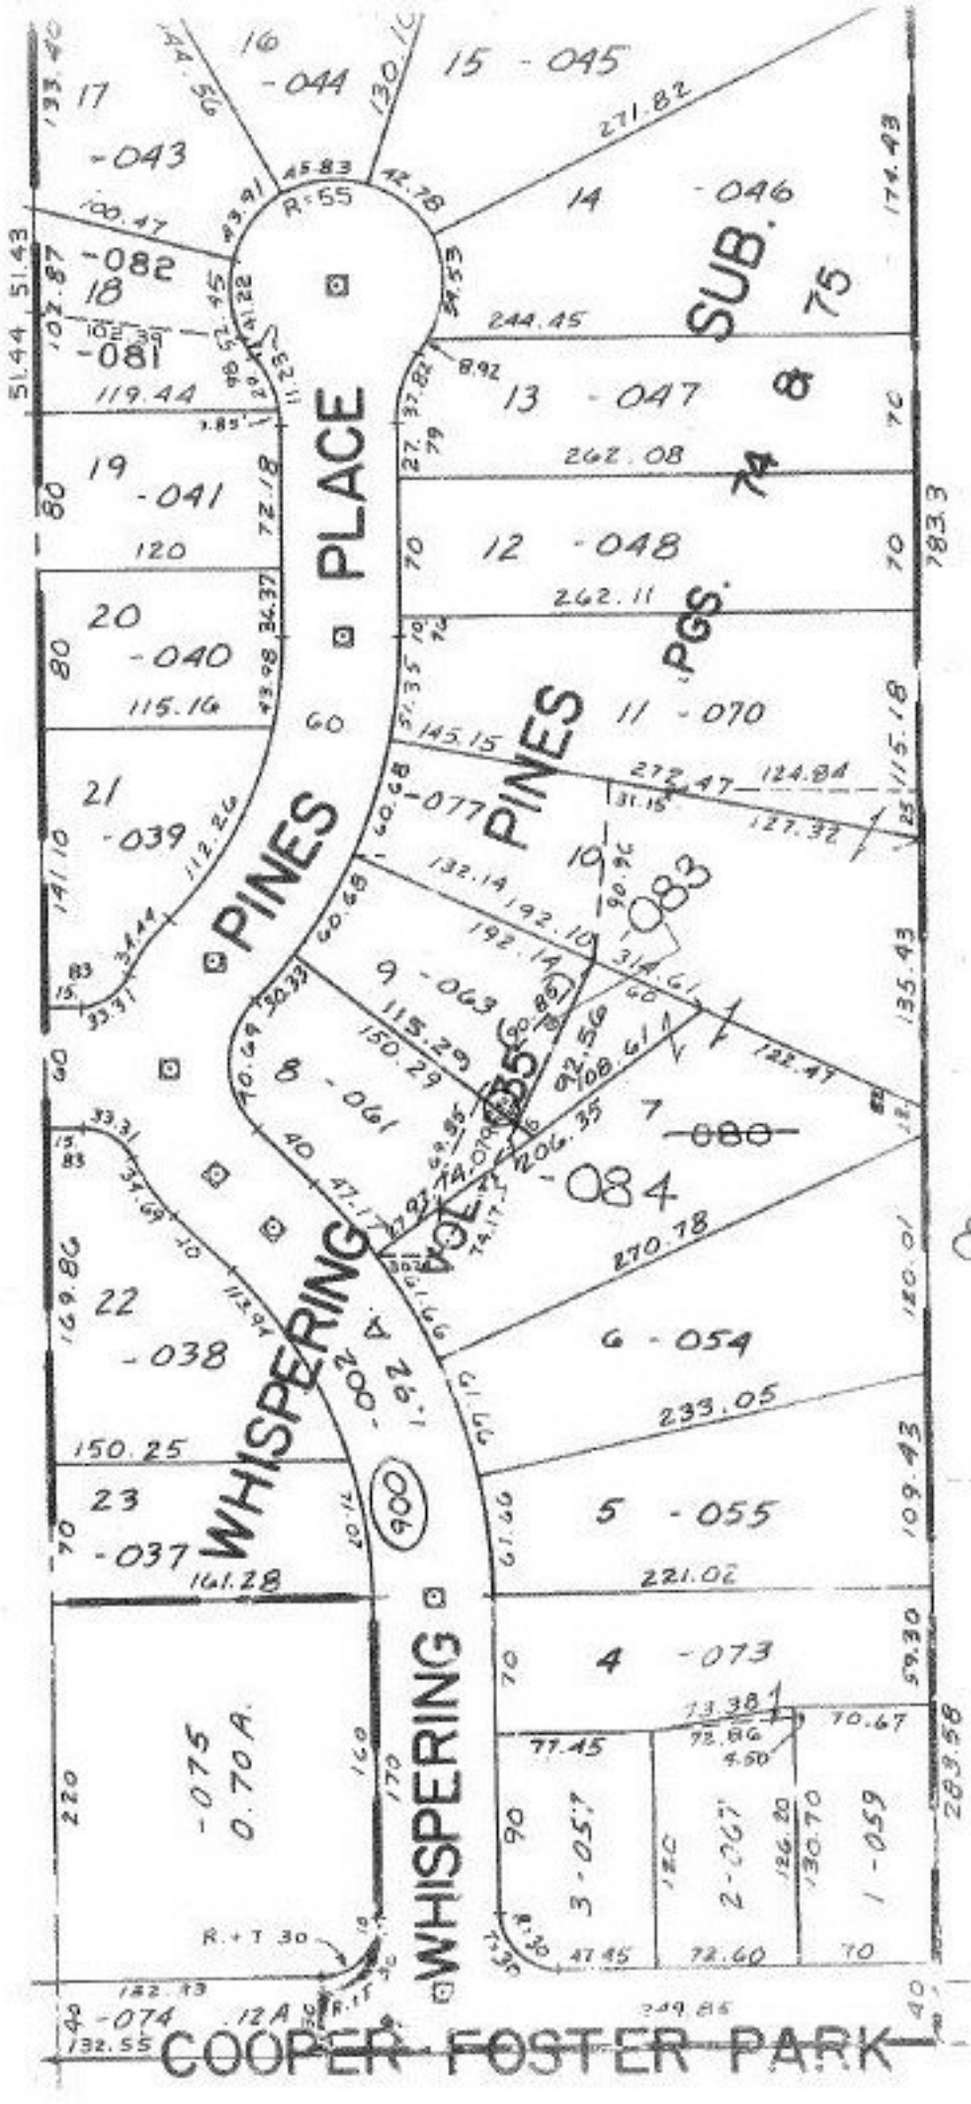
SUB. 75
PINES PLACE
PINES PGS.
WHISPERING
WHISPERING
COOPER FOSTER PARK
SEE 5
02-01-003-263- PRIOR INST. 1383/750
SURVEYED BY: KS ASSOC. C=1: 250,000
4/22/91
#19295
APPROVED
LORAIN CO.
MAP DEPT.
DATE 2-28-91
PAGE 2-01-003M
BY CAROLYN
VOID AFTER # 19295