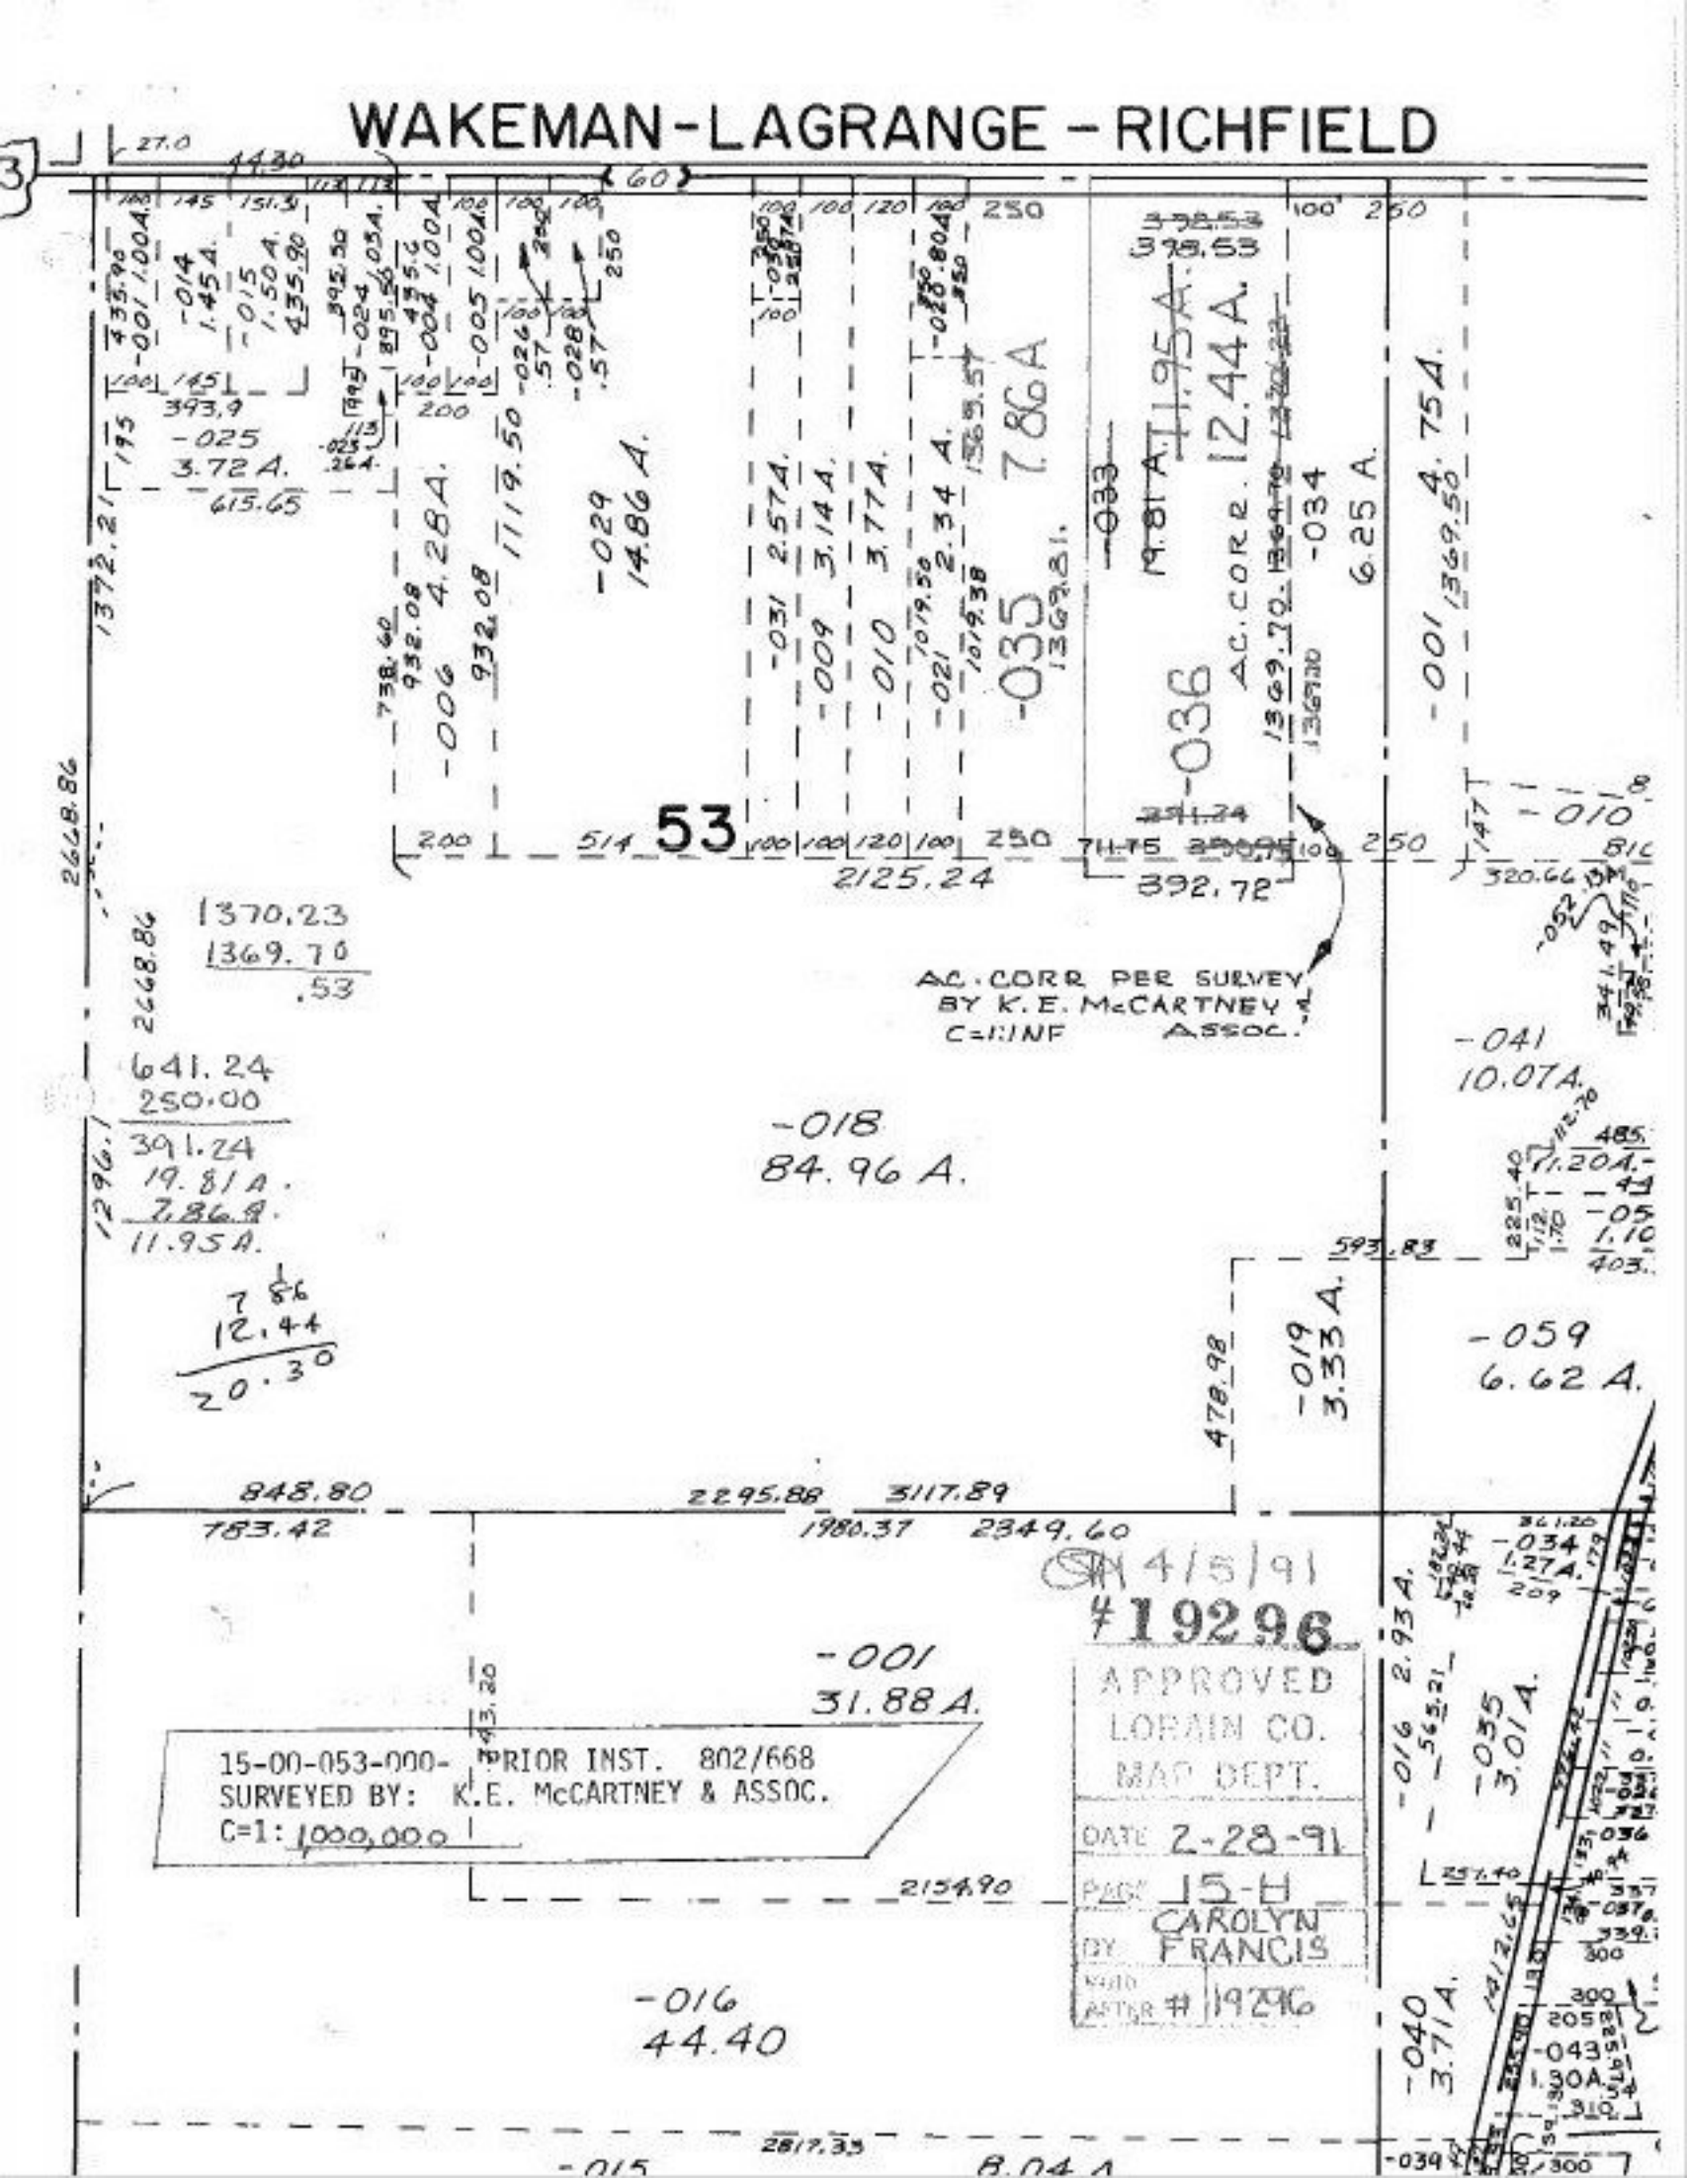
WAKEMAN-LAGRANGE-RICHFIELD
53
-001 435.90
-014 1.45A.
-015 1.50A. 435.90
-025 3.72A. 615.65
-006 4.28A.
-029 14.86A.
-031 2.57A.
-009 3.14A.
-010 3.77A.
-021 2.34A.
-035 7.86A
-033
-036
19.81A. 11.95A.
12.44A.
-034 6.25A.
-001 4.75A.
-010
-041 10.07A.
-018 84.96A.
-019 3.33A.
-059 6.62A.
-001 31.88A.
-016 44.40
-016 2.93A.
-035 3.01A.
-040 3.71A.
-043 1.30A.
AC. CORR PER SURVEY BY K.E. McCARTNEY & ASSOC.
15-00-053-000- PRIOR INST. 802/668
SURVEYED BY: K.E. McCARTNEY & ASSOC.
C=1: 1,000,000
4/5/91
#19296
APPROVED
LORAIN CO.
MAP DEPT.
DATE 2-28-91
PAGE 15-H
BY CAROLYN FRANCIS
ADD AFTER # 19296