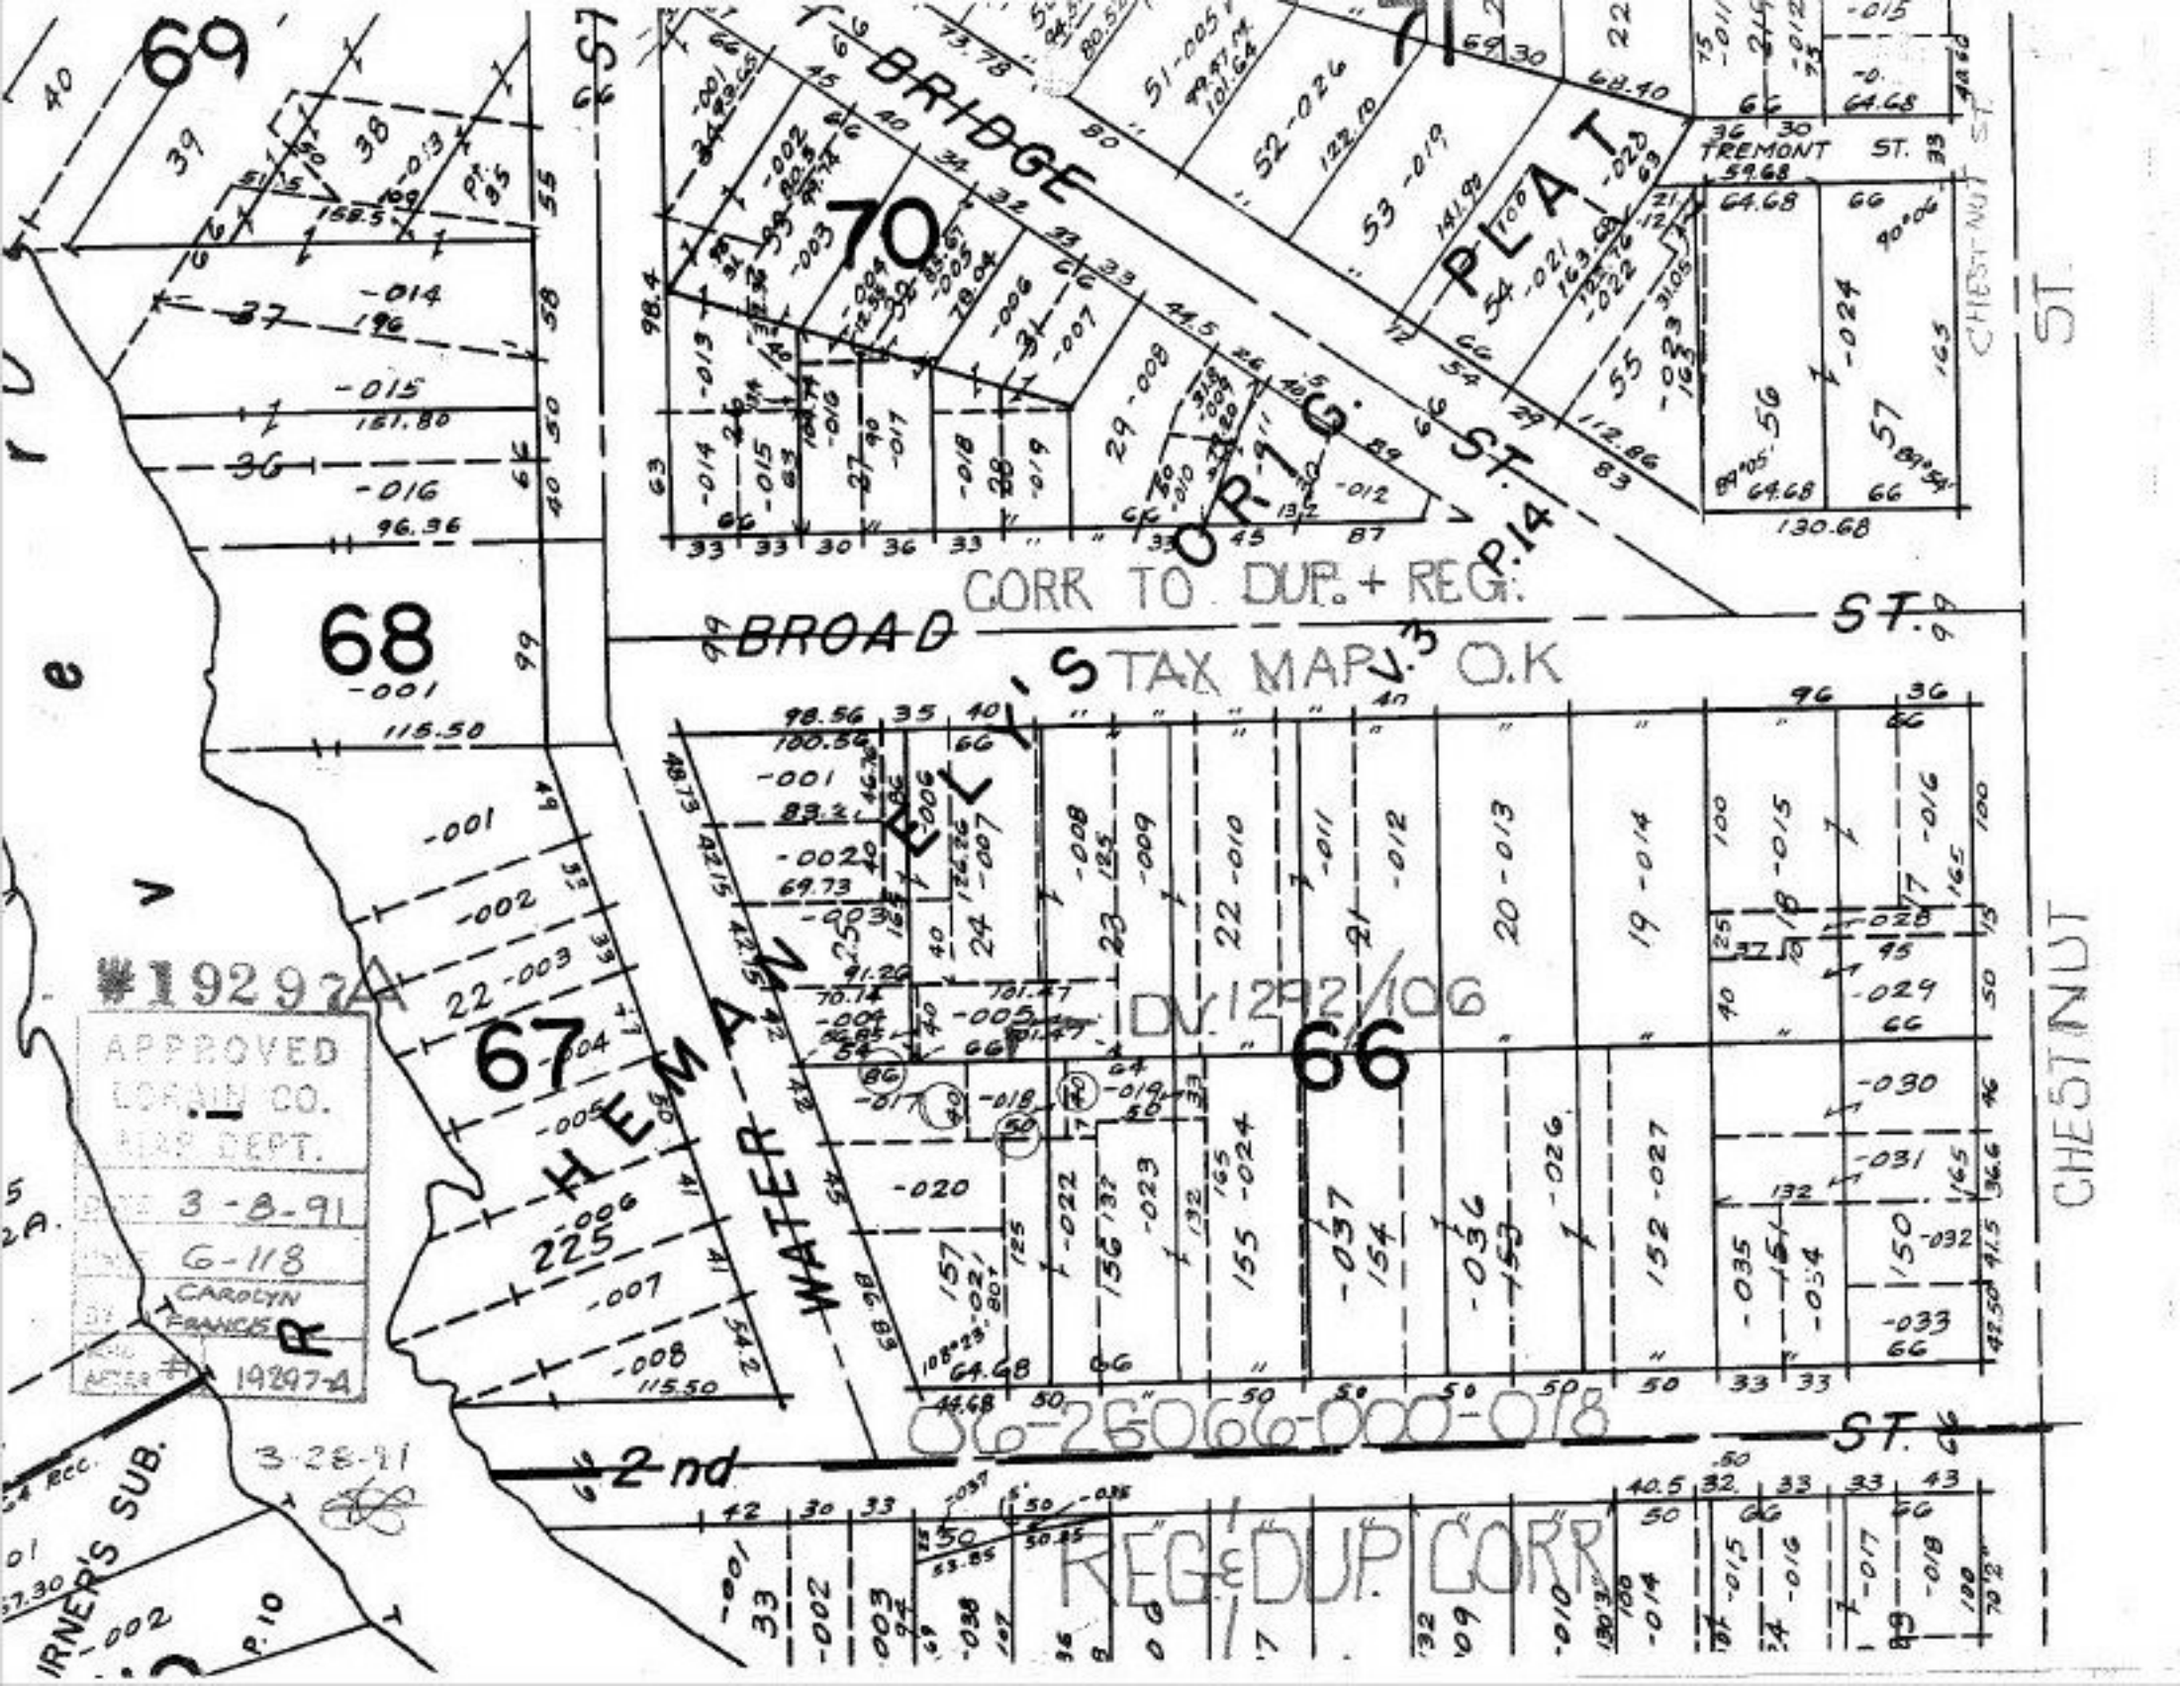
69
70
68
67
66
BRIDGE ST.
ORIG. PLAT
BROAD ST.
CHESTNUT ST.
FREMONT ST.
WATER ST.
2nd ST.
CORR TO DUP. + REG.
TAX MAP O.K
DV. 12P2/106
#19297-A
APPROVED
LORAIN CO.
MAP DEPT.
3-8-91
G-118
CAROLYN FRANCIS
3-28-91
06-25066-000-018
REG & DUP CORR
IRNER'S SUB.