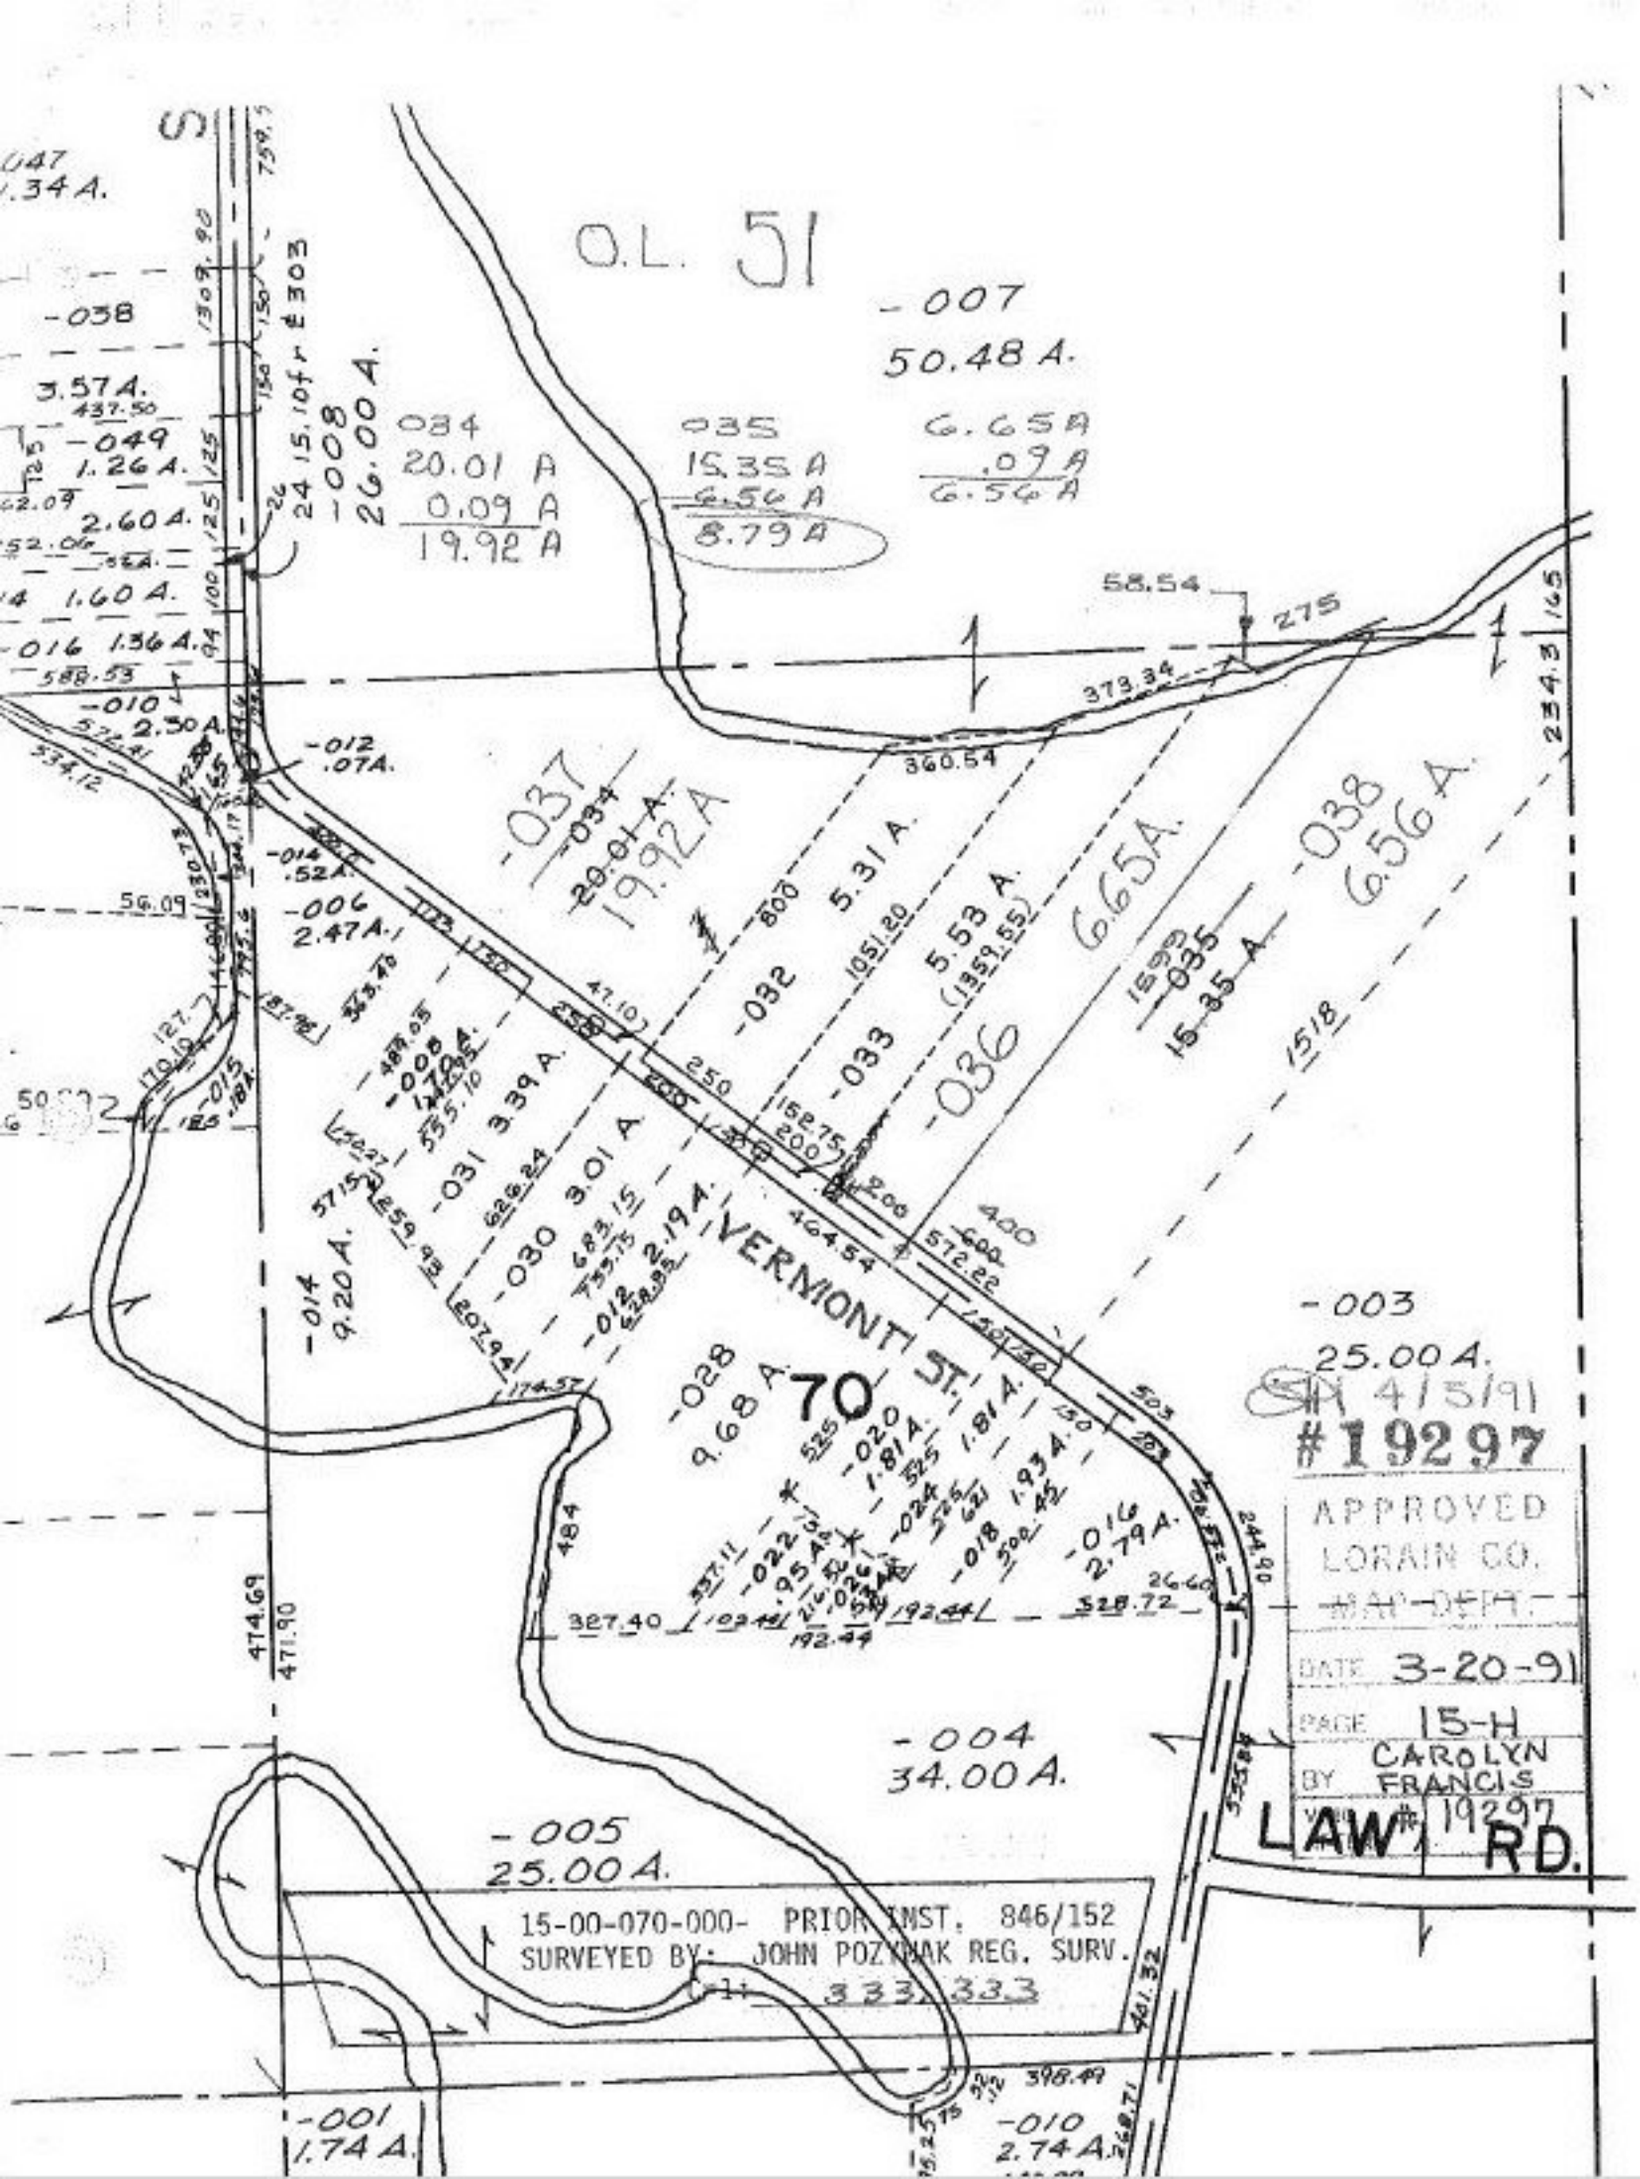
O.L. 51
-007
50.48 A.
084
20.01 A
0.09 A
19.92 A
035
15.35 A
6.56 A
8.79 A
6.65A
.09A
6.56 A
-008
26.00 A.
-038
3.57A.
-049
1.26 A.
2.60 A.
1.60 A.
-016 1.36 A.
-010
2.30 A.
-012
.07A.
-037
-034
20.01 A.
19.92A
5.31 A.
-032
5.53 A.
(1359.55)
-033
-036
6.65A.
-038
6.56A.
15.35 A
-035
-006
2.47 A.
-014
.52A.
-008
17.04 A.
-031 3.39 A.
-030 3.01 A
-012
2.19 A.
-014
9.20 A.
-015
.18A.
VERMONT ST.
70
-028
9.68 A.
-020
1.81 A.
-024
-022
.95 A.
-018 1.93 A.
-016
2.79 A.
-003
25.00 A.
-004
34.00 A.
-005
25.00 A.
-001
1.74 A.
-010
2.74 A.
LAW RD.
58.54
275
373.34
360.54
234.3
165
1518
1599
APPROVED
LORAIN CO.
MAP DEPT.
DATE 3-20-91
PAGE 15-H
BY CAROLYN FRANCIS
VOL # 19297
4/5/91
#19297
15-00-070-000- PRIOR INST. 846/152
SURVEYED BY: JOHN POZYMAK REG. SURV.
333.333