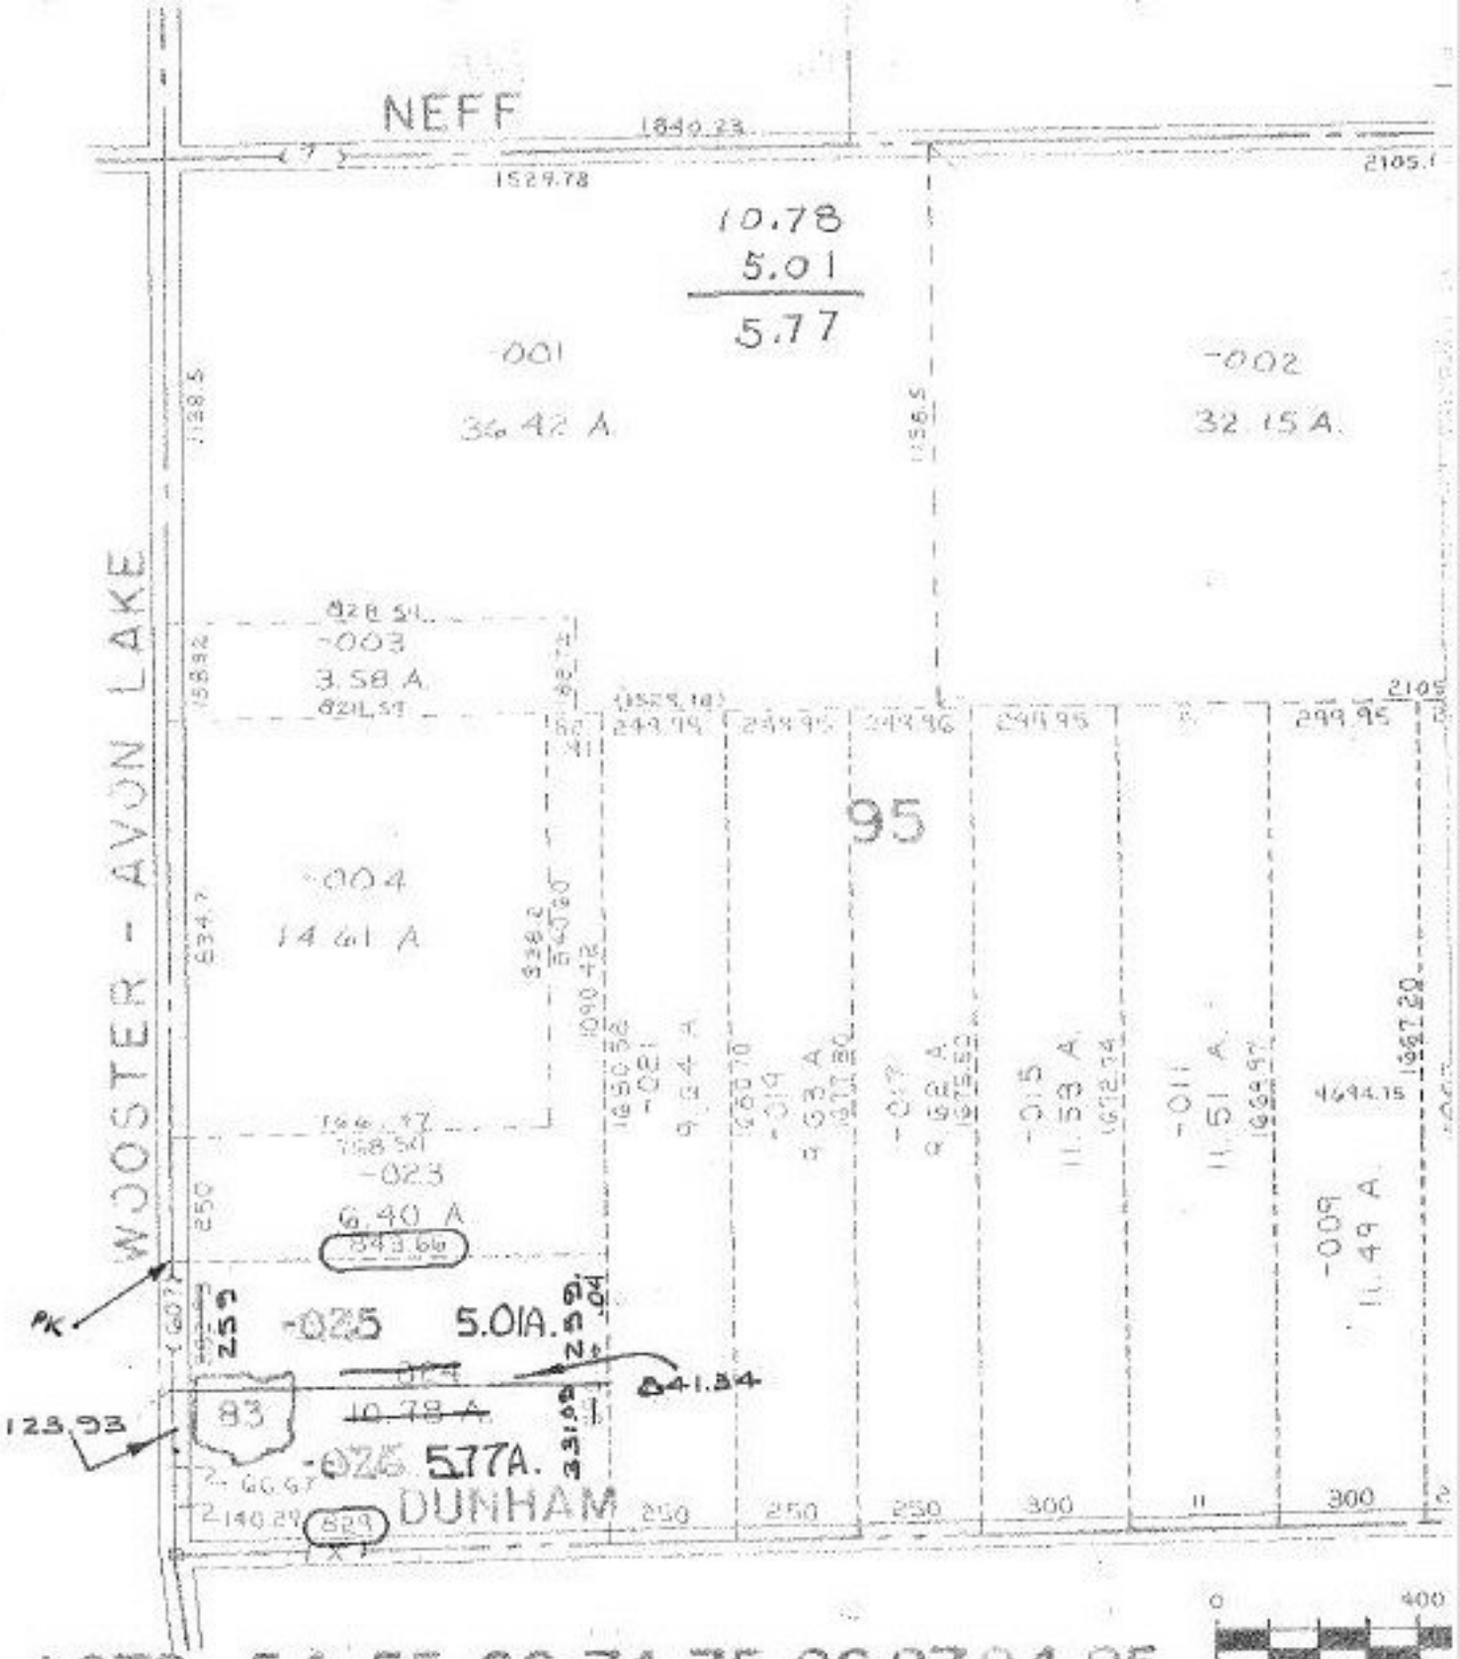

LOTS 54, 55, 66, 74, 75, 86, 87, 94, 95

SN 3/29/91 #19298

16-00-095-000- PRIOR INST. 1360/989

SURVEYED BY: JOHN POZYWAK REG. SURV.

C=1: 200,000.

APPROVED
LORAIN CO.
MAP DEPT.

DATE 3-4-91

PAGE 16-G

BY CAROLYN FRANCIS

VOID AFTER * 19298