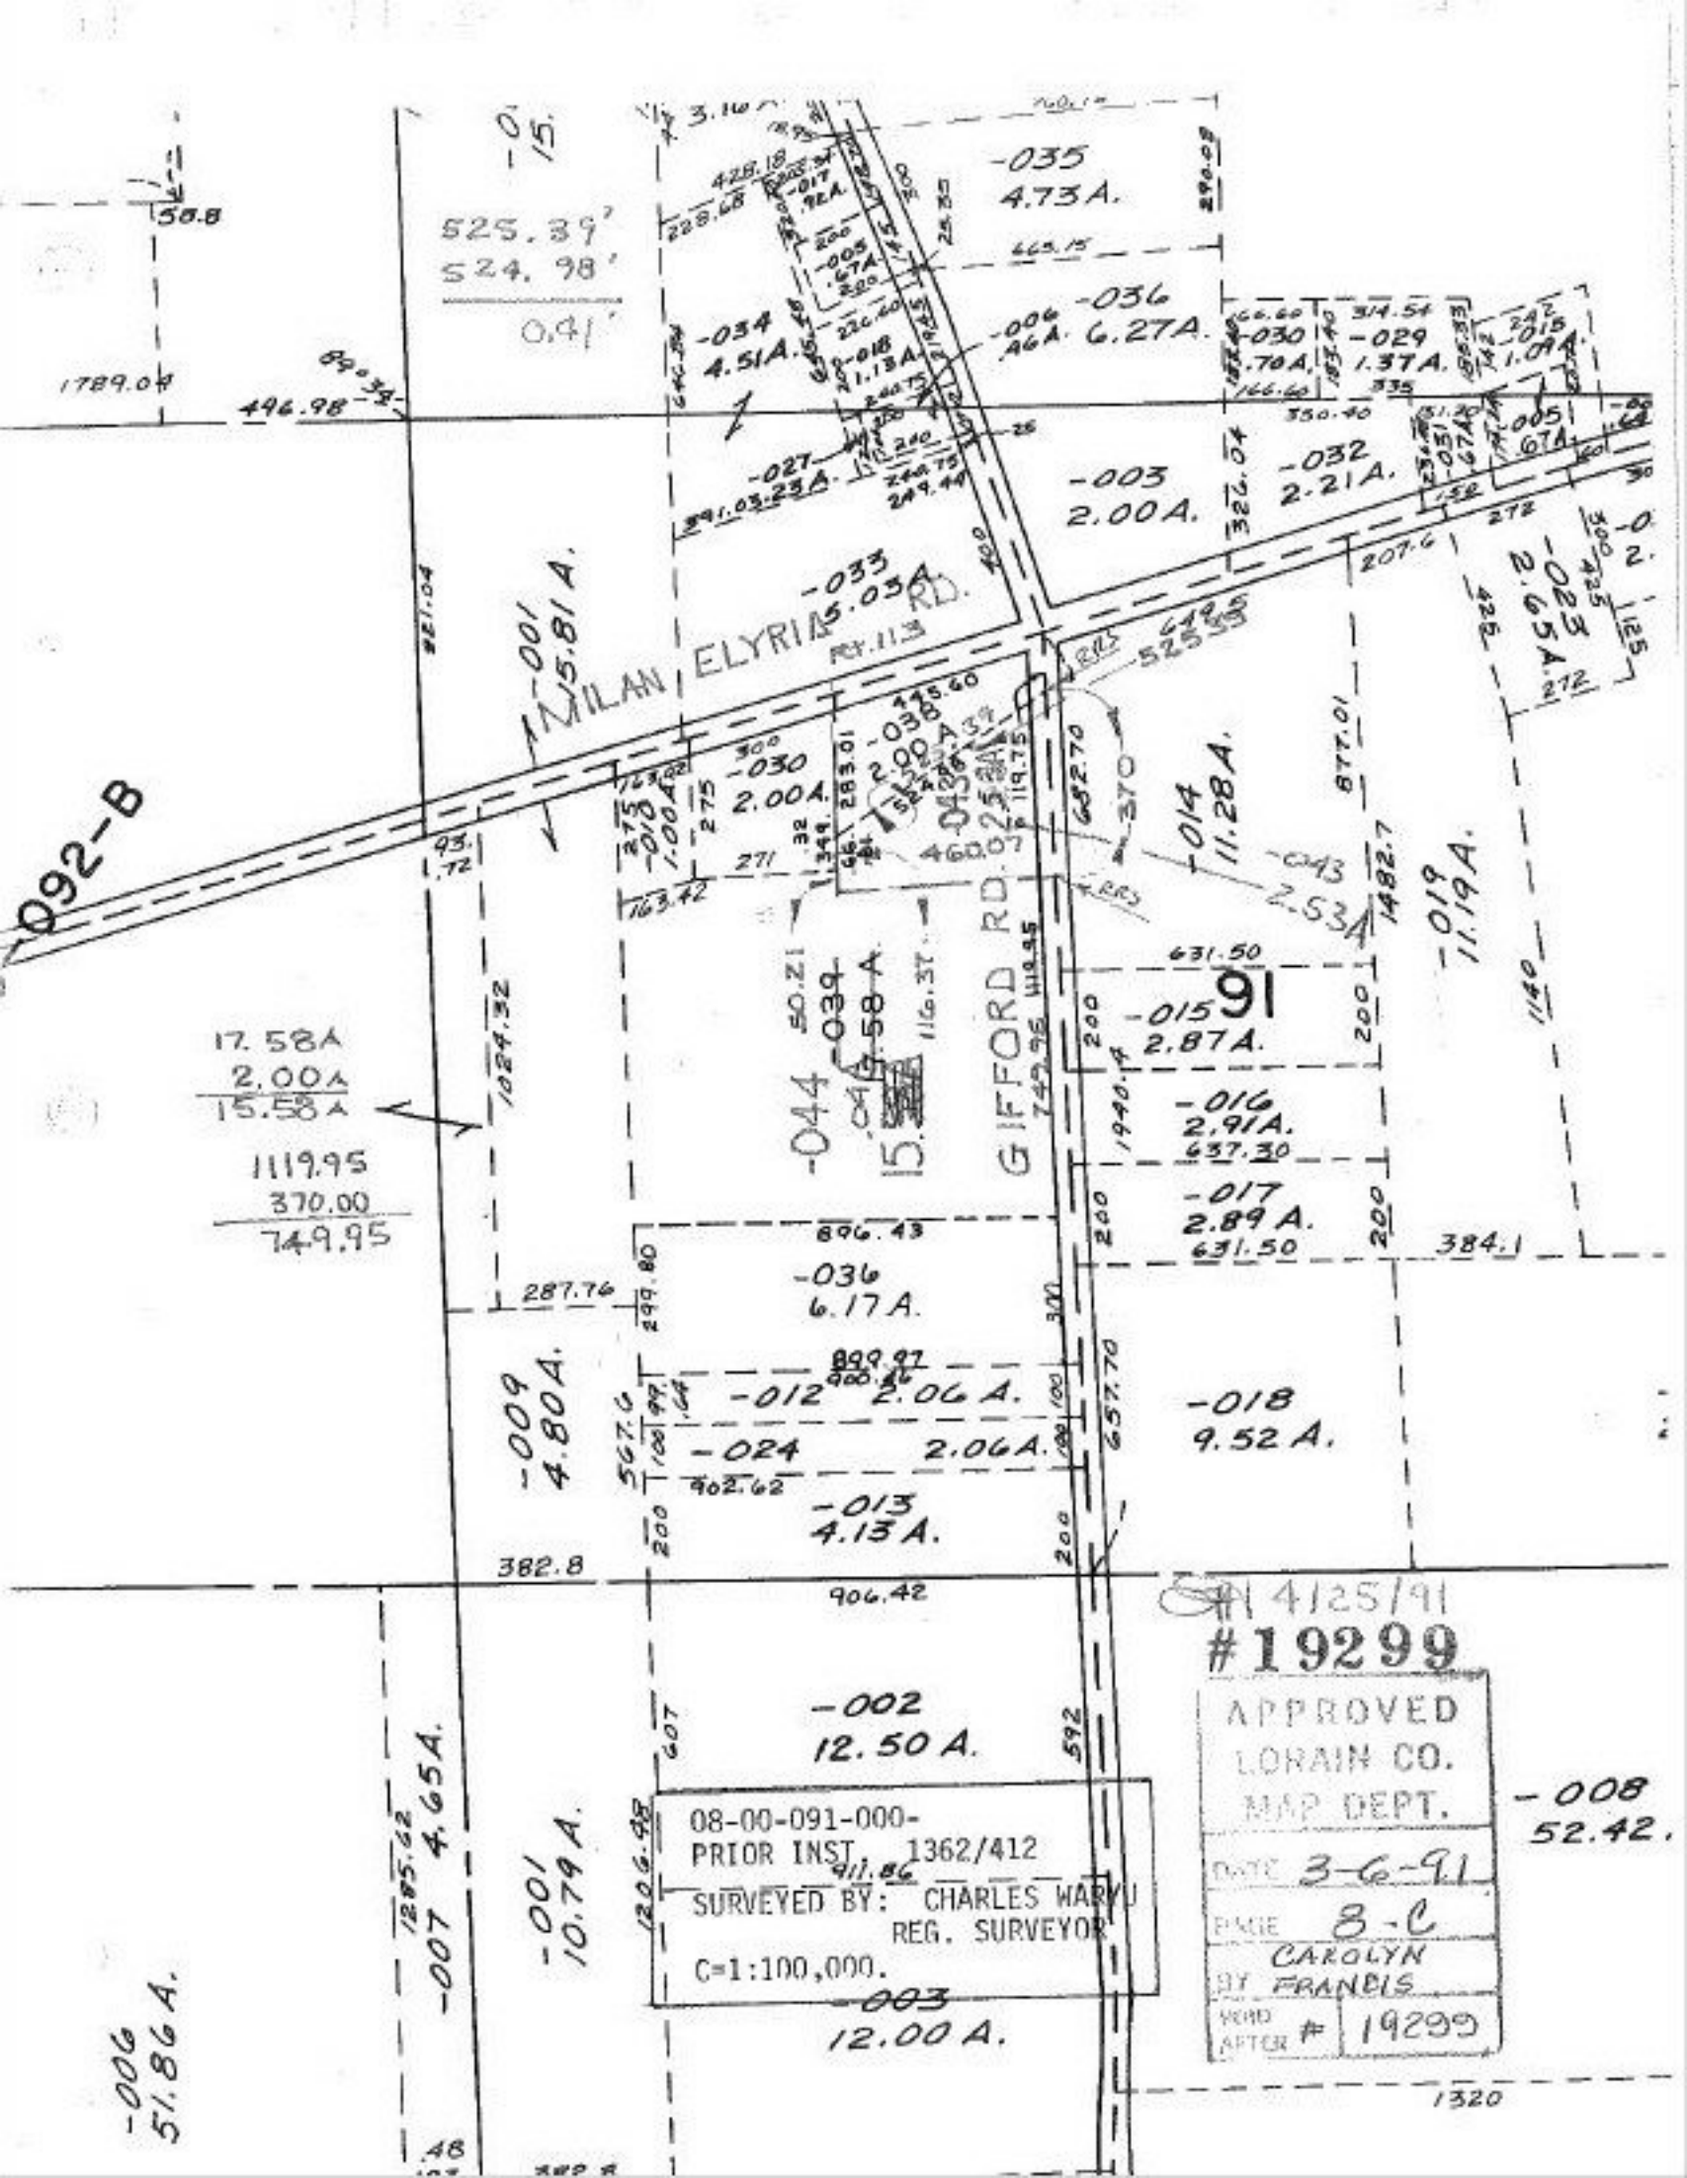
525.39'
524.98'
0.41'
-035
4.73A.
-036
6.27A.
-034
4.51A.
-030
.70A.
-029
1.37A.
-027
-003
2.00A.
-032
2.21A.
-033
5.03A.
-001
15.81A.
MILAN - ELYRIA RD.
PCT. 11.3
-030
2.00A.
-038
2.00A.
-043
2.53A.
-014
11.28A.
-023
2.65A.
-019
11.19A.
GIFFORD RD.
-044
15.58A.
-039
-015
2.87A.
91
-016
2.91A.
-017
2.89A.
-036
6.17A.
-009
4.80A.
-012
2.06A.
-024
2.06A.
-013
4.13A.
-018
9.52A.
-002
12.50A.
-001
10.79A.
-007
4.65A.
-003
12.00A.
-008
52.42.
-006
51.86A.
17.58A
2.00A
15.58A
1119.95
370.00
749.95
08-00-091-000-
PRIOR INST. 1362/412
9.11.86
SURVEYED BY: CHARLES WARYU
REG. SURVEYOR
C=1:100,000.
4/25/91
#19299
APPROVED
LORAIN CO.
MAP DEPT.
DATE 3-6-91
BY MIE 8-C
CAROLYN
FRANCIS
VOID AFTER # 19299