


-009
1.16 A.



90 0 LRD.

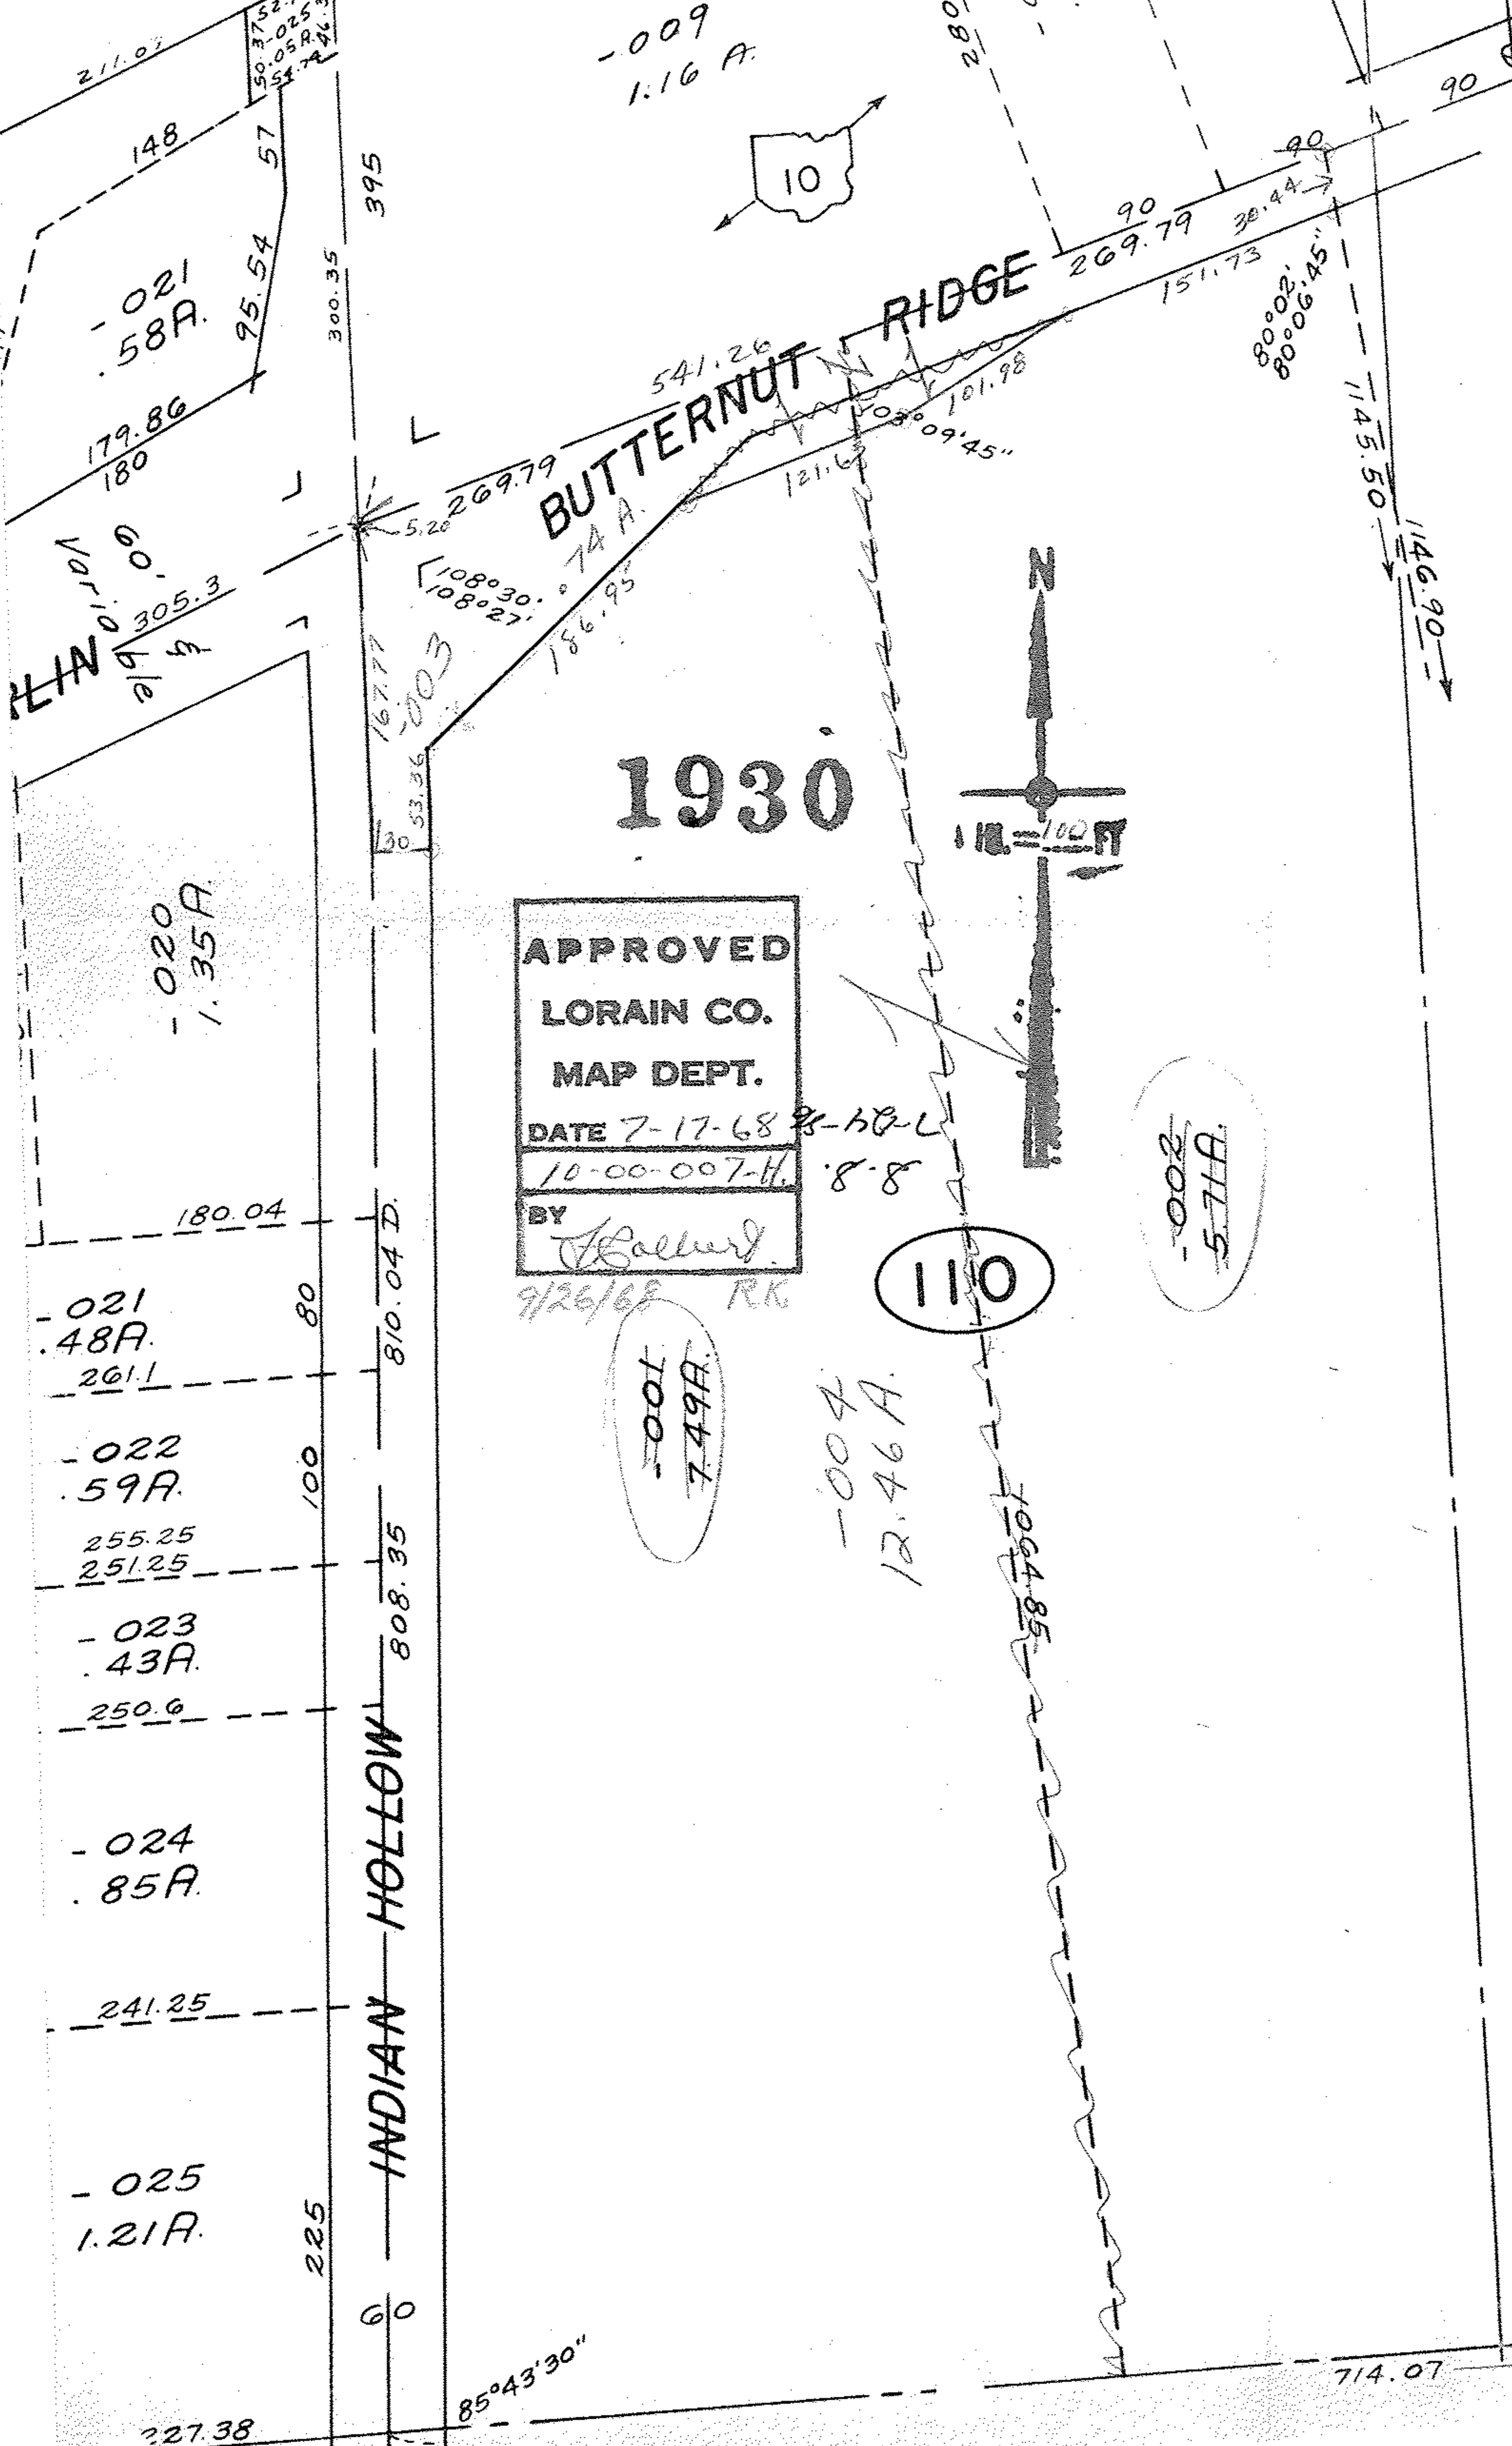

1930

APPROVED
LORAIN CO.
MAP DEPT.
DATE 7-17-68 *95-150-L*
10-00-007-H. *8-8*
BY *Ballard*

9/26/68 RK

110

-002
5.71A.

-001
7.49A.

-004
12.46A.

SEE 10-00-014-D