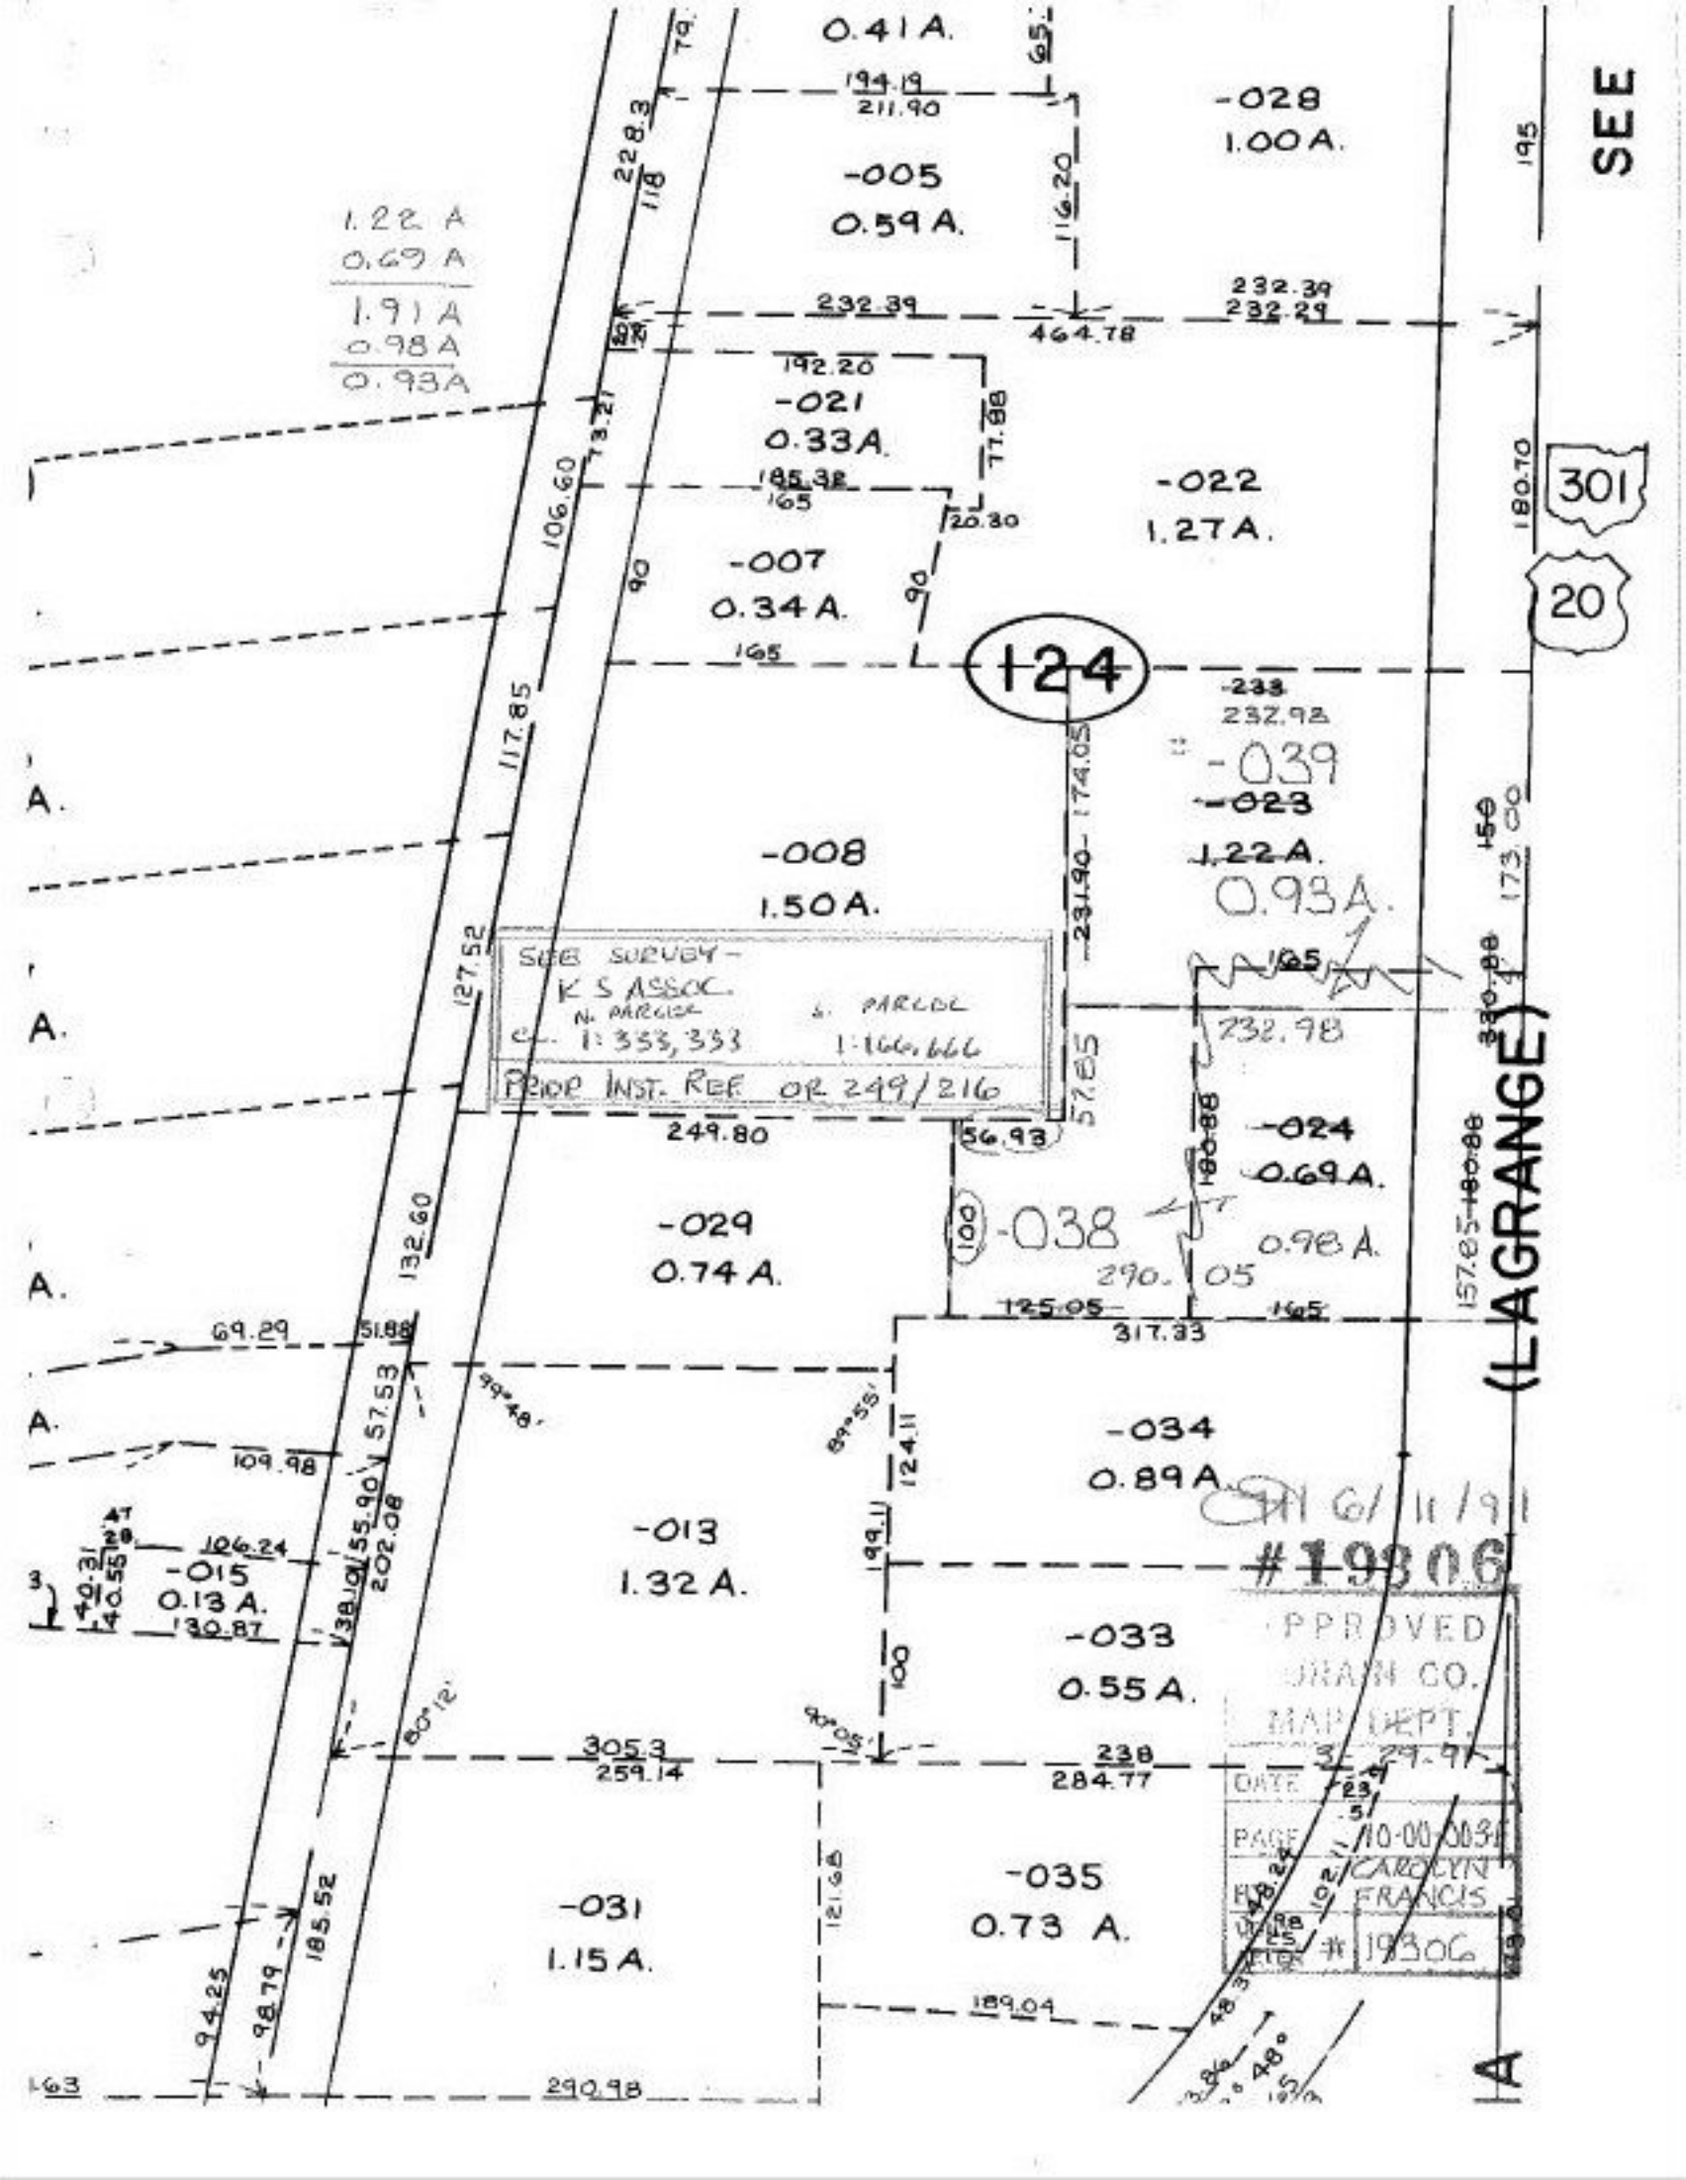
SEE
0.41 A.
-028
1.00 A.
-005
0.59 A.
1.22 A
0.69 A
1.91 A
0.98 A
0.93 A
-021
0.33 A.
-022
1.27 A.
-007
0.34 A.
124
-039
-023
1.22 A.
0.93 A.
-008
1.50 A.
SEE SURVEY - K S ASSOC.
N. PARCEL
E. PARCEL
1:353,353
1:166,666
PRIOR INST. REF. OR 249/216
-024
0.69 A.
-029
0.74 A.
-038
0.98 A.
-034
0.89 A
-013
1.32 A.
-033
0.55 A.
-015
0.13 A.
-031
1.15 A.
-035
0.73 A.
301
20
(LAGRANGE)
#19306
APPROVED
URAN CO.
MAP DEPT.
CAROLYN
FRANCIS