THIS PARCEL IS BEING ADDED TO DUPLICATE, AS IT WAS A REMAINDER OF SPLIT #18561, TRANS, SHEET # 14, DATED 8-7-89, BUT WAS NEVER SHOWN ON THE MAP. ACREAGE WAS REDUCED TO 0.00 A. BUT IS BEING RESTORED TO. 0.56 ACREAS. PER CALCULATION OF MAP DEPARTMENT. ~~PARCEL WAS DELETED WHEN 100 = 1 PAGES 8-00-014 -C & 7-00-013 -A were drawn.~~ REFERENCE DV. 1301/599

SEE 7-0

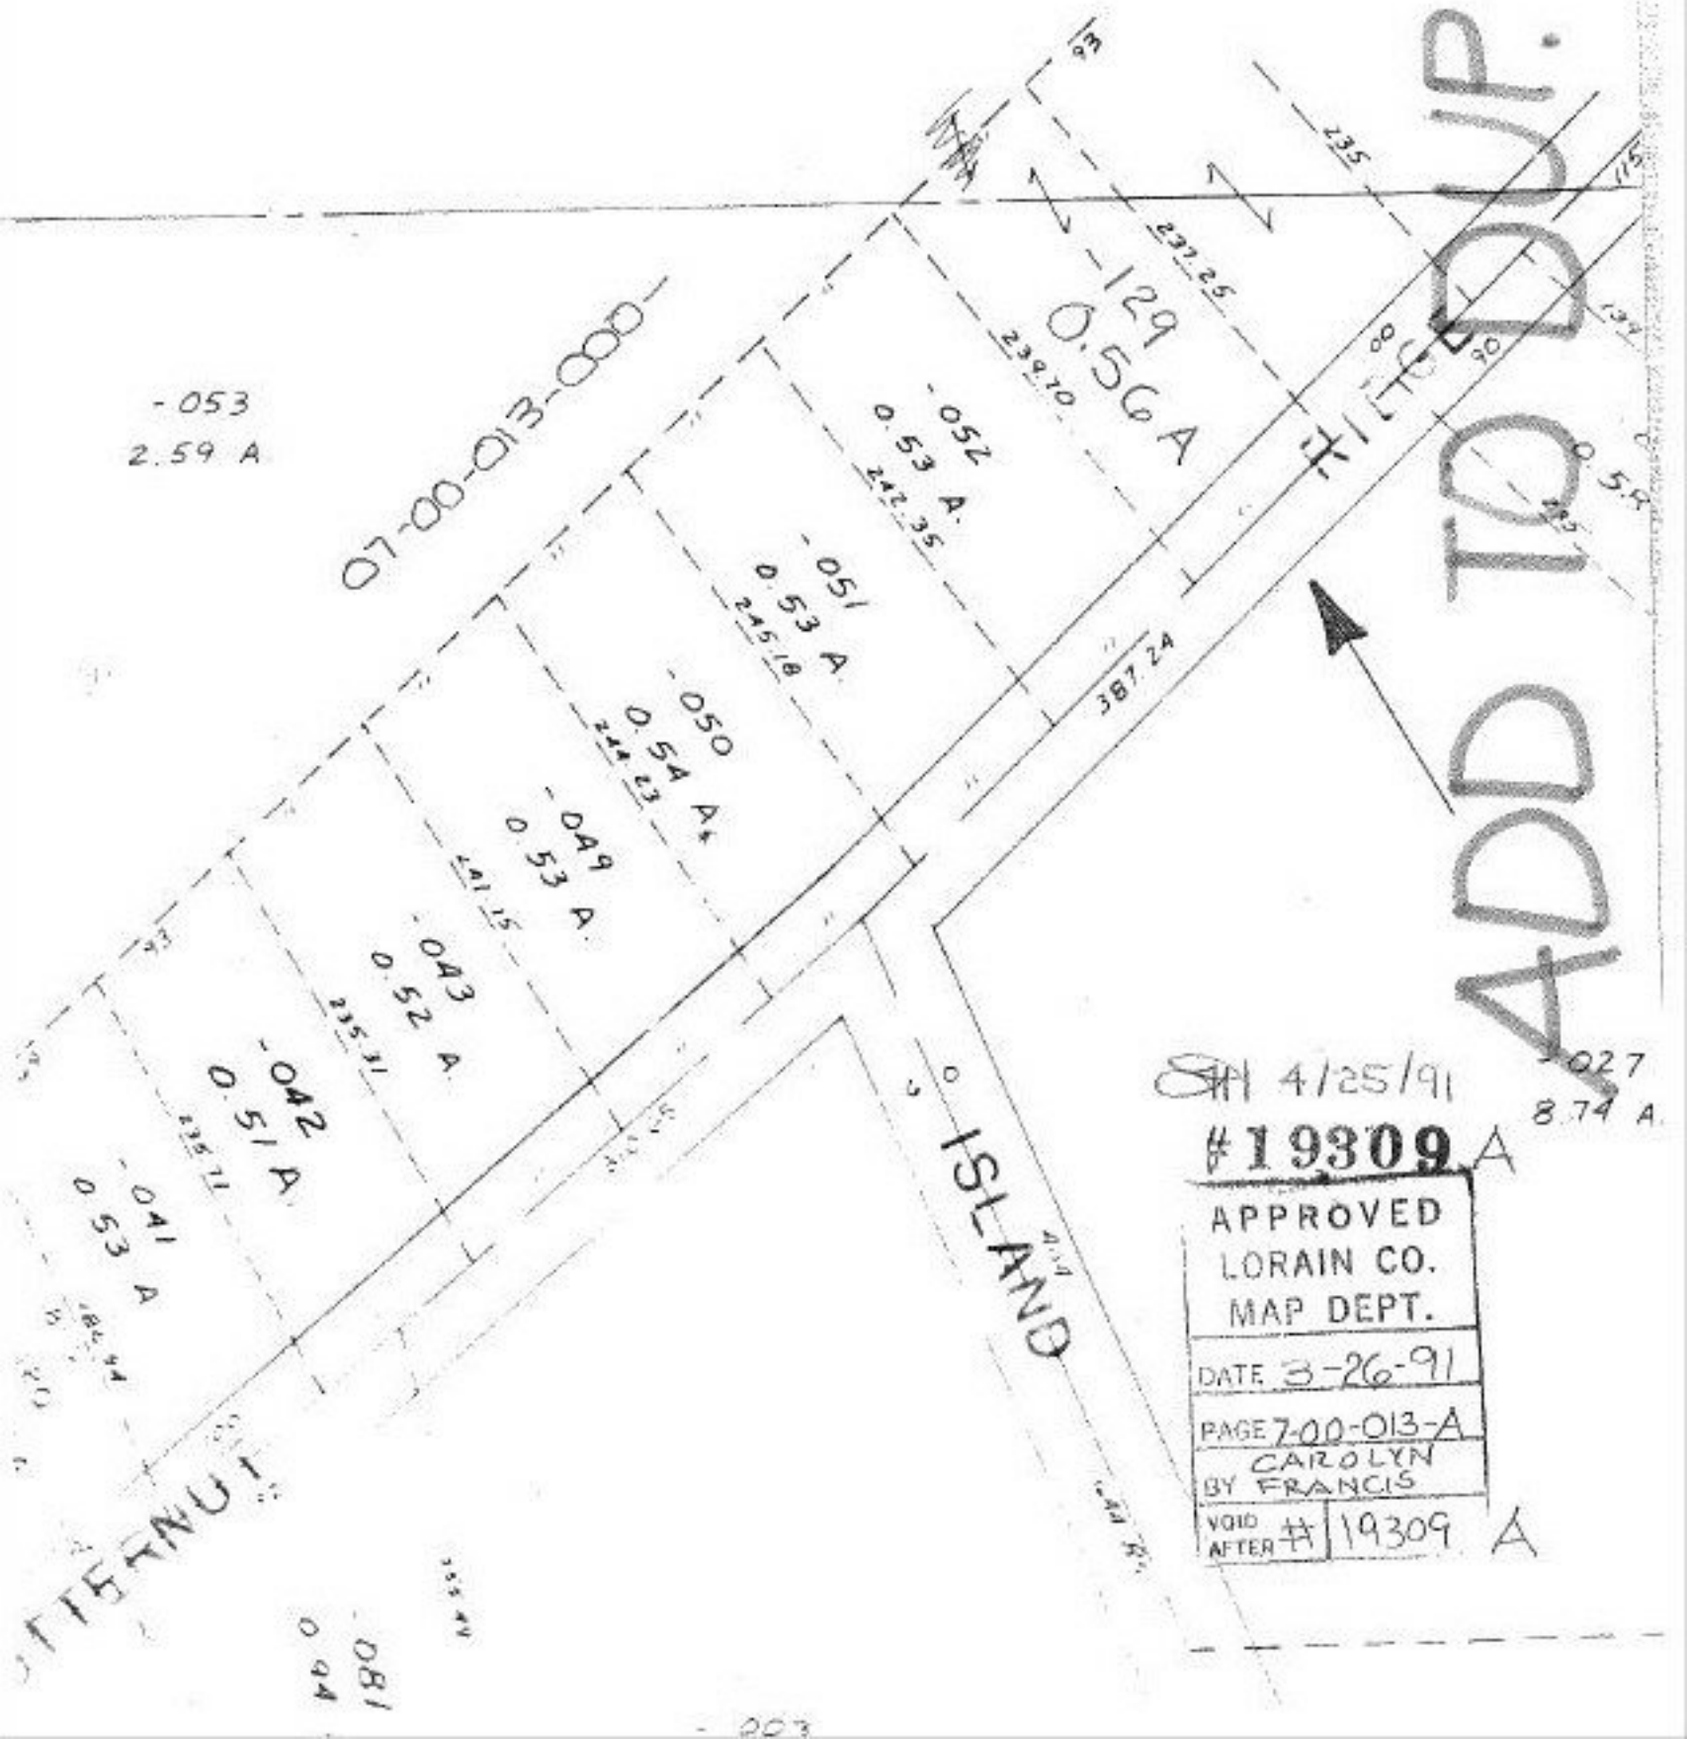

SH 4/25/91

#19309 A

APPROVED
LORAIN CO.
MAP DEPT.

DATE 3-26-91

PAGE 7-00-013-A

BY CAROLYN FRANCIS

VOID AFTER # 19309 A