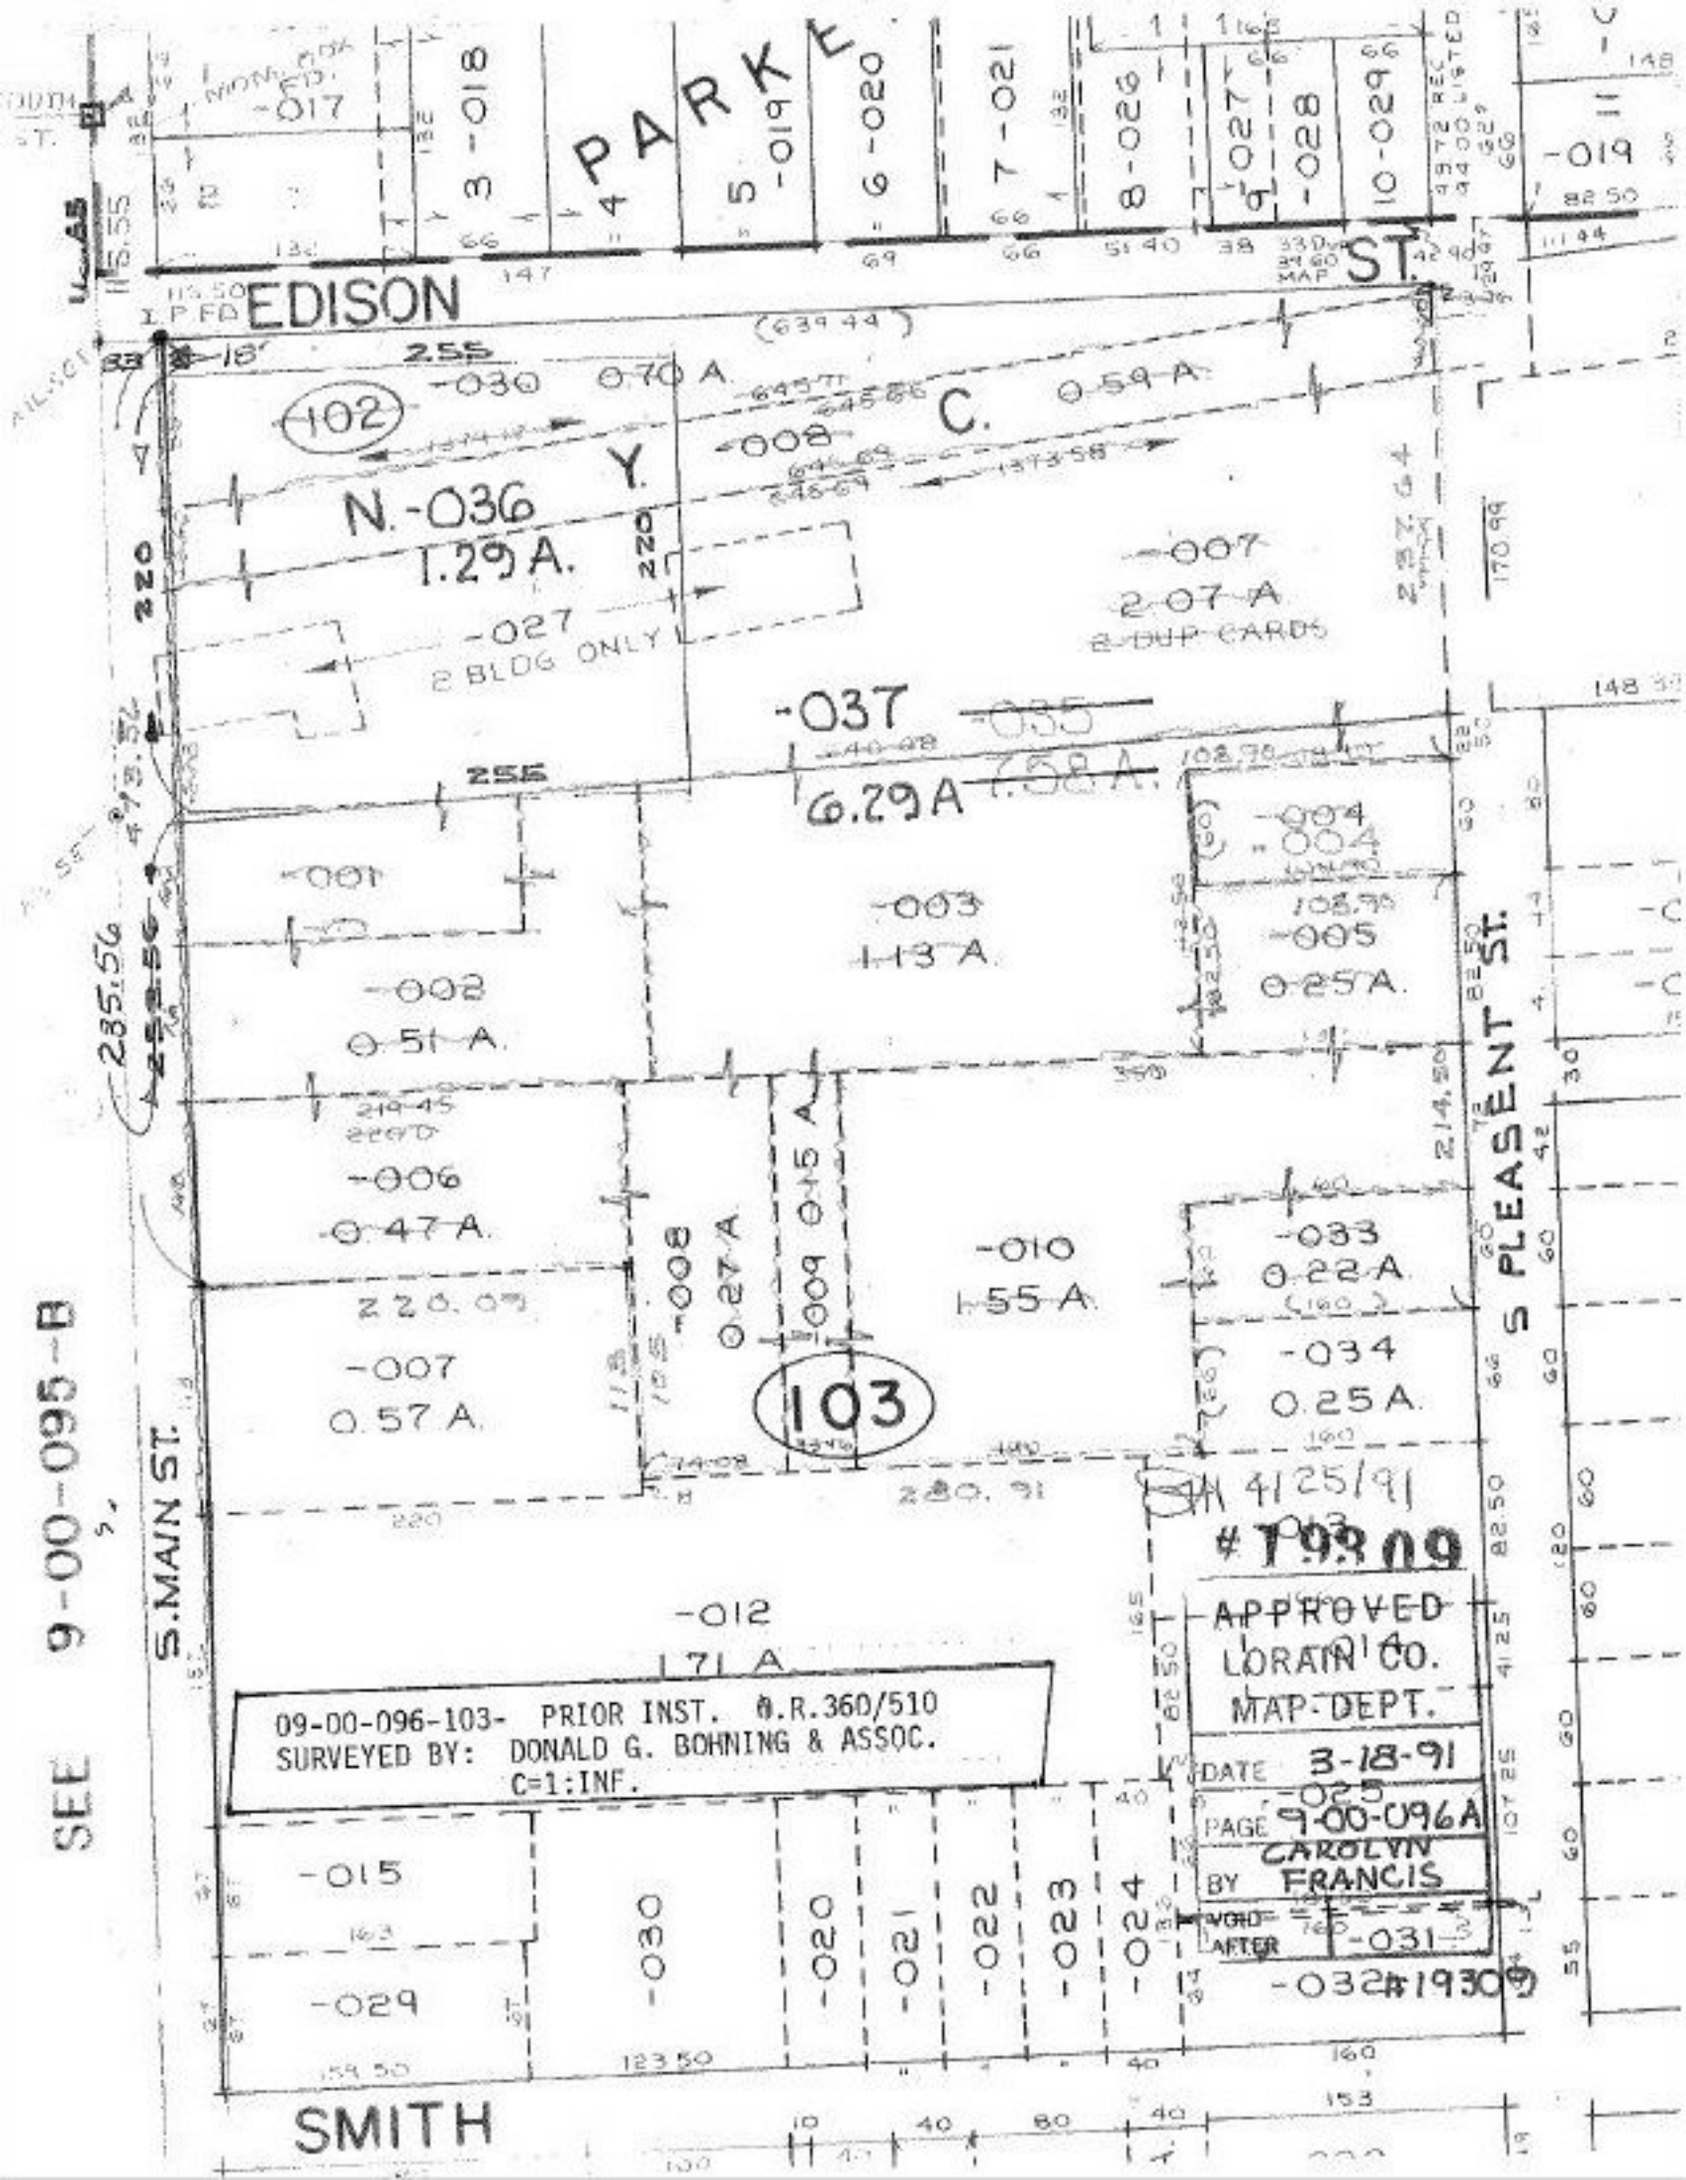
EDISON
PARK
ST.
S. MAIN ST.
S PLEASANT ST.
SMITH
-017
-018
-019
-020
-021
-026
-027
-028
-029
-030
-008
-007
-037
-035
-004
-005
-001
-003
-002
-006
-009
-010
-033
-034
-012
-015
-022
-023
-024
-025
-031
-032
102
103
N.-036
1.29 A.
0.70 A.
0.59 A.
2.07 A
2 DUP CARDS
2 BLDG ONLY
6.29 A
1.58 A.
0.25 A.
1.13 A.
0.51 A.
0.47 A.
0.27 A.
0.15 A.
1.55 A.
0.22 A.
0.25 A.
0.57 A.
1.71 A.
09-00-096-103- PRIOR INST. O.R.360/510
SURVEYED BY: DONALD G. BOHNING & ASSOC.
C=1:INF.
APPROVED
LORAIN CO.
MAP DEPT.
DATE 3-18-91
PAGE 9-00-096A
BY CAROLYN FRANCIS
VOID AFTER
DM 4/25/91
#19309
#19309
SEE 9-00-095-B