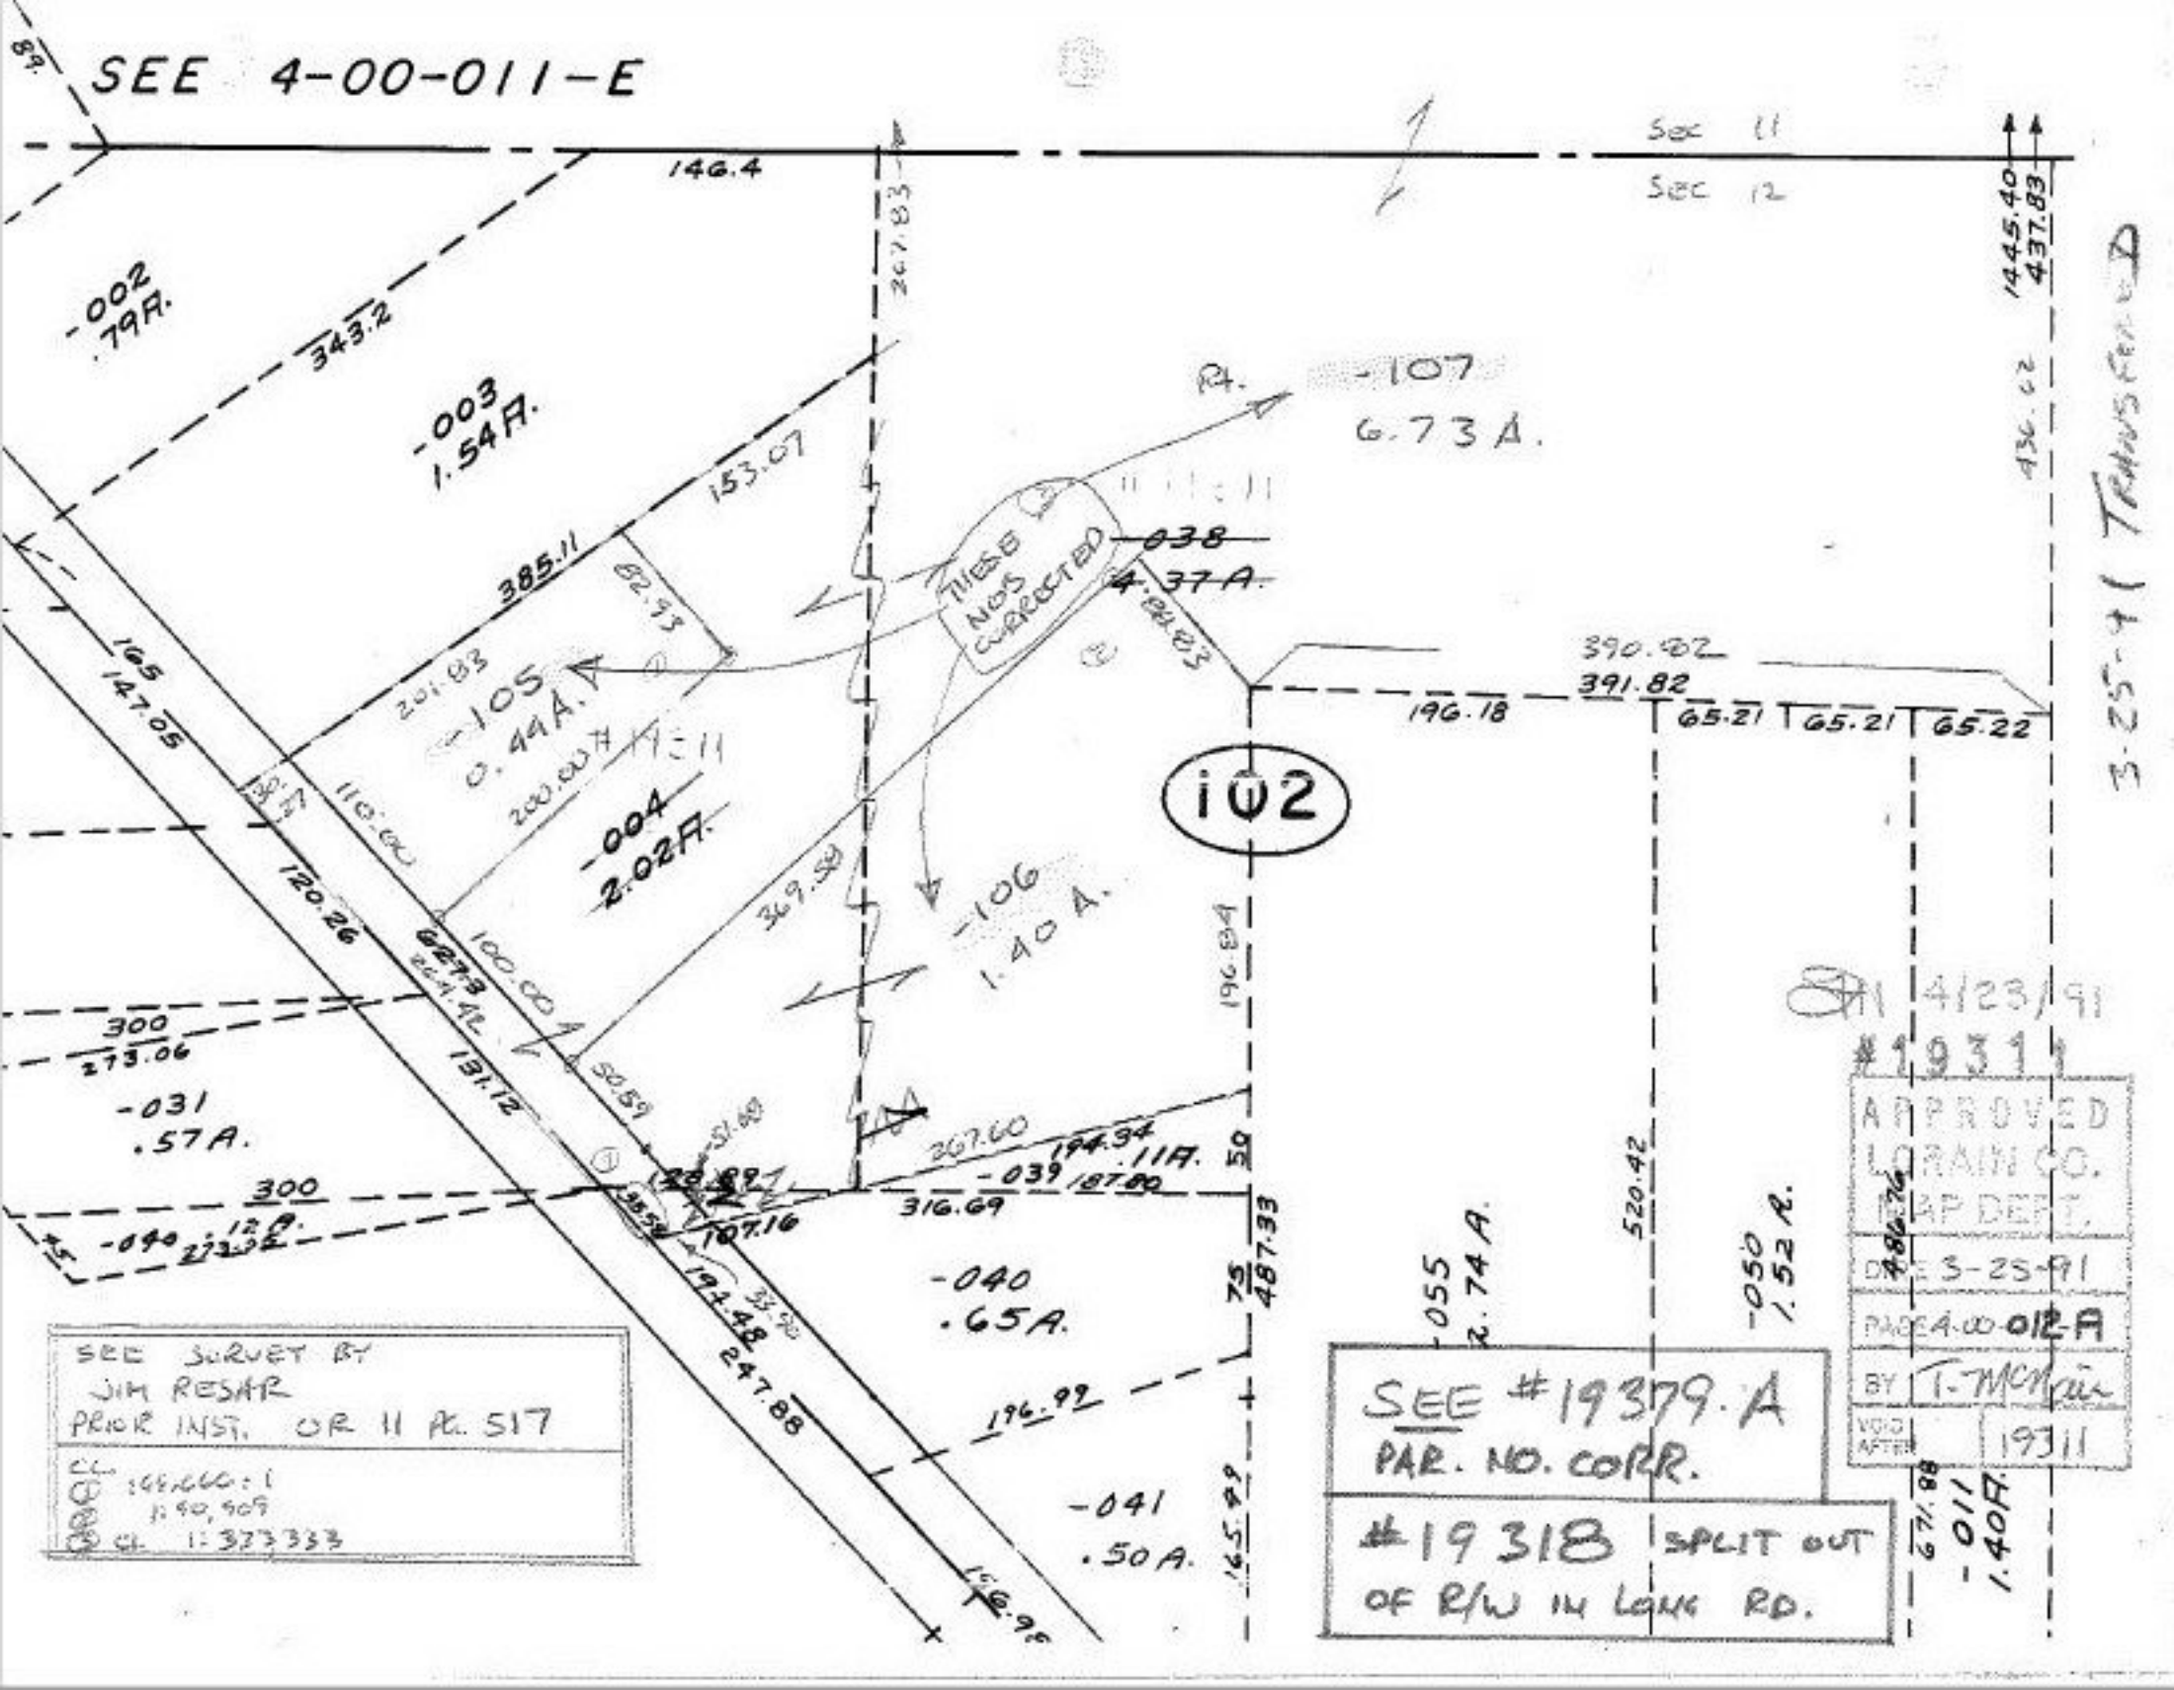
SEE 4-00-011-E
Sec 11
Sec 12
146.4
-002
.79A.
343.2
-003
1.54A.
153.07
385.11
-105
0.44A.
-004
2.02A.
-107
6.73A.
-038
4.37A.
TIES NOT CORRECTED
390.82
391.82
196.18
65.21
65.21
65.22
i02
-106
1.40A.
369.58
196.84
-039
1.11A.
207.60
194.94
316.69
-040
.65A.
-041
.50A.
-055
2.74A.
-050
1.52A.
-011
1.40A.
520.42
487.33
247.88
196.92
165.99
147.05
120.26
131.12
100.00
110.00
273.06
300
-031
.57A.
-040
2.12A.
SEE SURVEY BY
JIM RESAR
PRIOR INST. OR 11 Pg. 517
SEE #19379.A
PAR. NO. CORR.
#19318 SPLIT OUT
OF R/W IN LONG RD.
4/23/91
#1931
APPROVED
LORAIN CO.
MAP DEPT.
DATE 3-25-91
PAGE 4-00-012-A
BY T. McMain
VOID AFTER 1931
3.25-91 TRANSFERRED