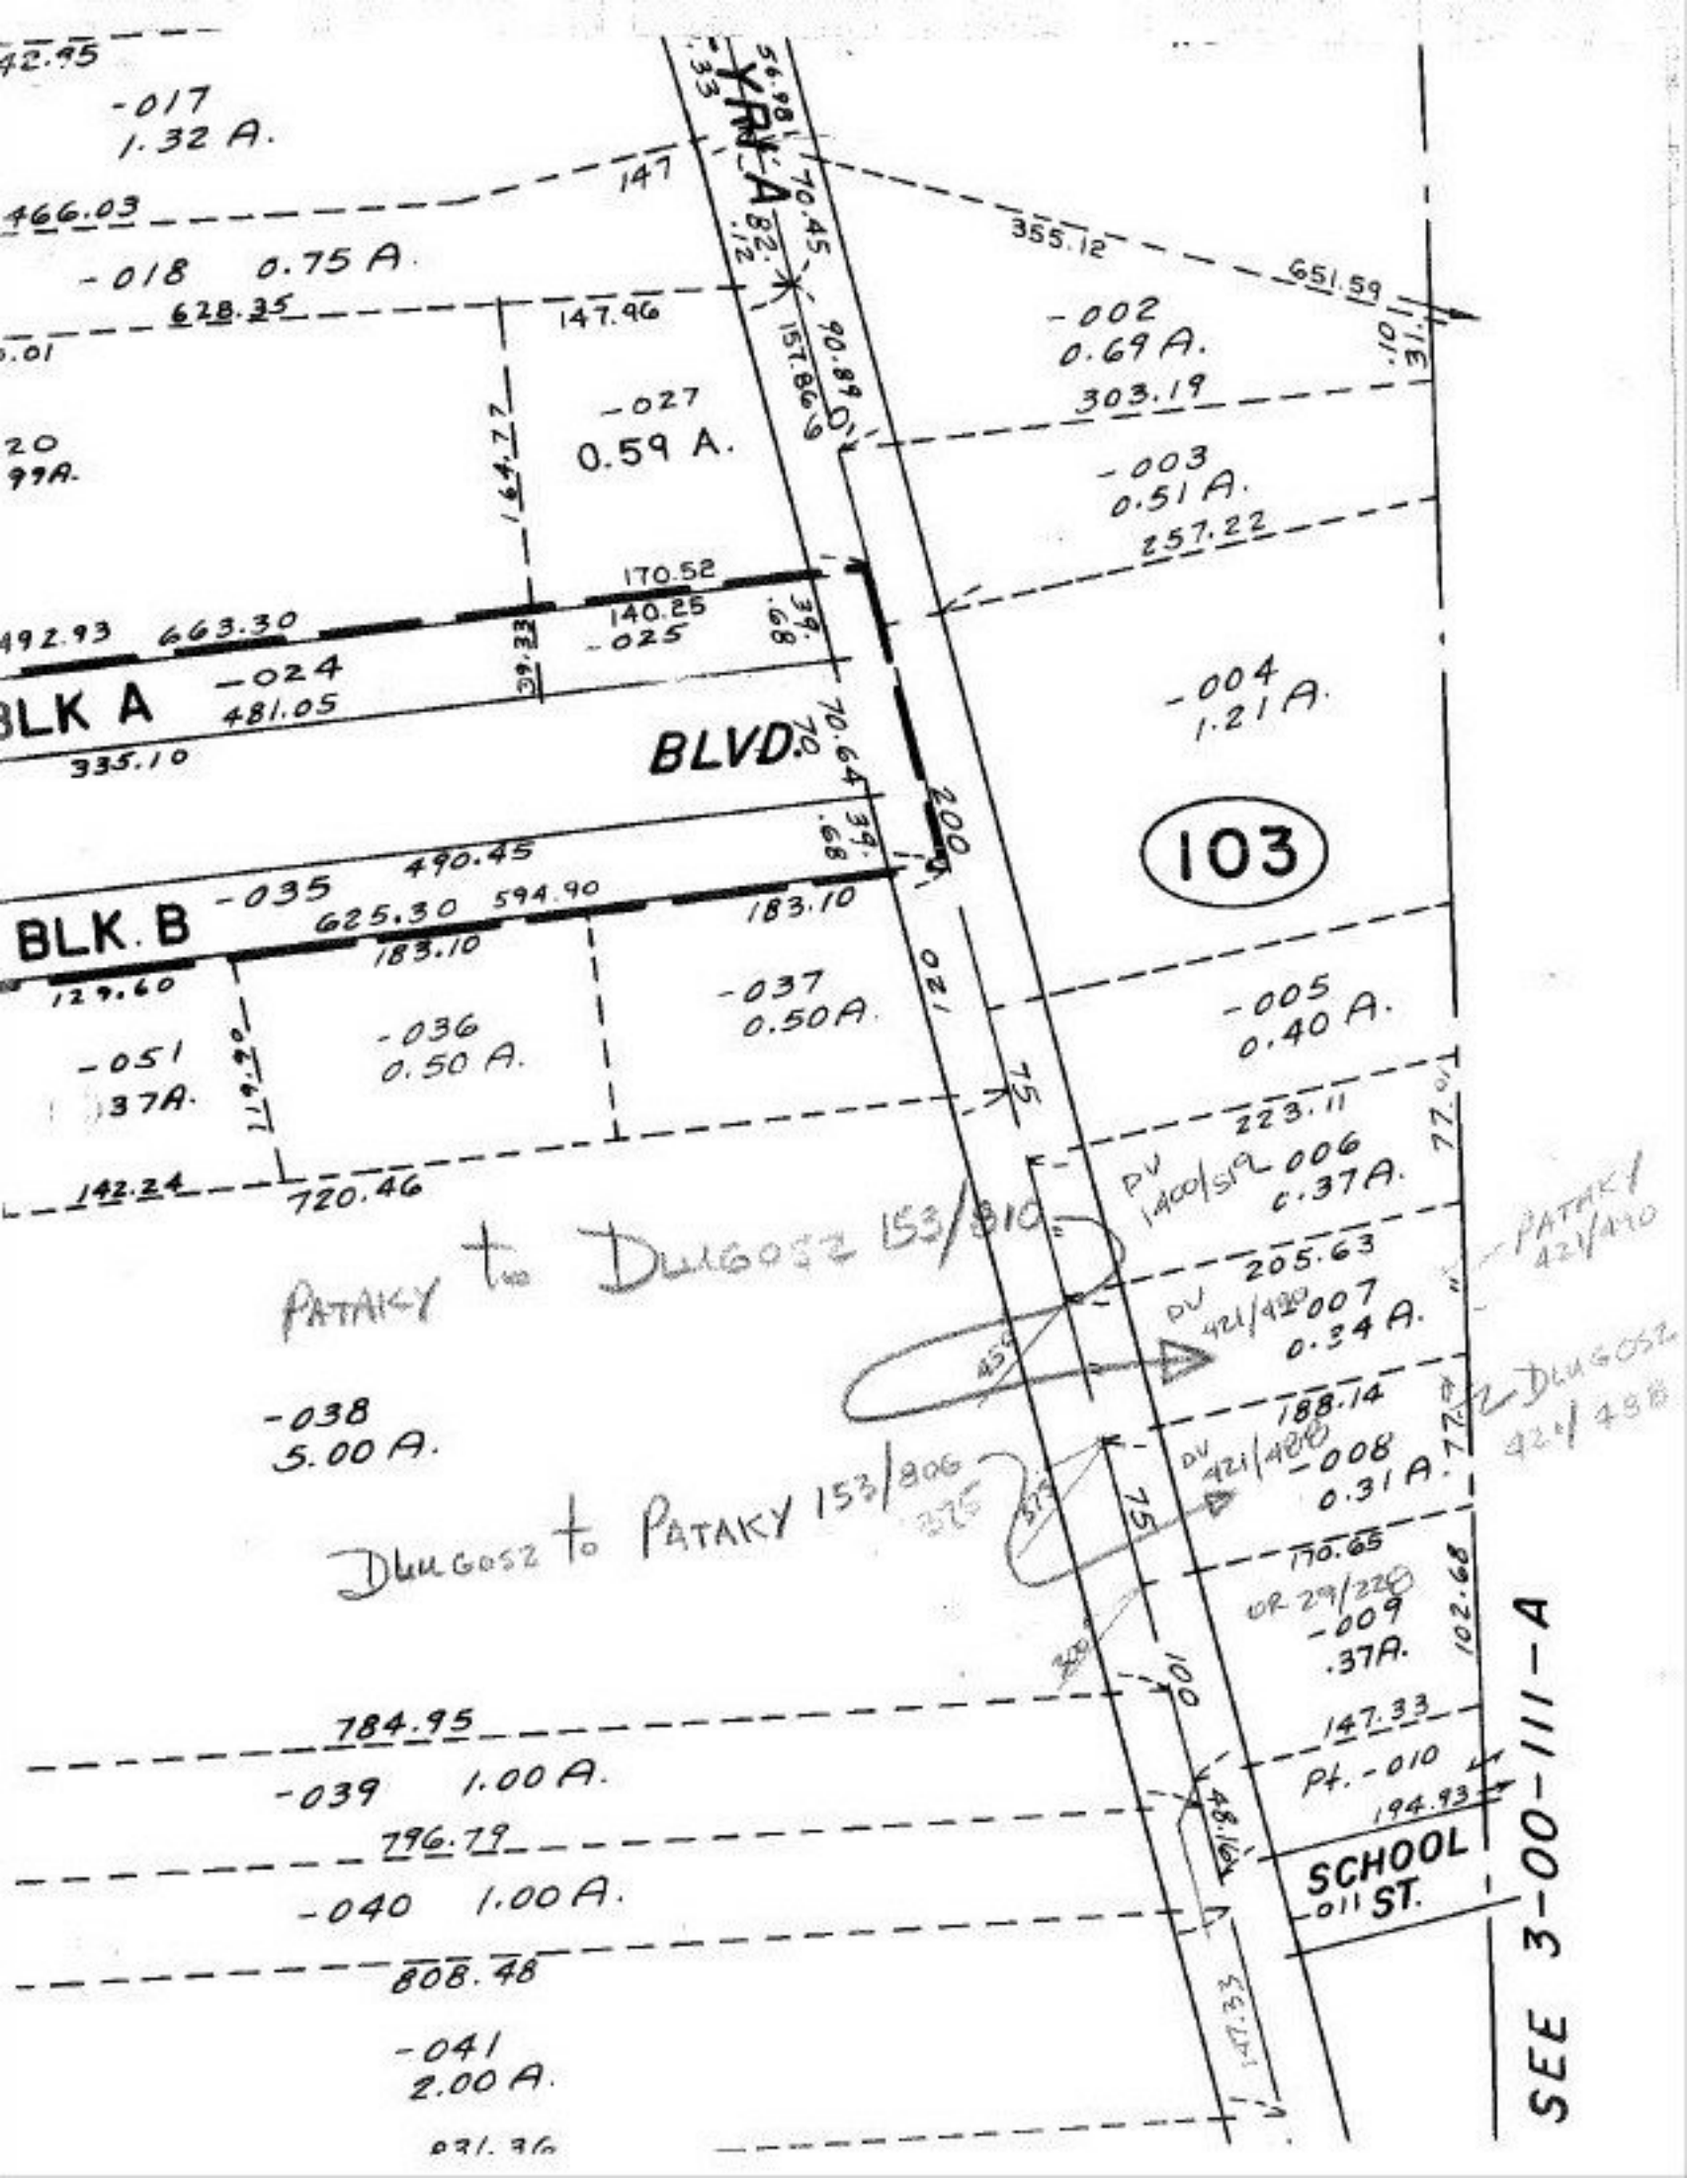

YRY A
BLK A
BLK. B
BLVD.
103
SCHOOL ST.
SEE 3-00-111-A
-017 1.32 A.
-018 0.75 A.
-027 0.59 A.
-002 0.69 A.
-003 0.51 A.
-004 1.21 A.
-005 0.40 A.
-006 0.37 A.
-007 0.34 A.
-008 0.31 A.
-009 .37A.
-024 481.05
-025 170.52 140.25
-035 490.45 625.30 594.90 183.10
-036 0.50 A.
-037 0.50 A.
-038 5.00 A.
-039 1.00 A.
-040 1.00 A.
-041 2.00 A.
-051 .37A.
-010 Pt.
PATAKY to DLUGOSZ 153/810
DLUGOSZ to PATAKY 153/806
PATAKY 421/490
DLUGOSZ 421/488