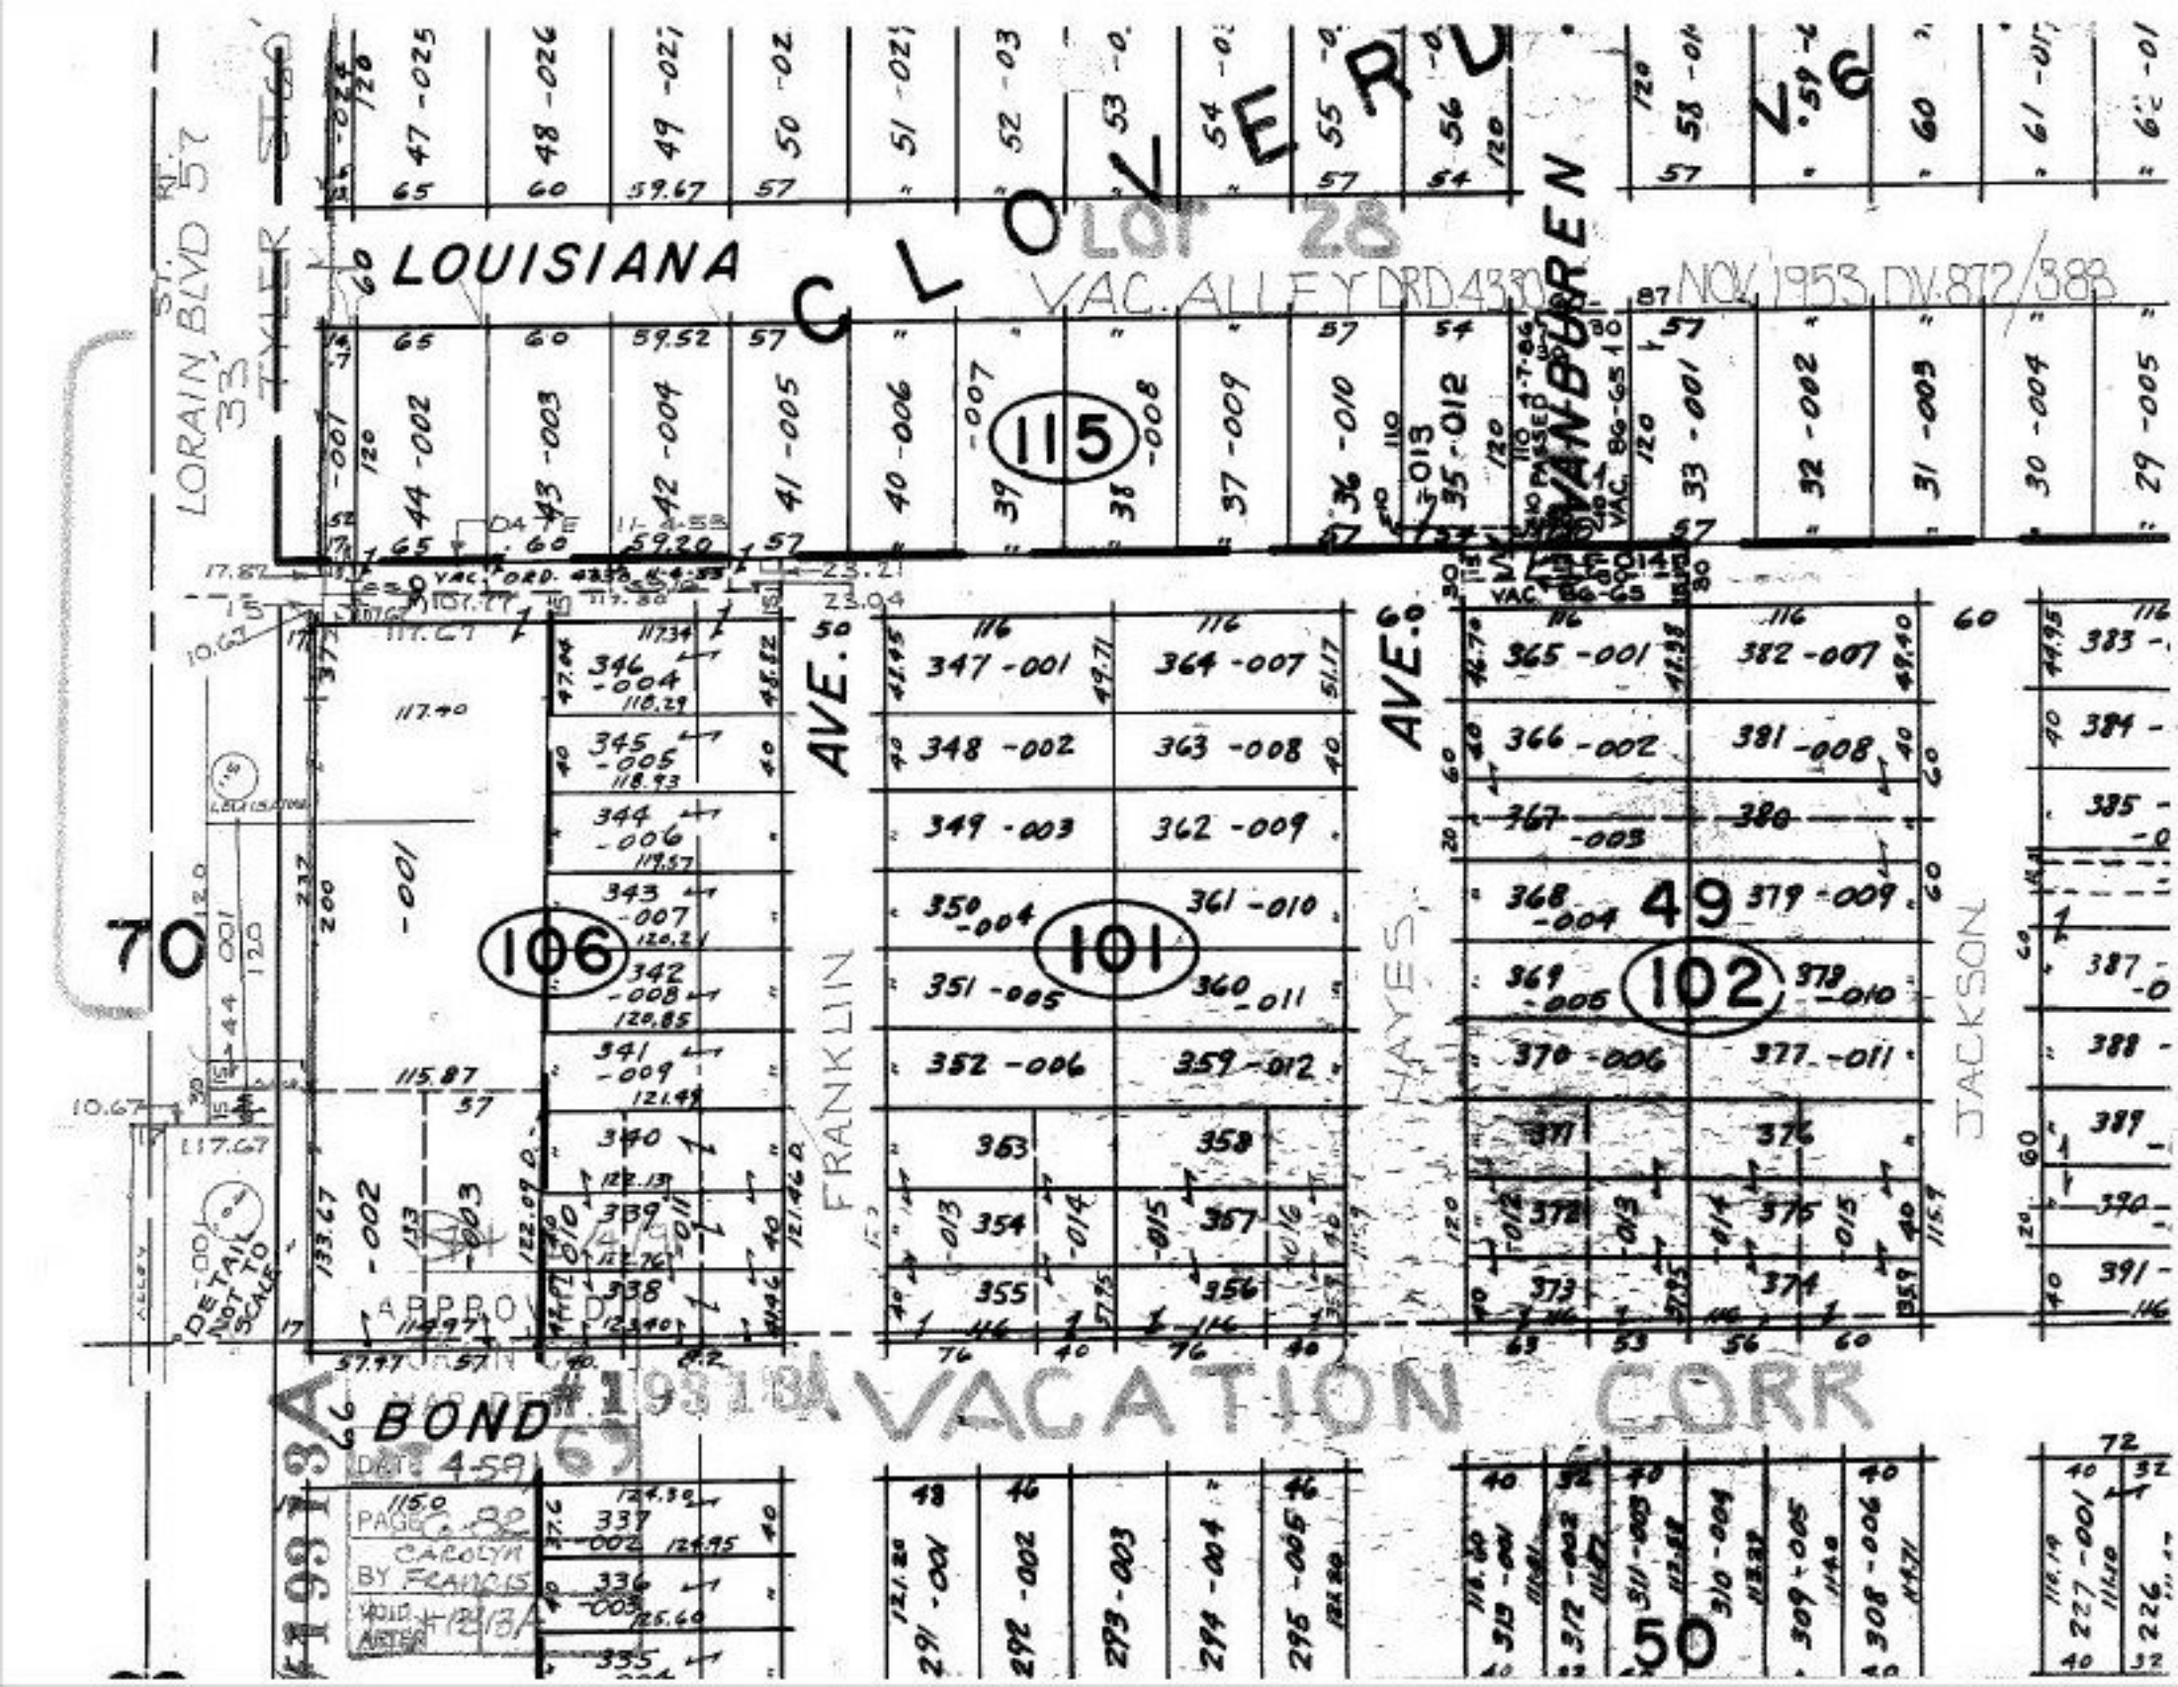
LOUISIANA
LOT 28
VAC. ALLEY ORD 4330
NOV. 1953 DV. 872/388
CLOVER
VANBUREN
TYLER
LORAIN BLVD
33
115
106
101
102
49
50
AVE.
FRANKLIN
HAYES
JACKSON
ALLEY
DETAIL NOT TO SCALE
APPROVED
BOND
VACATION CORR
PAGE C-82
CAROLYN
BY FRANCIS