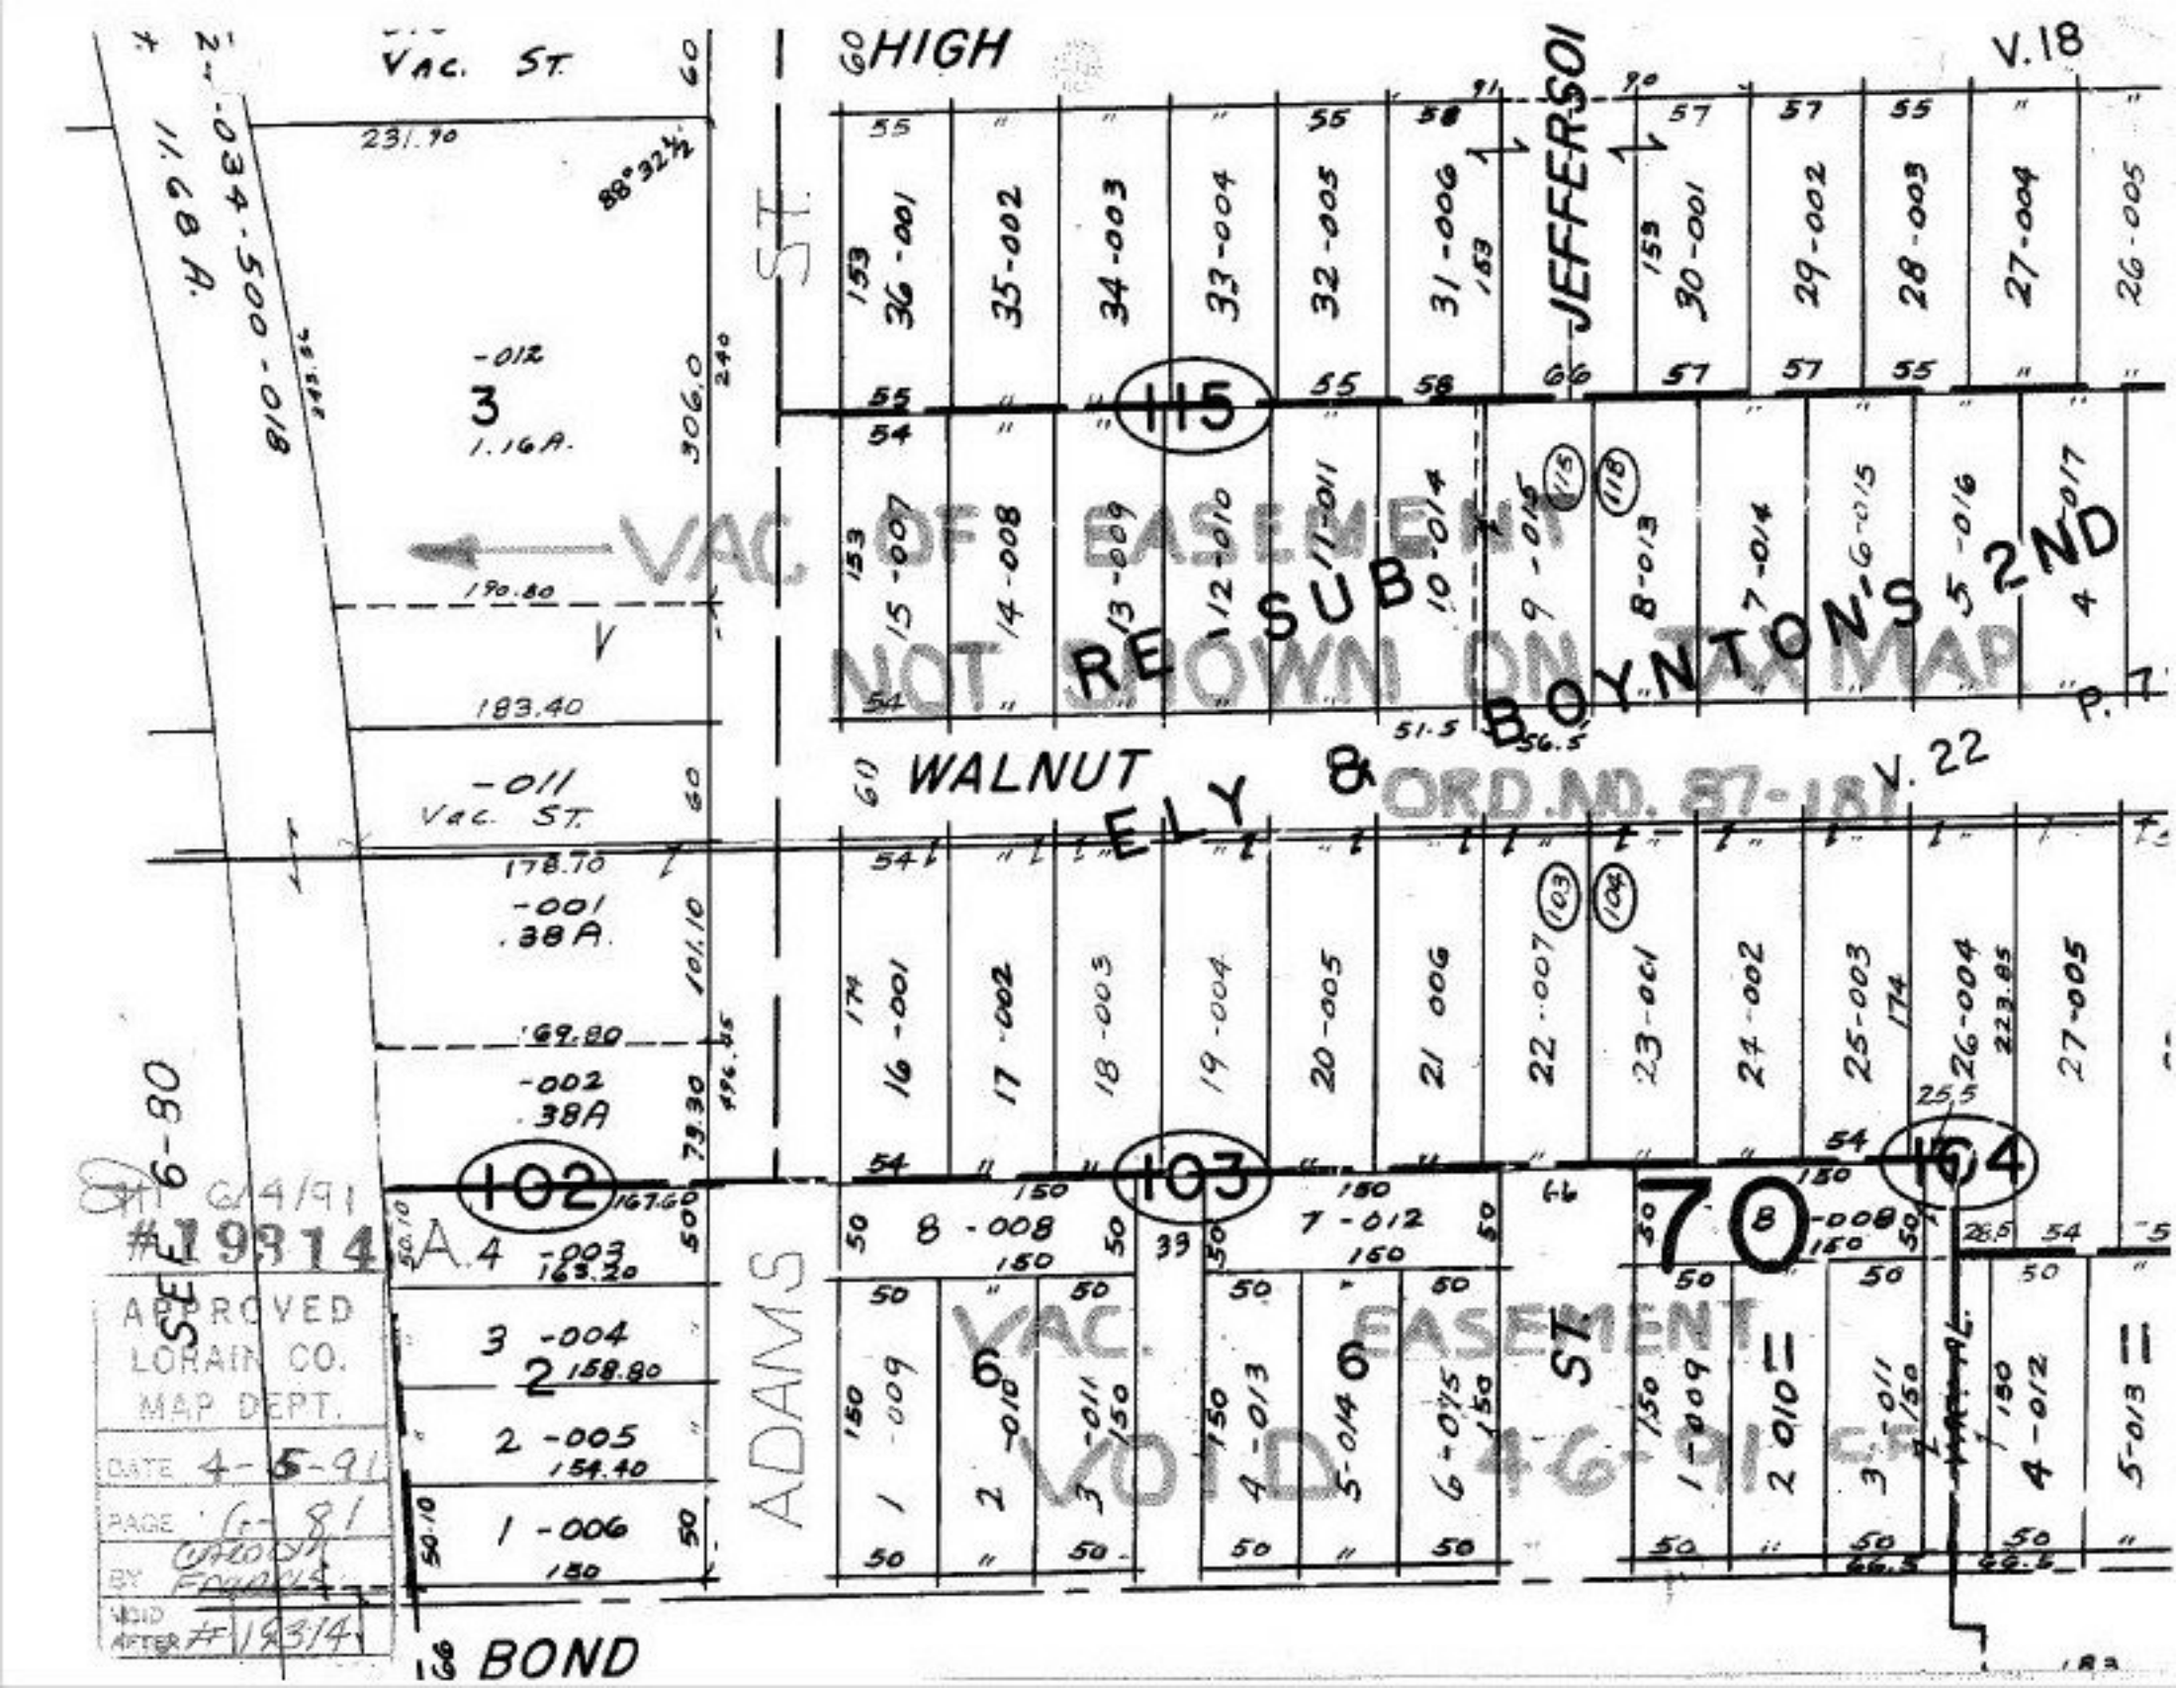
VAC. ST.
HIGH
JEFFERSON
WALNUT
ADAMS
BOND
VAC. OF EASEMENT NOT SHOWN ON TAX MAP
ORD. NO. 87-181
VOID
SUBDIVISION
BOZNTON
2ND
231.70
88°32½'
306.0
190.80
183.40
178.70
169.80
167.60
158.80
154.40
150
-012
3
1.16A.
-011
Vac. ST.
-001
.38A.
-002
.38A
-003
163.20
3 -004
2 -005
1 -006
102
103
104
115
118
15
16
17
18
19
20
21
22
23
24
25
26
27
1
2
3
4
5
6
7
8
9
10
11
12
13
14
70
6-80
4/4/91
#19314
APPROVED
LORAIN CO.
MAP DEPT.
DATE 4-5-91
PAGE 6-81
BY
VOID
AFTER #19314