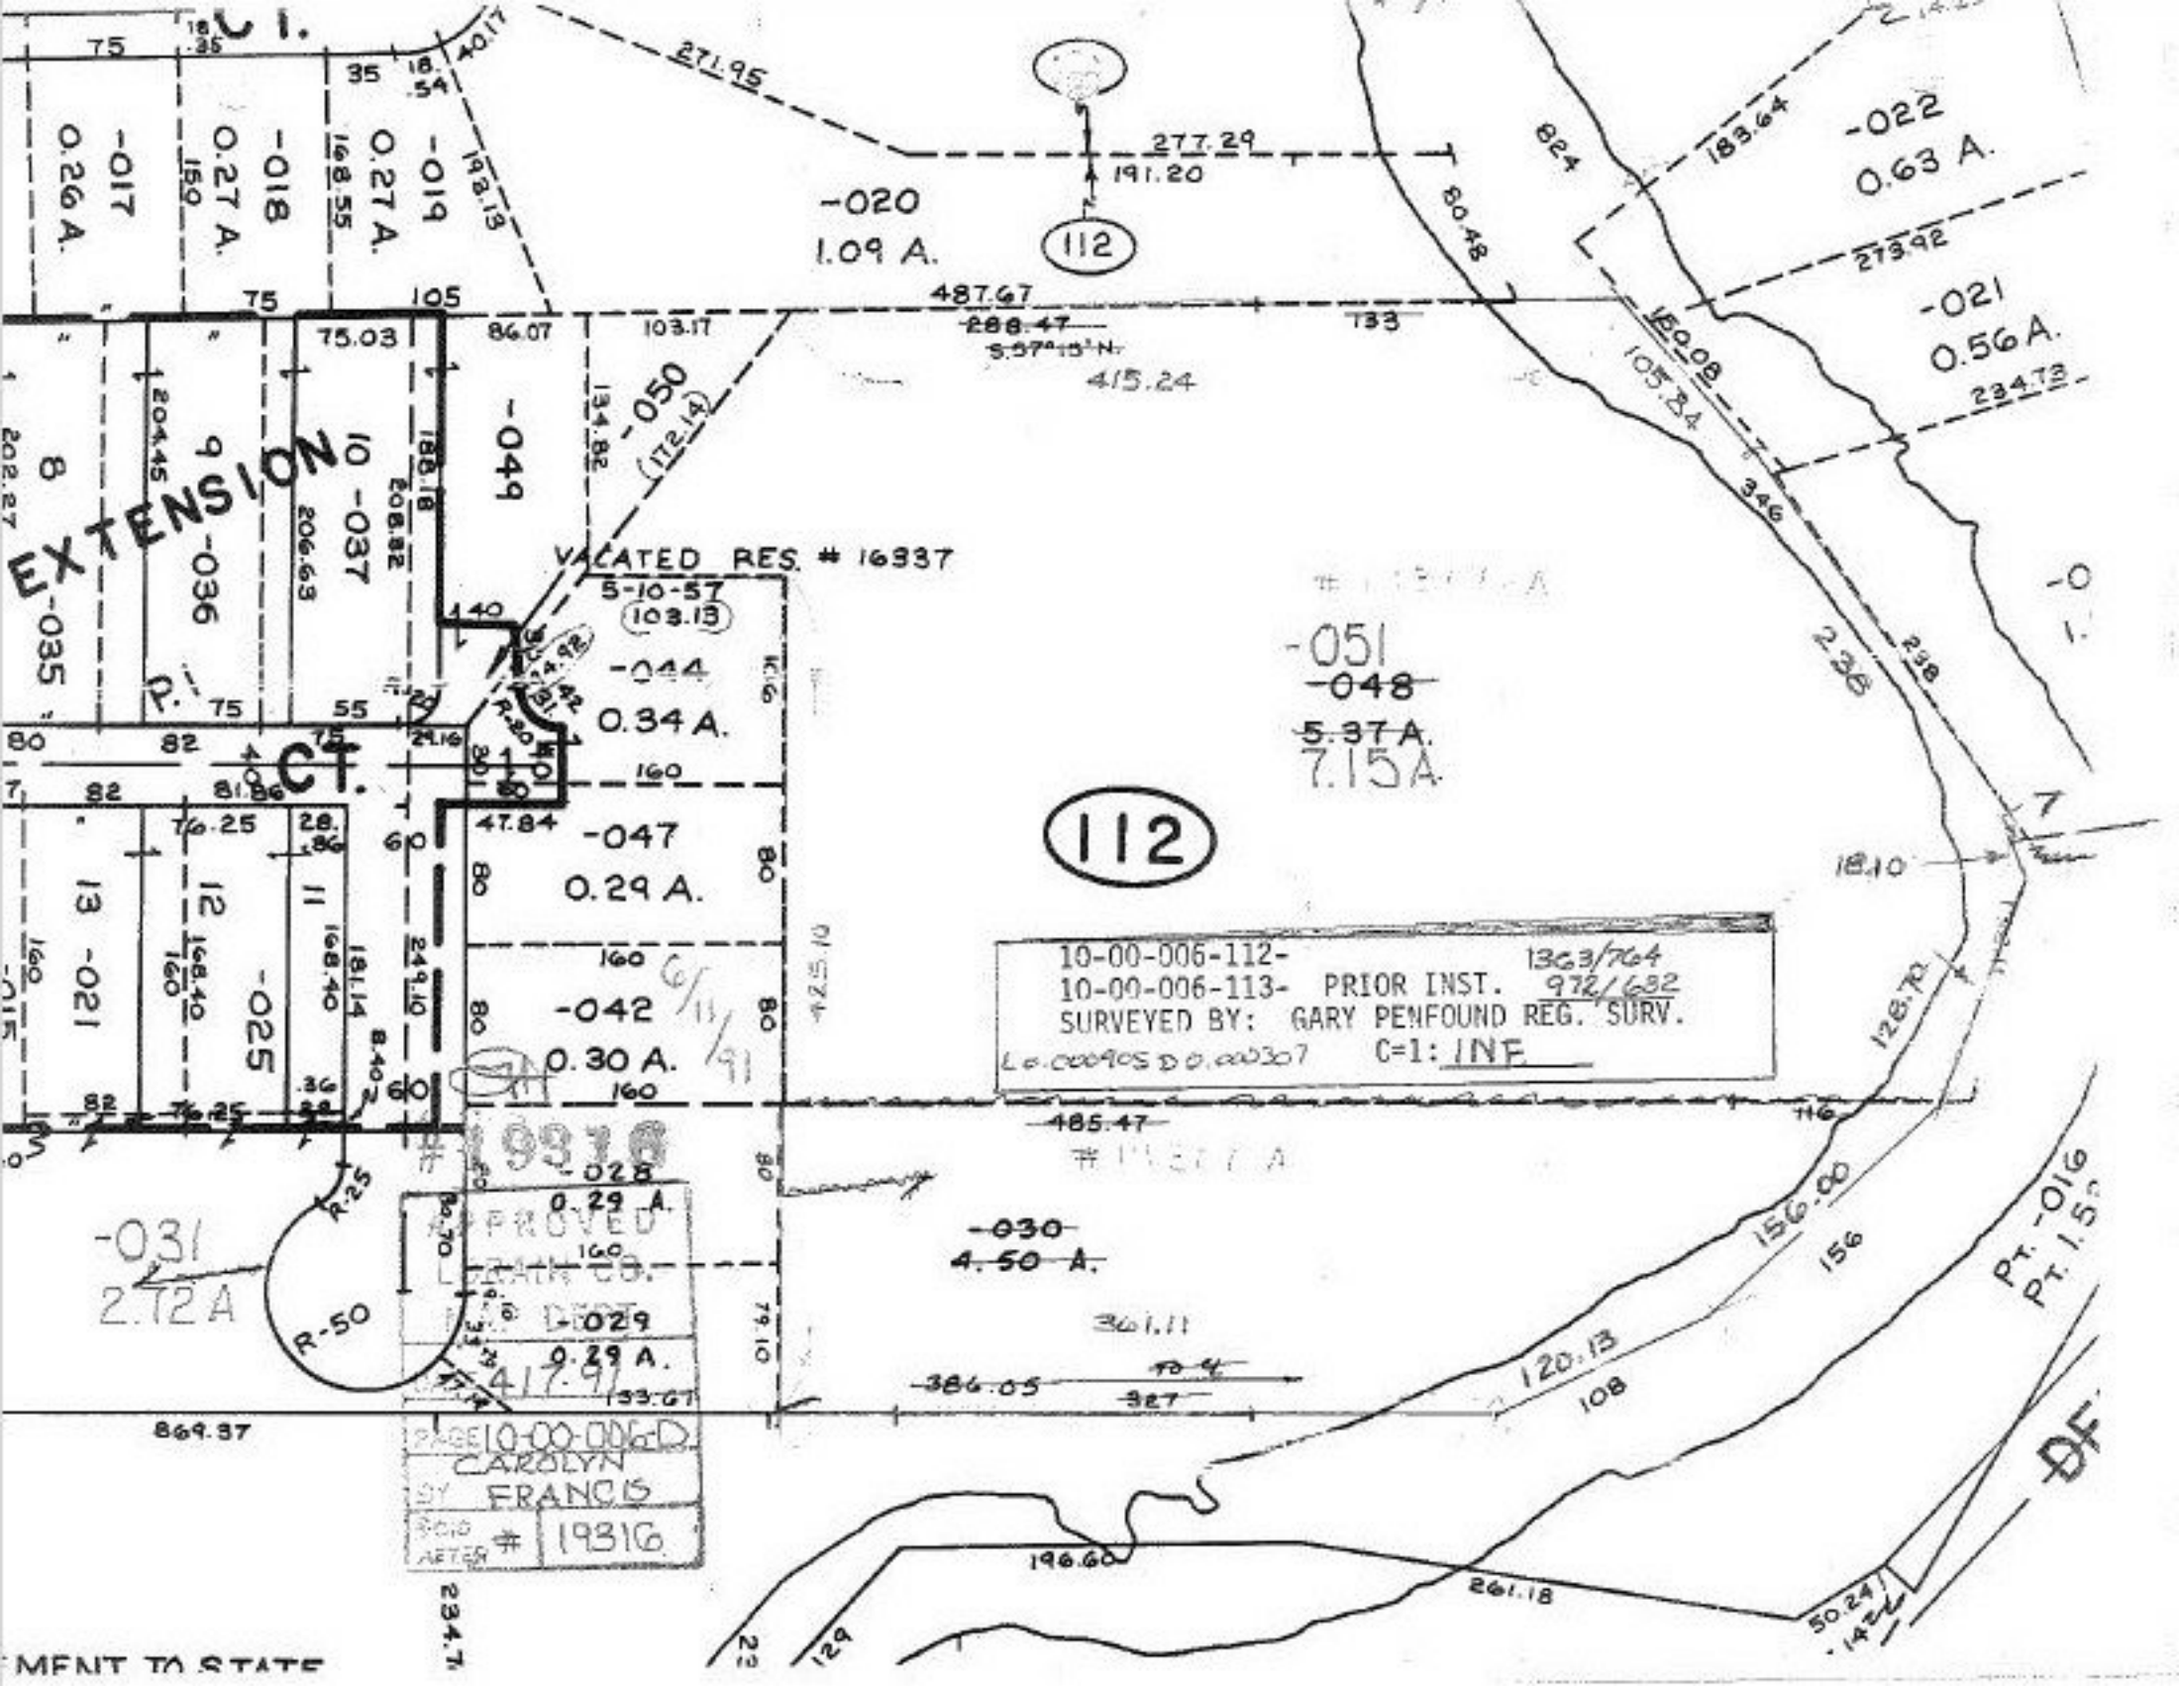

EXTENSION
CT.
VACATED RES. # 16337
5-10-57
-020
1.09 A.
-022
0.63 A.
-021
0.56 A.
-017
0.26 A.
-018
0.27 A.
-019
0.27 A.
-049
-050
-044
0.34 A.
-047
0.29 A.
-042
0.30 A.
-028
0.29 A.
-029
0.29 A.
-031
2.72 A
-051
-048
5.37 A.
7.15 A.
-030
4.50 A.
112
10-00-006-112-
10-00-006-113- PRIOR INST. 1363/764 972/682
SURVEYED BY: GARY PENFOUND REG. SURV.
C=1: INF
APPROVED
LORAIN CO.
PAGE 10-00-006-D
CAROLYN
BY FRANCIS
SOLD AFTER # 19316
MENT TO STATE