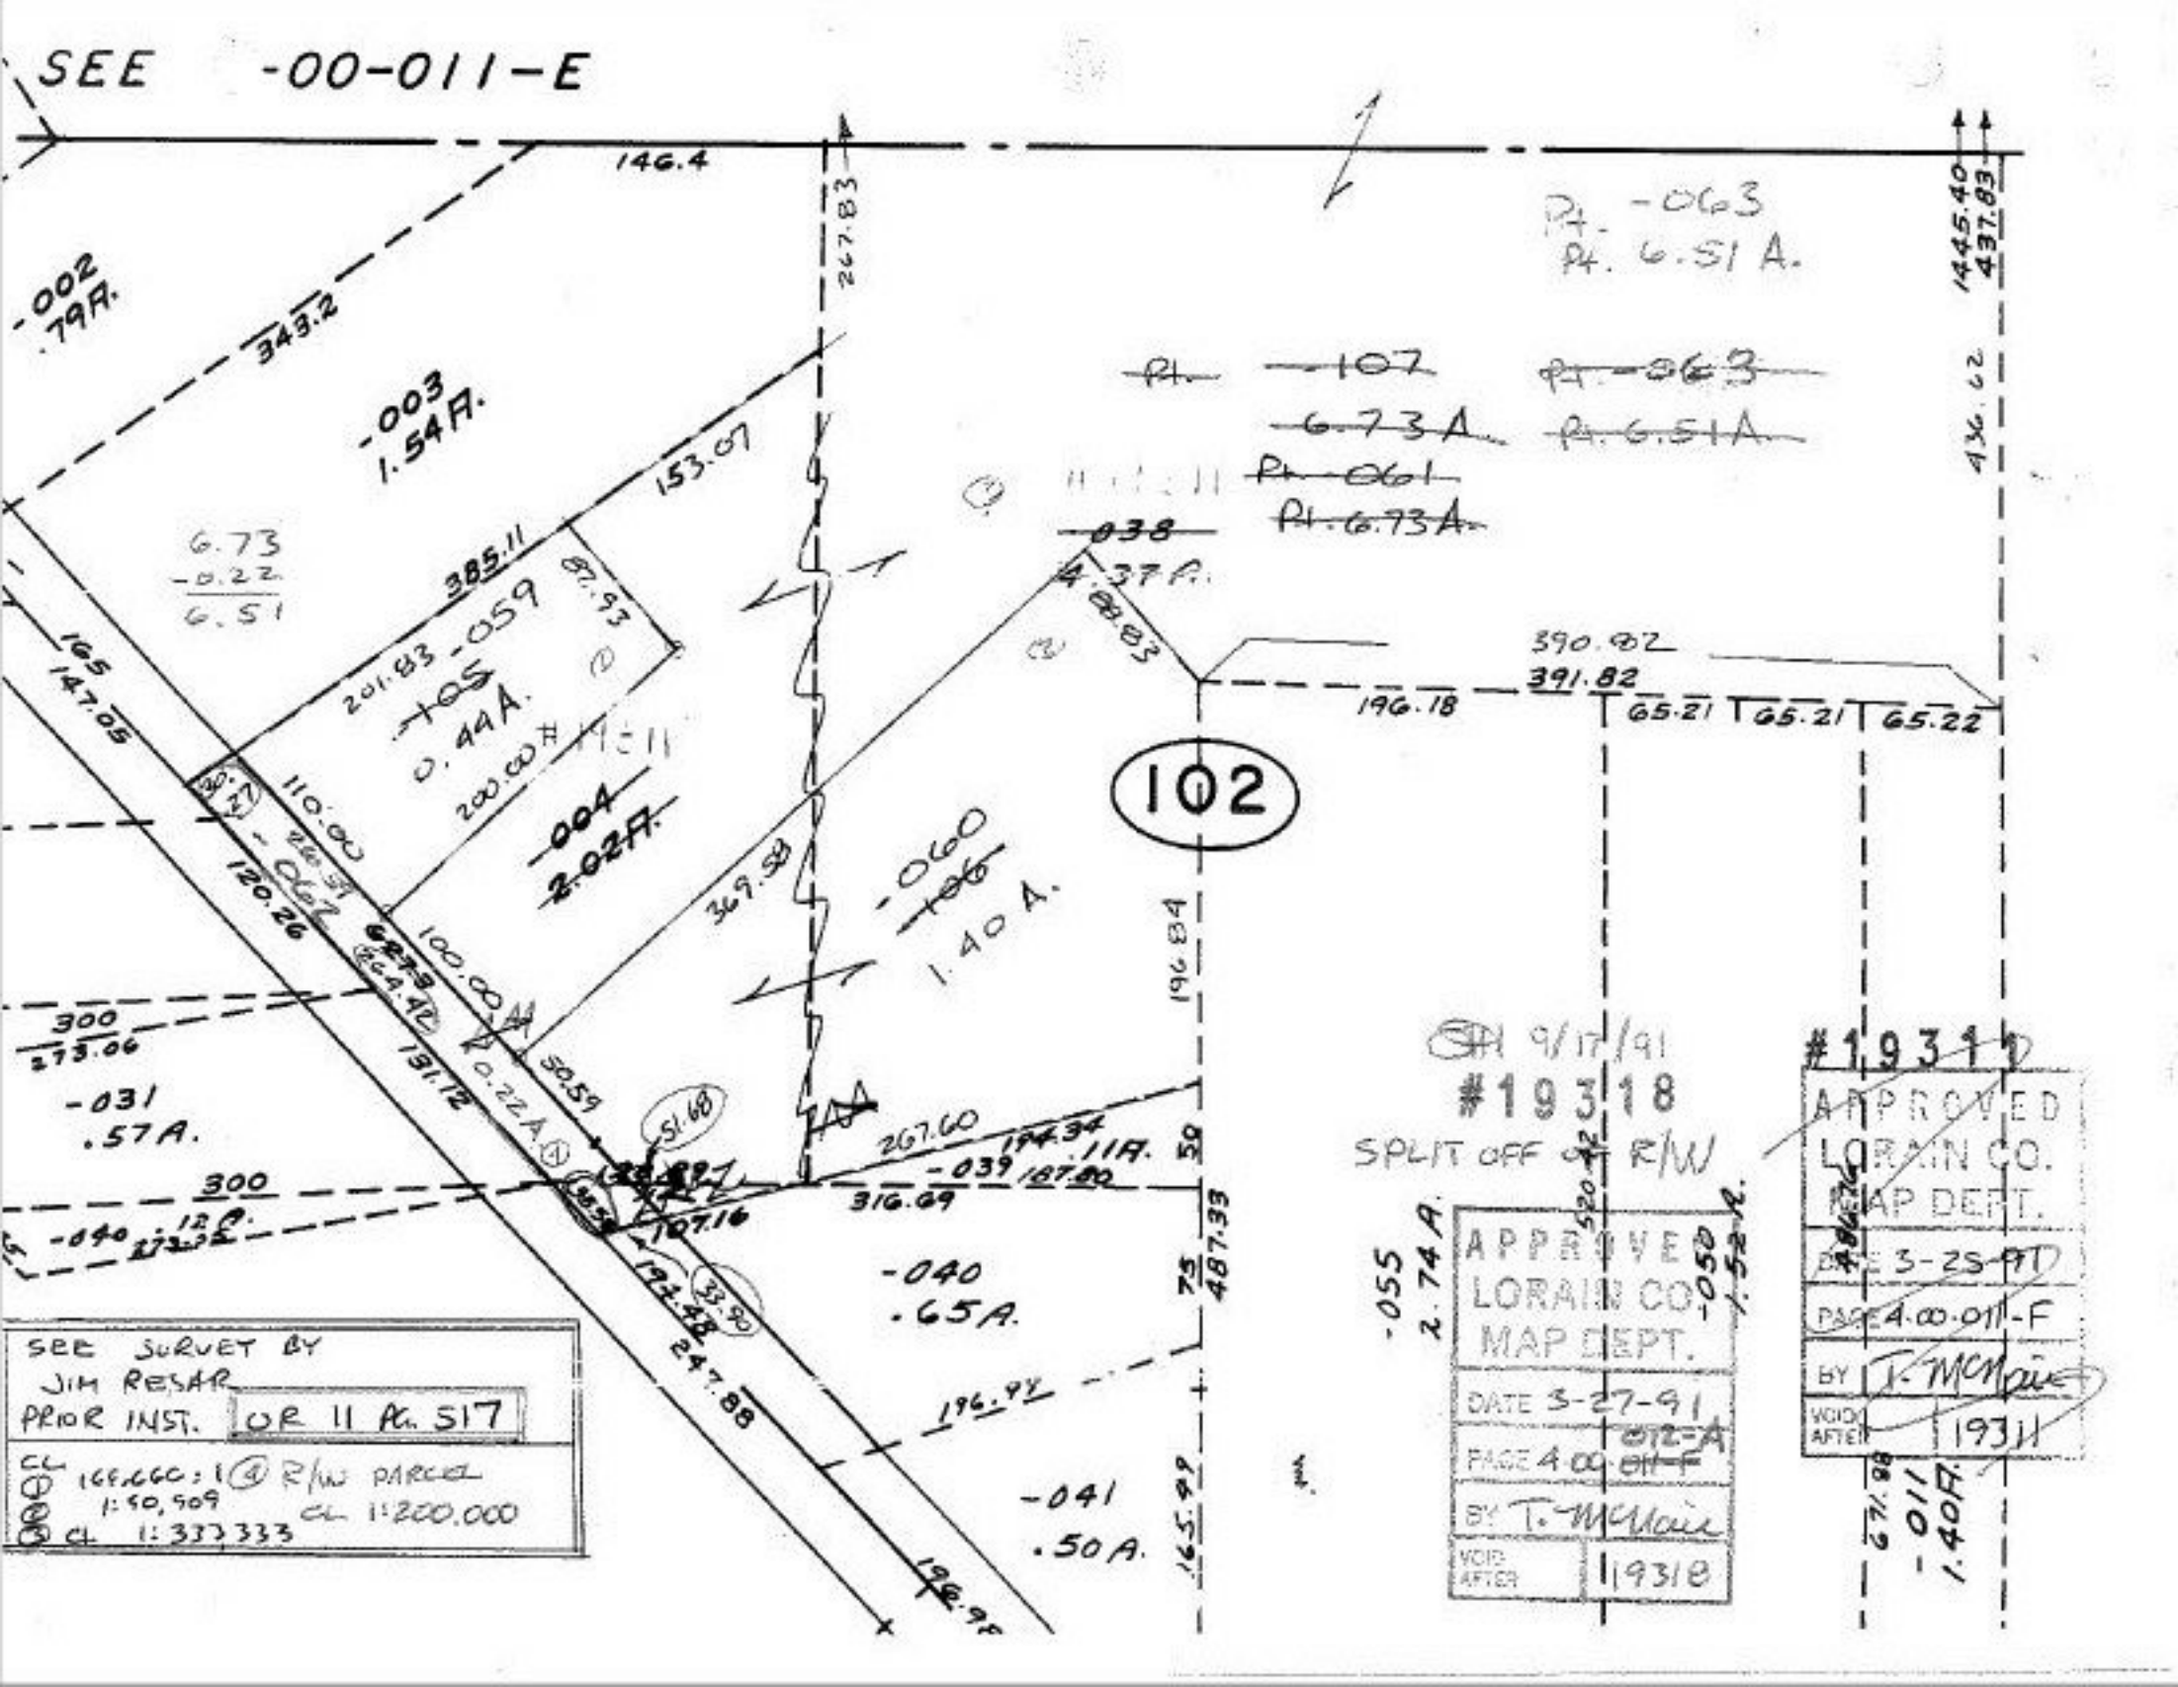
SEE -00-011-E
146.4
267.83
343.2
-002
.79A.
-003
1.54A.
153.07
6.73
-0.22
6.51
385.11
87.93
201.83
-059
-105
0.44A.
200.00
-004
2.02A.
165
147.05
110.00
120.26
100.00
369.58
-060
-106
1.40 A.
300
273.06
-031
.57A.
131.12
0.22A
50.59
51.68
267.60
194.34
-039
.11A.
187.80
316.69
107.16
300
-040
-040
.65A.
247.88
196.94
-041
.50A.
165.99
196.98
102
196.84
487.33
Pt. -063
Pt. 6.51 A.
1445.40
437.83
436.62
Pt. -107
6.73A
Pt. -063
Pt. 6.51A
Pt. -061
Pt. 6.73A
-038
4.37A.
390.82
391.82
196.18
65.21
65.21
65.22
9/17/91
#19318
SPLIT OFF of R/W
APPROVED
LORAIN CO.
MAP DEPT.
DATE 3-27-91
PAGE 4.00-012-A
BY T. McNair
VOID AFTER 19318
#19311
APPROVED
LORAIN CO.
MAP DEPT.
DATE 3-25-91
PAGE 4.00-011-F
BY T. McNair
VOID AFTER 19311
-055
2.74A.
-050
1.52A.
671.88
-011
1.40A.
SEE SURVEY BY
JIM RESAR
PRIOR INST. OR 11 Pg. 517
CL 1:166,660 : 1 ④ R/W PARCEL
1:50,909 CL 1:200,000
CL 1:333,333