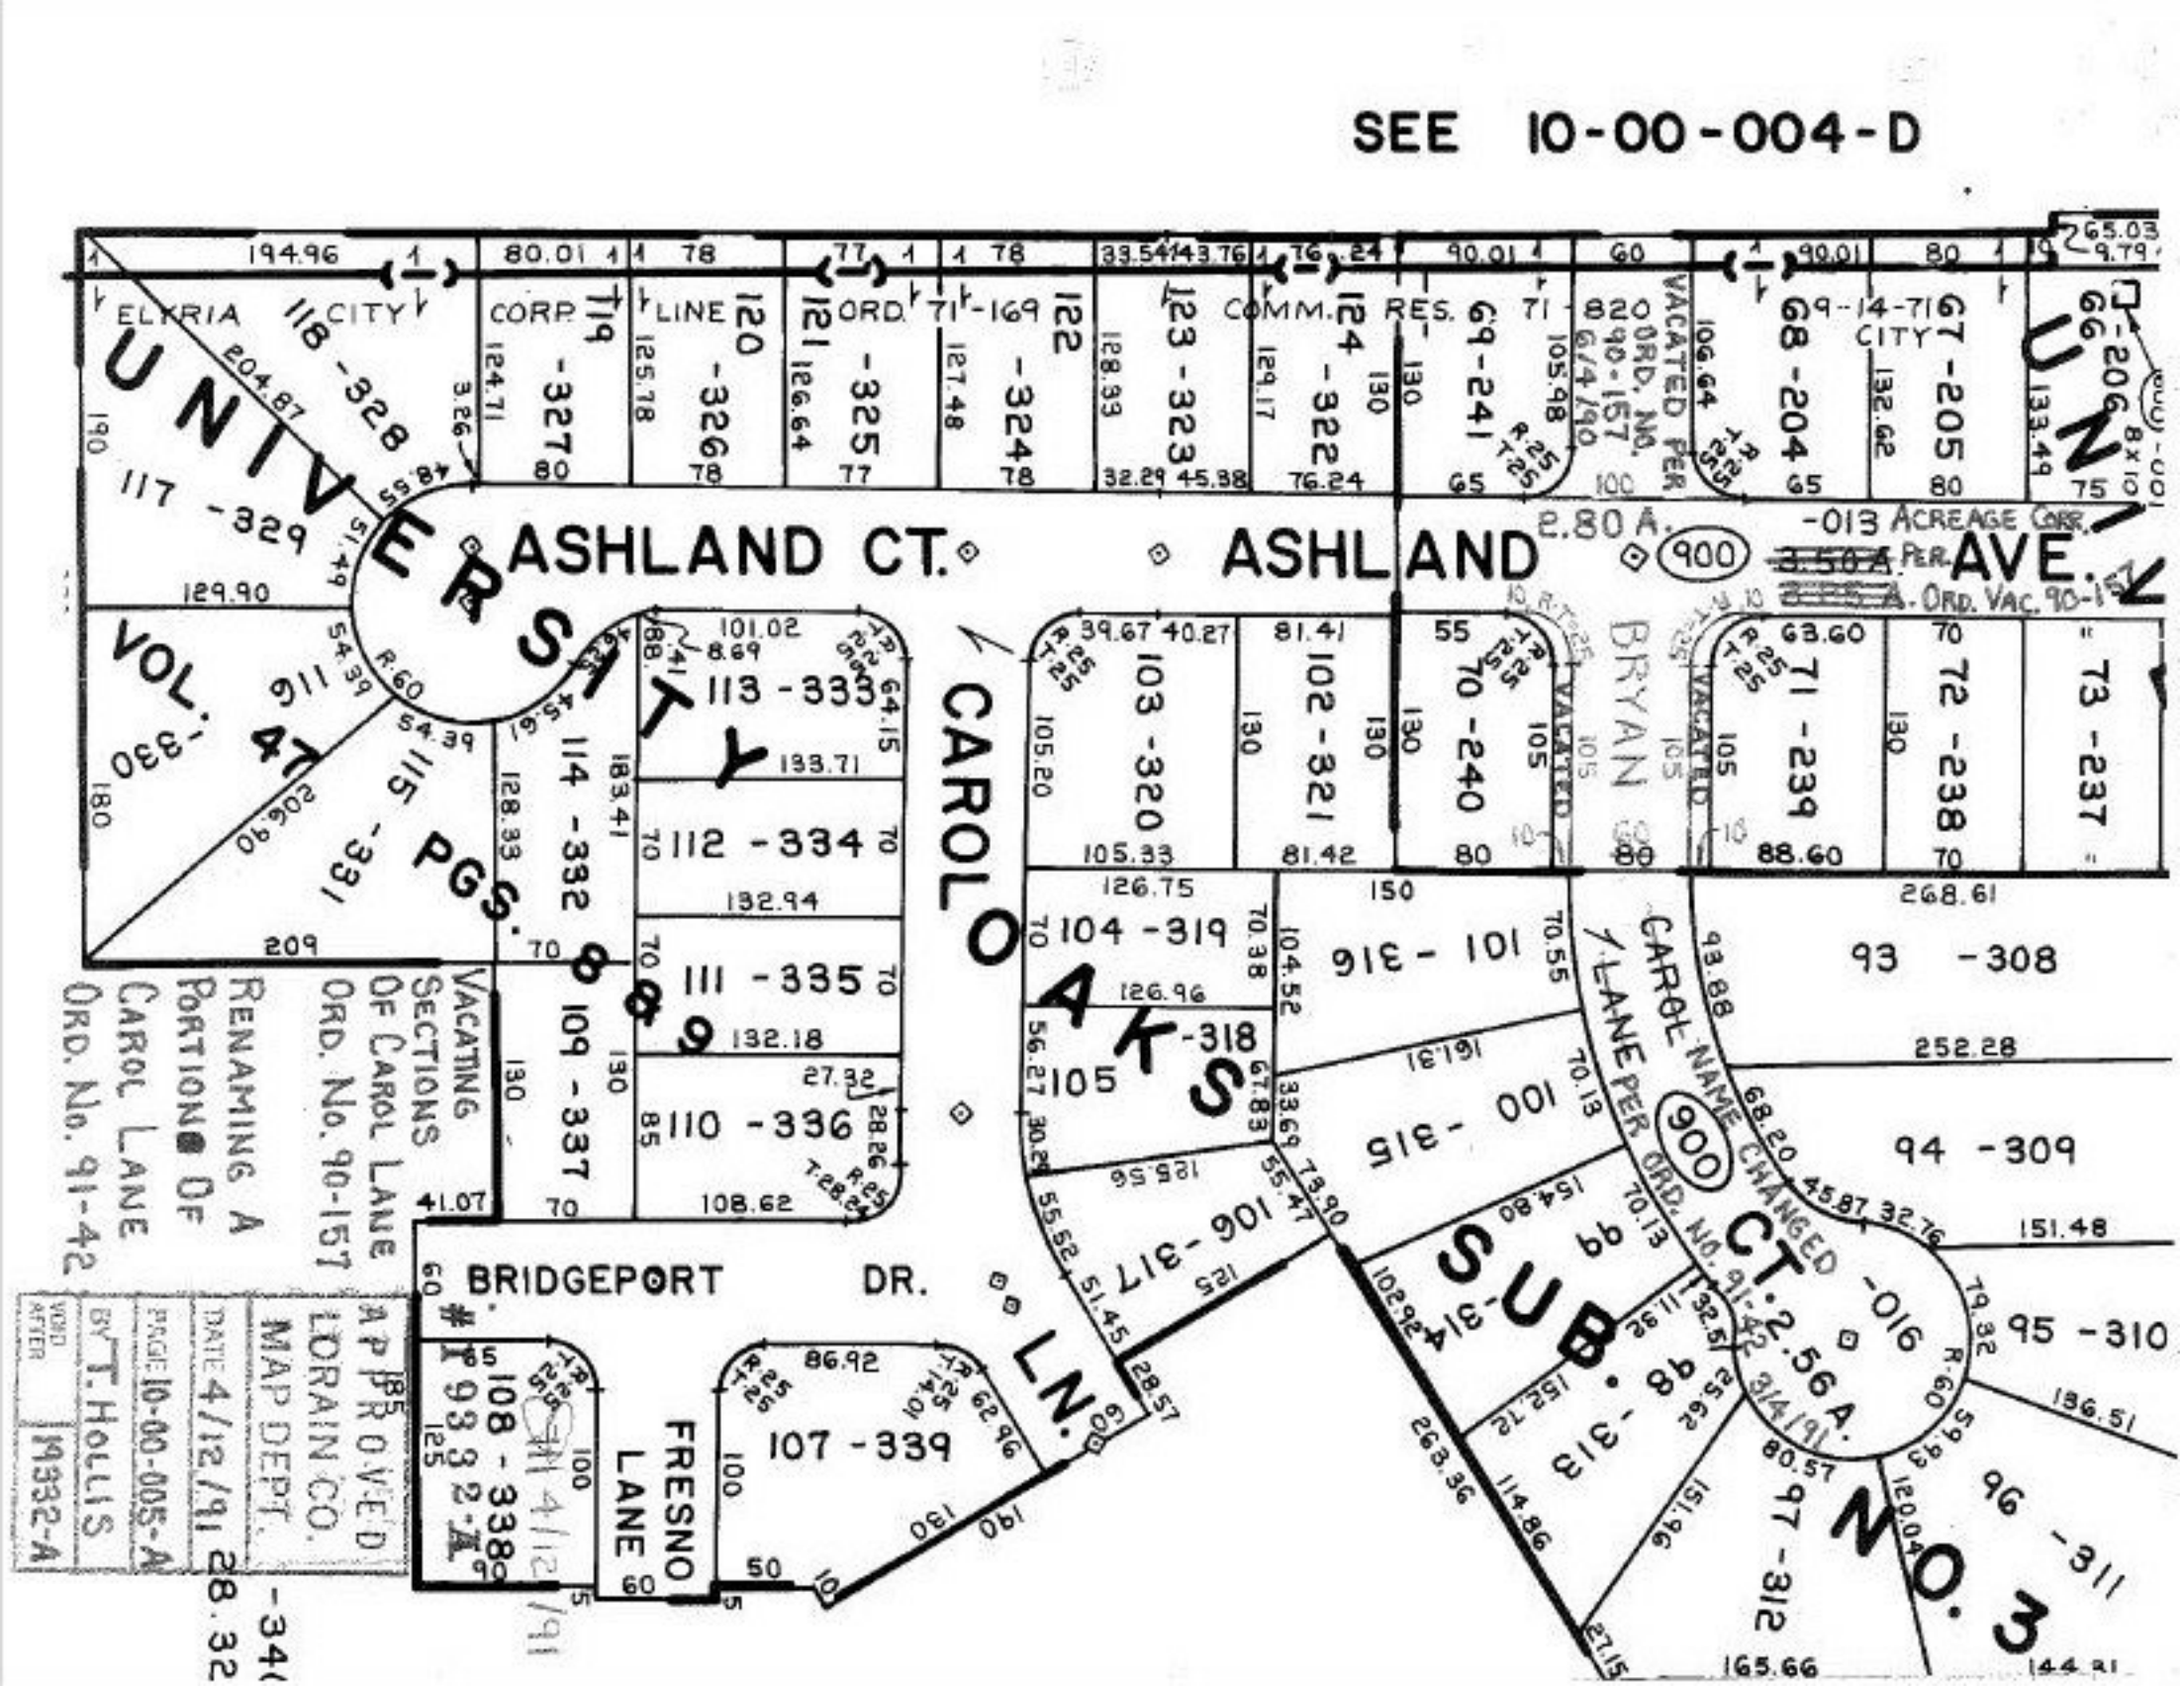SEE 10-00-004-D