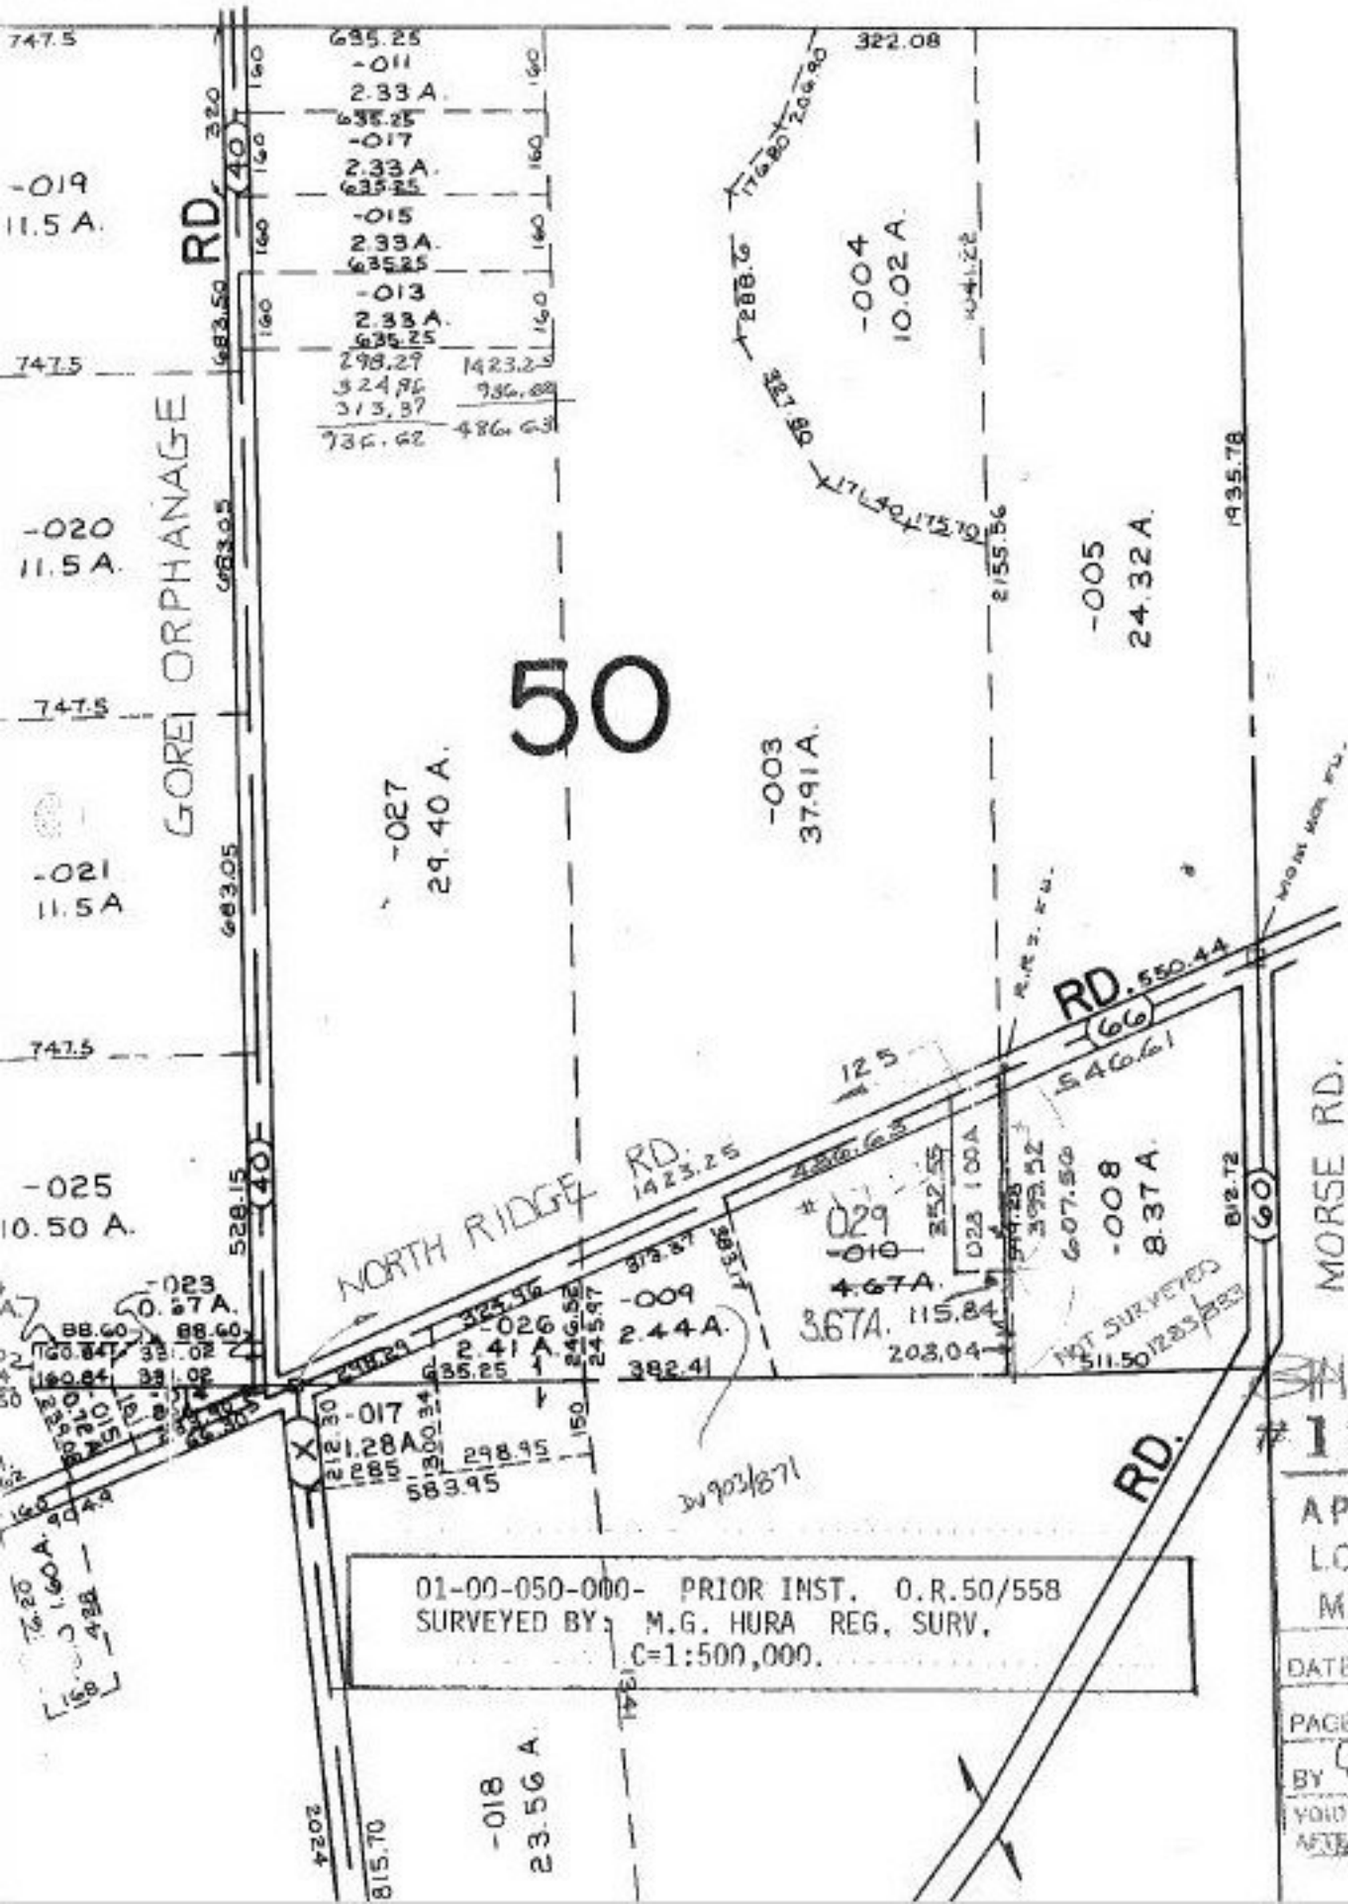
50
GOREI ORPHANAGE RD.
NORTH RIDGE RD.
MORSE RD.
RD.
-019 11.5 A.
-020 11.5 A.
-021 11.5A
-025 10.50 A.
-027 29.40 A.
-003 37.91A.
-004 10.02 A.
-005 24.32 A.
-008 8.37 A.
-009 2.44A.
-010 4.67A.
-011 2.33 A.
-013 2.33A.
-015 2.33A.
-017 2.33A.
-018 23.56 A.
-023 0.87A.
-026 2.41 A.
-029 1.00A.
01-00-050-000- PRIOR INST. O.R.50/558
SURVEYED BY: M.G. HURA REG. SURV.
C=1:500,000.
APPROVED
LORAIN CO.
MAP DEPT.
DATE 4-22-91
PAGE 1-I
BY CAROLYN FRANCIS
VOID AFTER # 19339
SUN 6/14/91
#19339