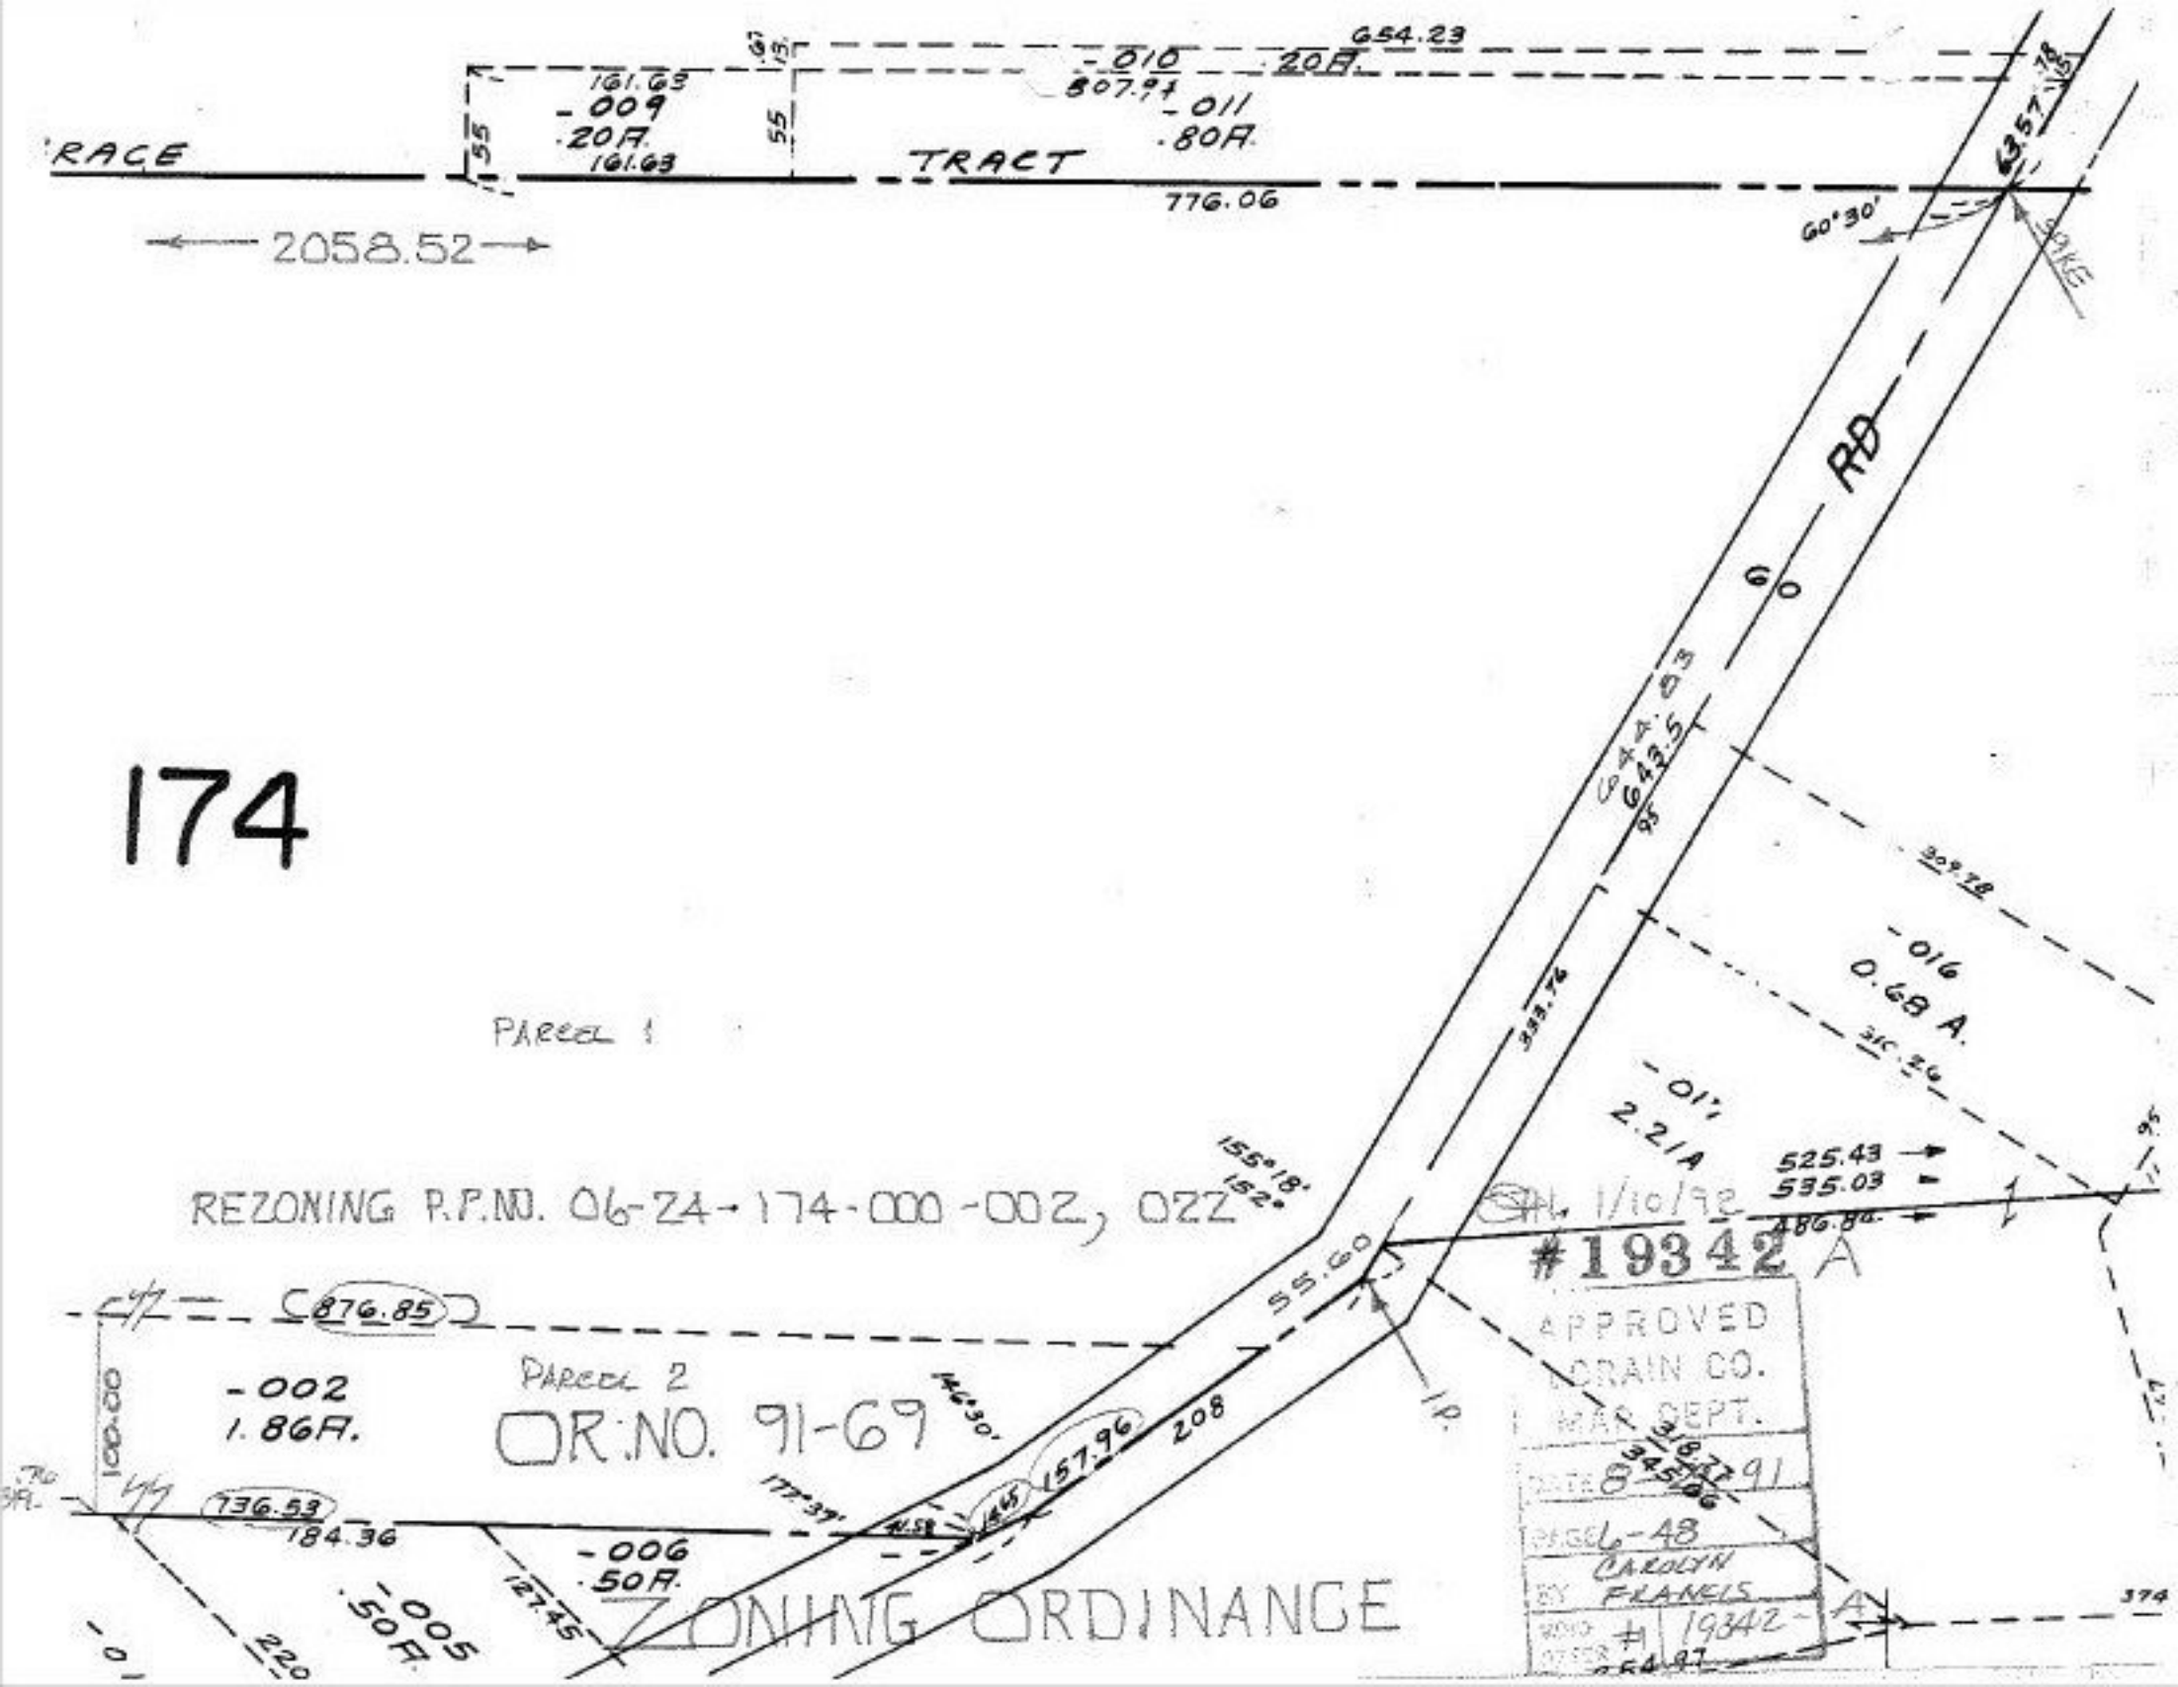
174
RACE
TRACT
2058.52
161.63
-009
.20A.
161.63
55
55
-010
.20A.
807.91
-011
.80A.
654.23
776.06
357.78
60°30'
SPIKE
RD
60
644.03
643.5
95
309.78
-016
0.68 A.
318.76
-011
2.21A
525.43
535.03
486.86
95
155°18'
152.
55.60
I.P.
REZONING P.P.NO. 06-24-174-000-002, 022
PARCEL 1
PARCEL 2
OR:NO. 91-69
876.85
-002
1.86A.
100.00
736.53
184.36
-006
.50A.
-005
.50A.
220
127.45
144°30'
172°39'
157.96
208
I.P.
ZONING ORDINANCE
1/10/92
#19342 A
APPROVED
DRAIN CO.
MAR DEPT.
DATE 8-345-91
PAGE 6-48
CAROLYN
BY FRANCIS
WORK ORDER # 19342-
374