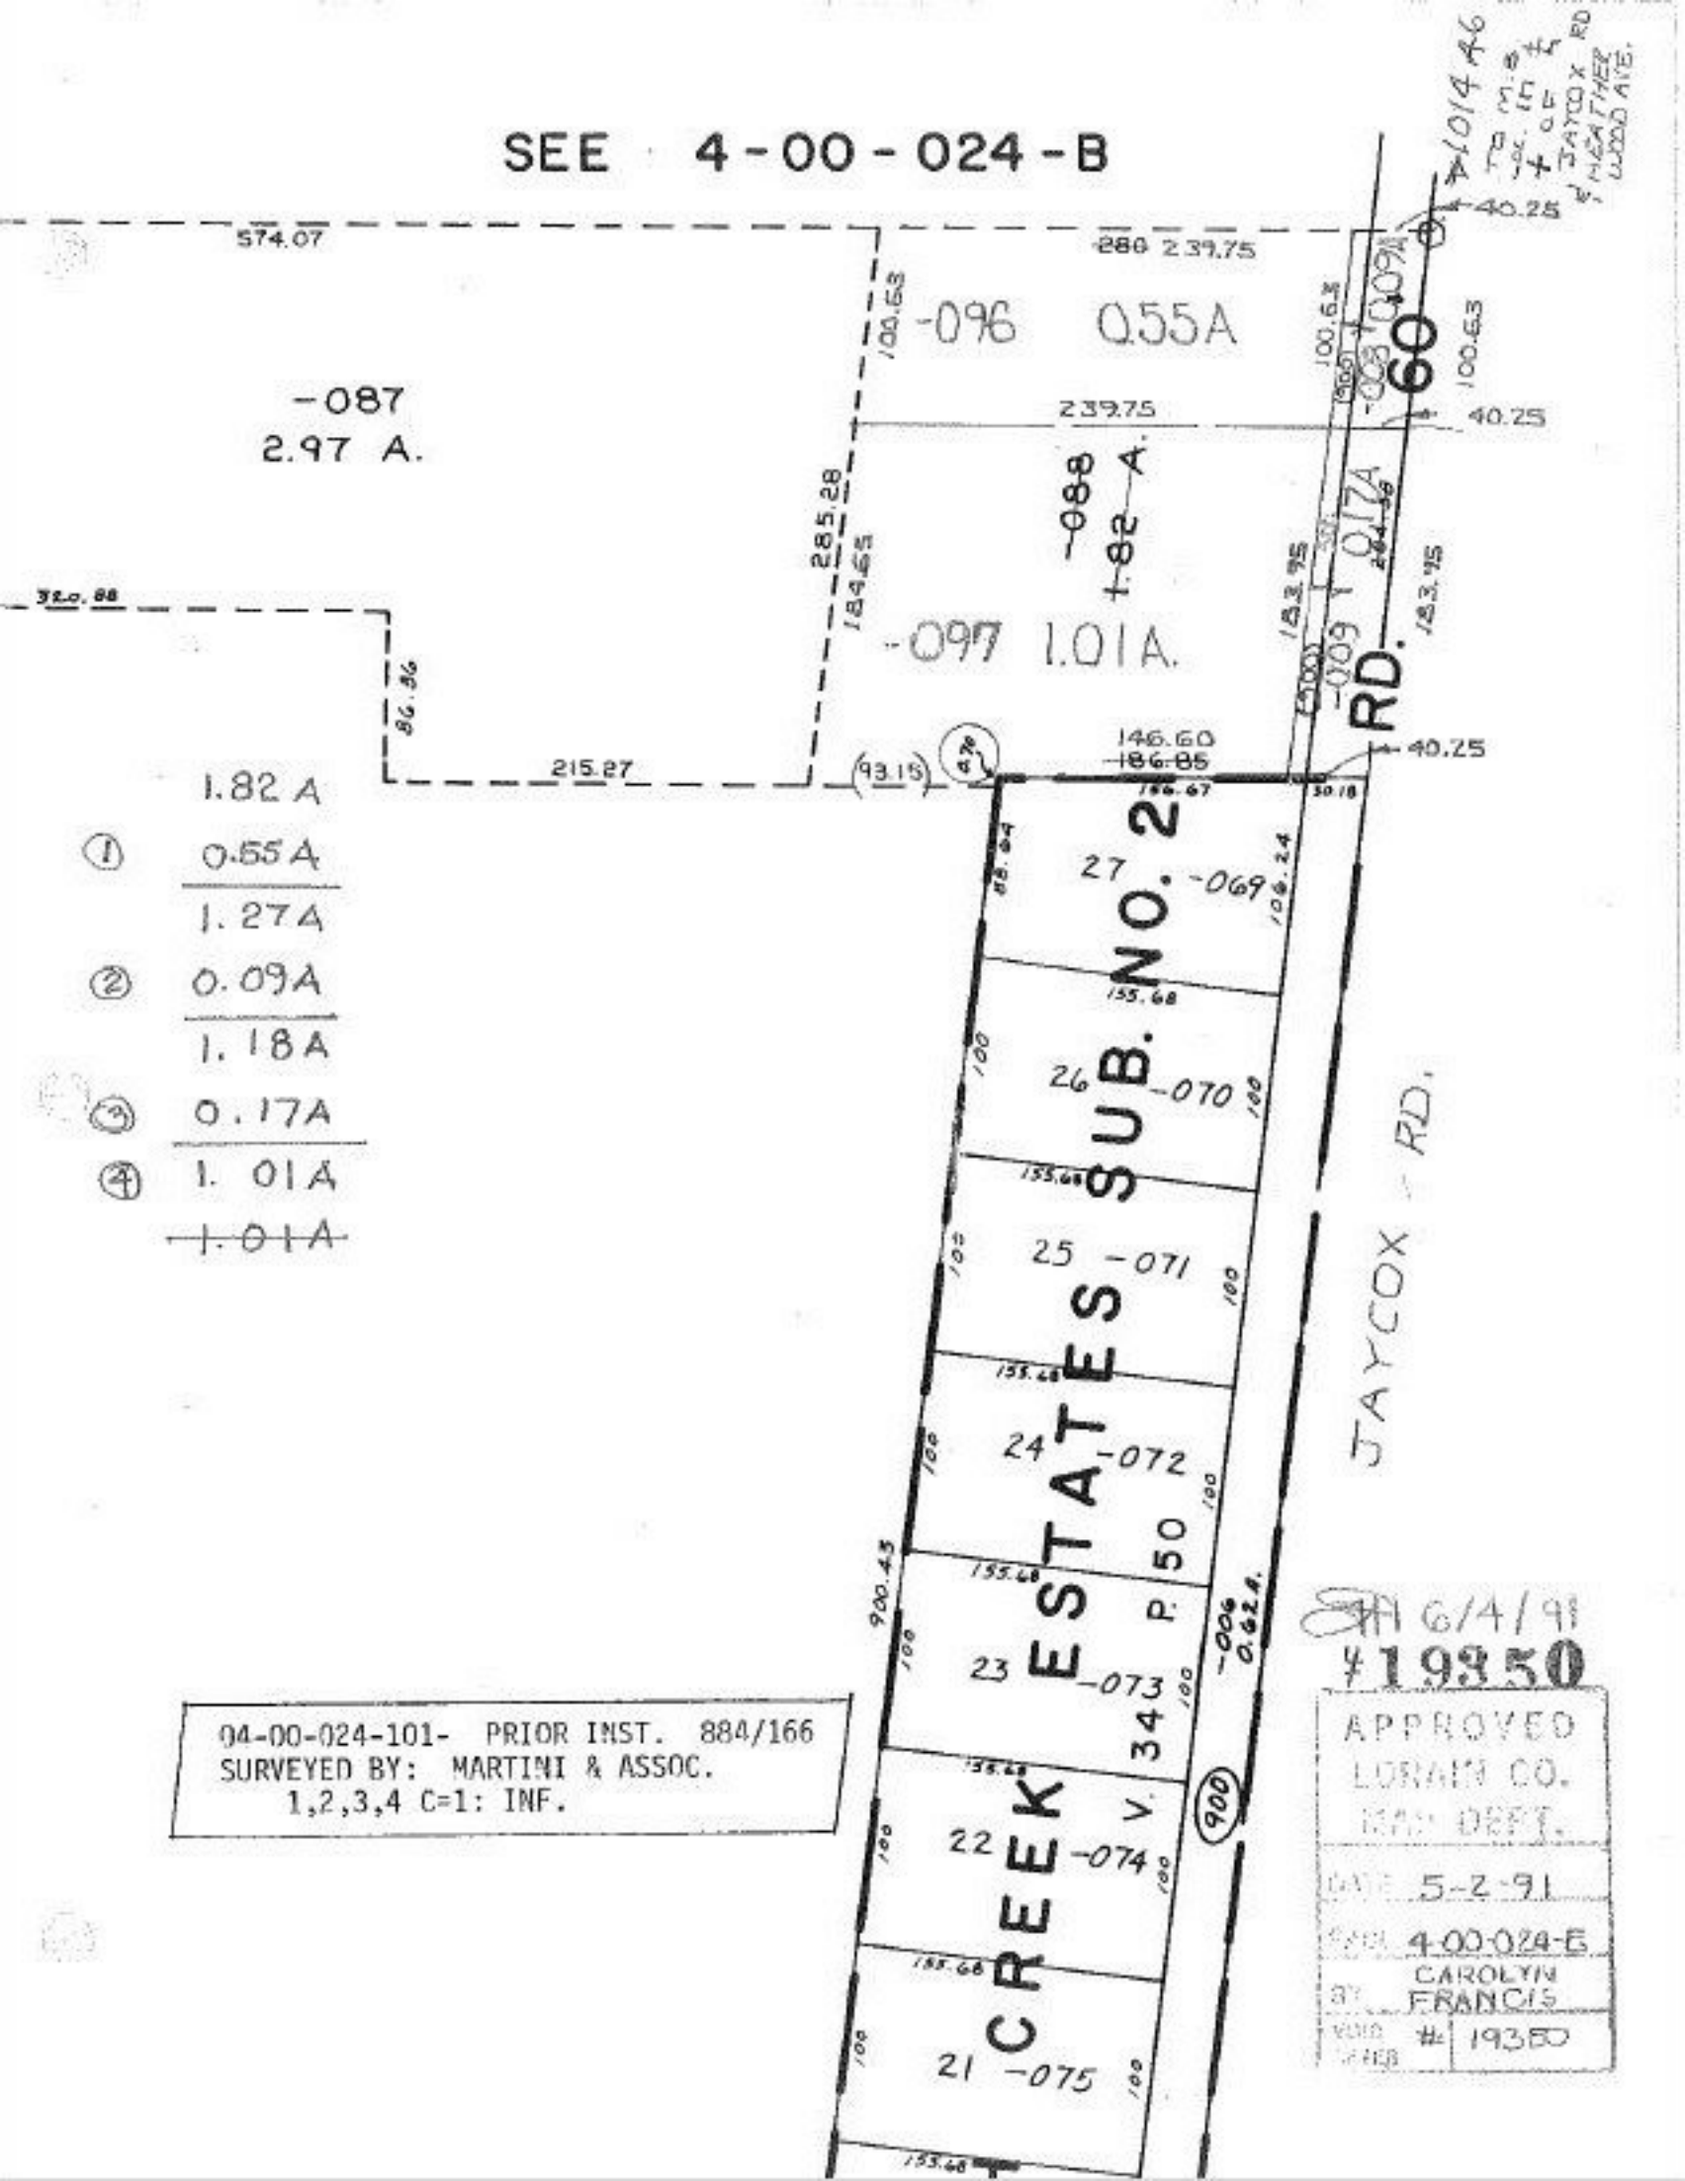
SEE 4-00-024-B
574.07
280 239.75
-096 0.55A
-087
2.97 A.
239.75
-088
1.82 A.
285.28
184.65
-097 1.01A.
320.88
86.36
215.27
146.60
186.85
40.25
1.82 A
① 0.55 A
1.27A
② 0.09A
1.18A
③ 0.17A
④ 1.01A
~~1.01A~~
27 -069
26 -070
25 -071
24 -072
23 -073
22 -074
21 -075
CREEK ESTATES SUB. NO. 2
V. 34 P. 50
900.43
-006 0.62A.
900
JAYCOX RD.
60
RD.
JAYCOX RD & HEATHER WOOD AVE.
1014.46
6/4/91
#19350
APPROVED
LORAIN CO.
MAP DEPT.
DATE 5-2-91
PAGE 4-00-024-E
BY CAROLYN FRANCIS
VOID SEE # 19350
04-00-024-101- PRIOR INST. 884/166
SURVEYED BY: MARTINI & ASSOC.
1,2,3,4 C=1: INF.