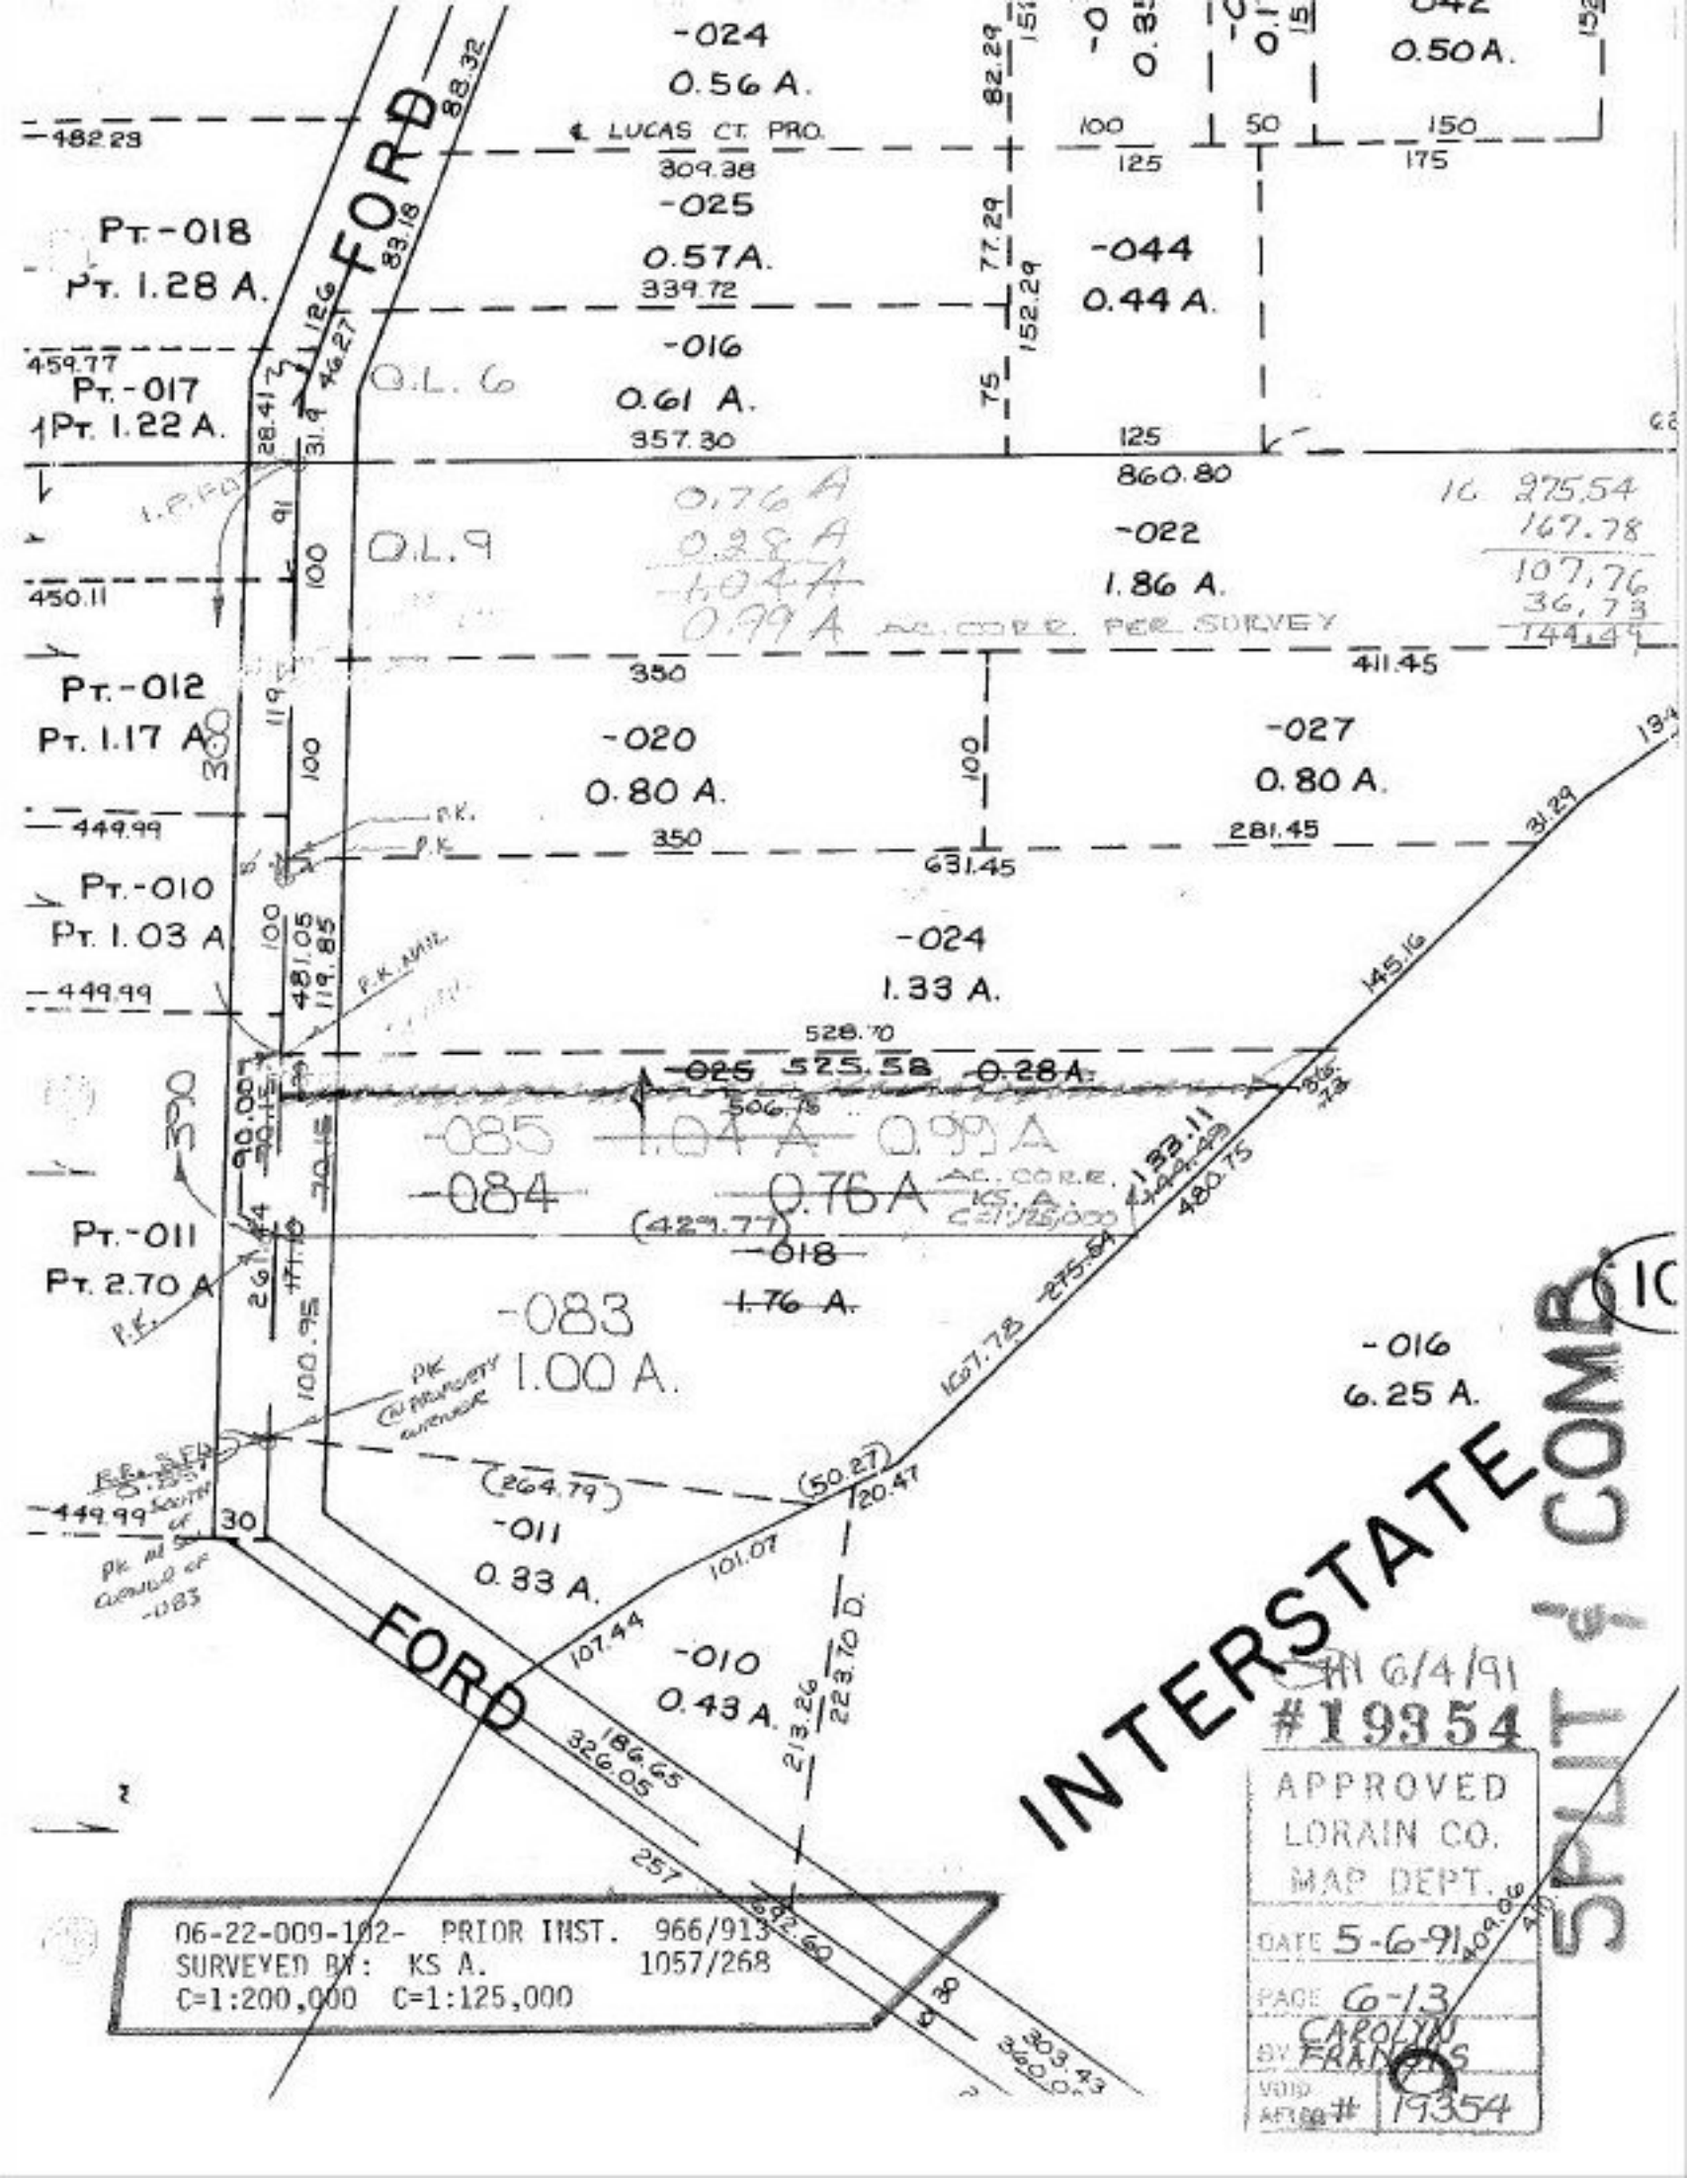
FORD
INTERSTATE
FORD
L. LUCAS CT. PRO.
Pt.-018
Pt. 1.28 A.
Pt.-017
Pt. 1.22 A.
Pt.-012
Pt. 1.17 A.
Pt.-010
Pt. 1.03 A.
Pt.-011
Pt. 2.70 A.
-024
0.56 A.
-025
0.57A.
-016
0.61 A.
-044
0.44 A.
-022
1.86 A.
-027
0.80 A.
-020
0.80 A.
-024
1.33 A.
-085 1.04 A 0.99 A
-084 0.76A
-018
1.76 A.
-083
1.00 A.
-011
0.33 A.
-010
0.43 A.
-016
6.25 A.
0.50A.
0.28A.
0.47A.
0.99 A AC. CORR. PER SURVEY
O.L. 6
O.L. 9
I.P.F.D.
P.K.
P.K. AVAIL.
P.K. on property extension
P.K. 0.2' SOUTH of P.K. in centerline of -083
06-22-009-102- PRIOR INST. 966/913
SURVEYED BY: K.S.A. 1057/268
C=1:200,000 C=1:125,000
SPLIT & COMB
APPROVED
LORAIN CO.
MAP DEPT.
DATE 5-6-91
PAGE 6-13
BY CAROLYN FRANCIS
VOID AFTER # 19354
6/4/91
#19354