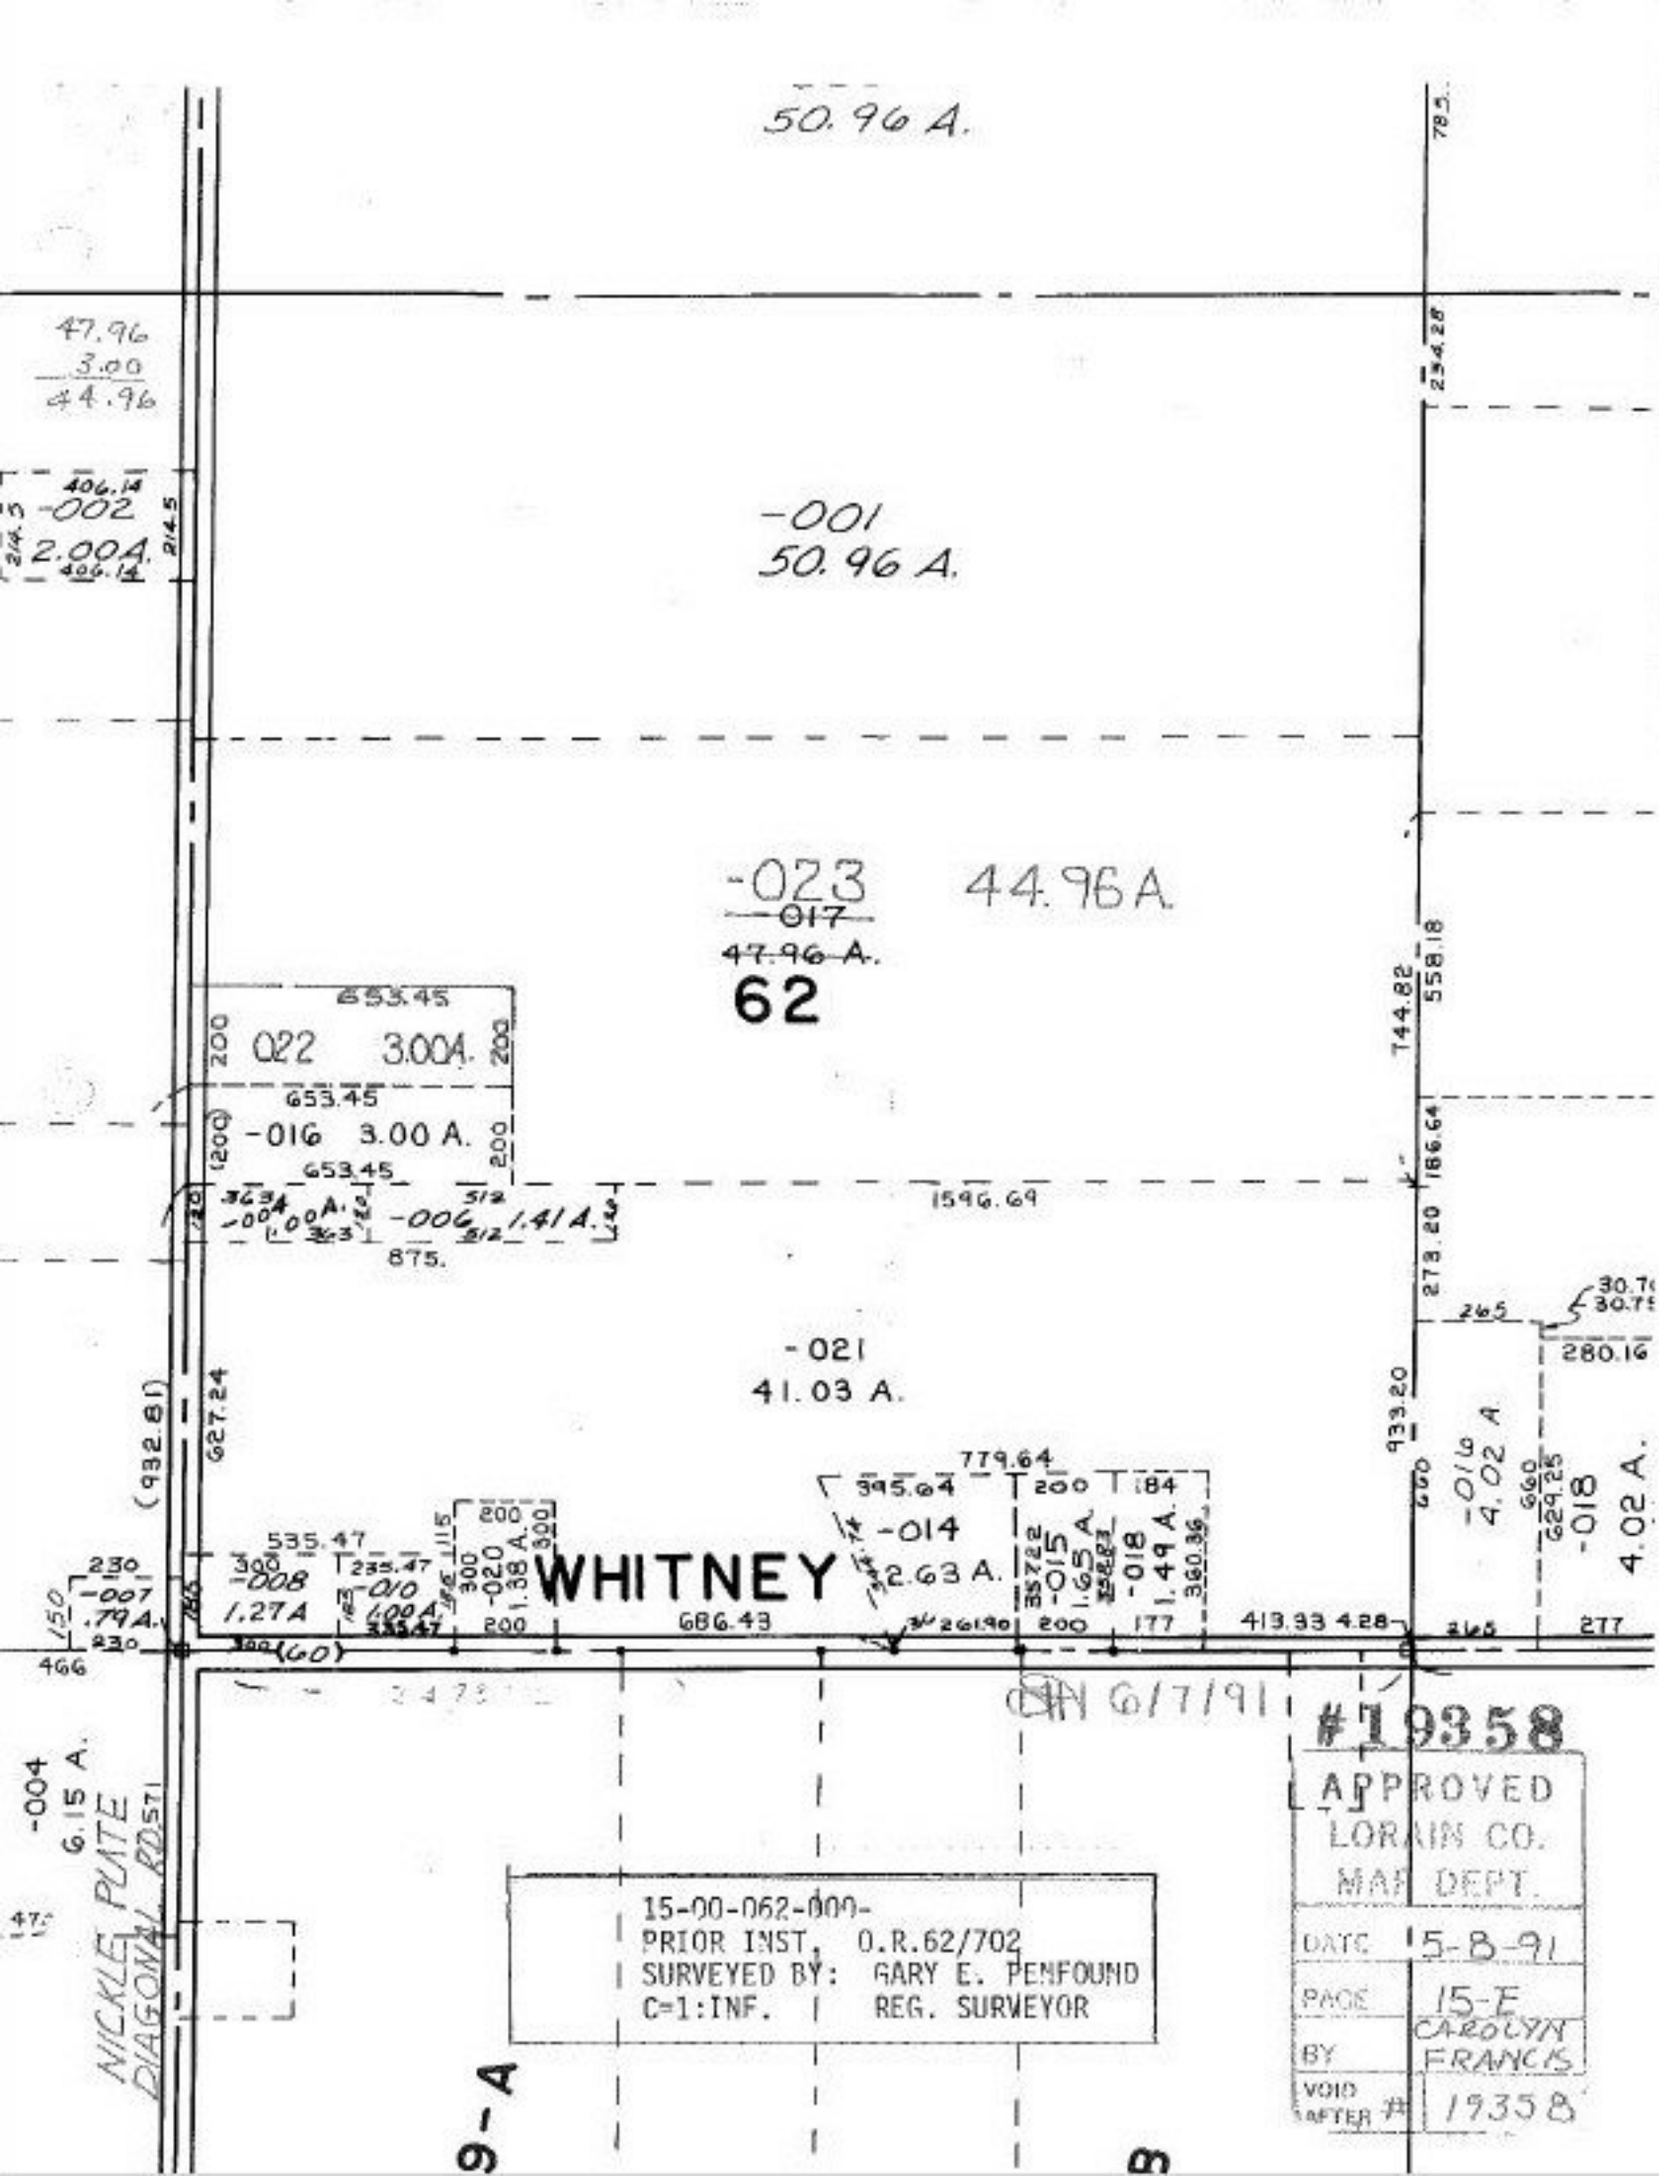
50.96 A.
47.96
3.00
44.96
-001
50.96 A.
-023
-017
47.96 A.
62
44.96A.
022 3.00A.
-016 3.00 A.
-021
41.03 A.
WHITNEY
-014
2.63 A.
-018
1.49 A.
4.02 A.
-004
6.15 A.
NICKLE PLATE DIAGONAL RD.571
15-00-062-000-
PRIOR INST, O.R.62/702
SURVEYED BY: GARY E. PENFOUND
C=1:INF. REG. SURVEYOR
#19358
APPROVED
LORAIN CO.
MAP DEPT.
DATE 5-8-91
PAGE 15-E
BY CAROLYN FRANCIS
VOID AFTER # 19358
6/7/91