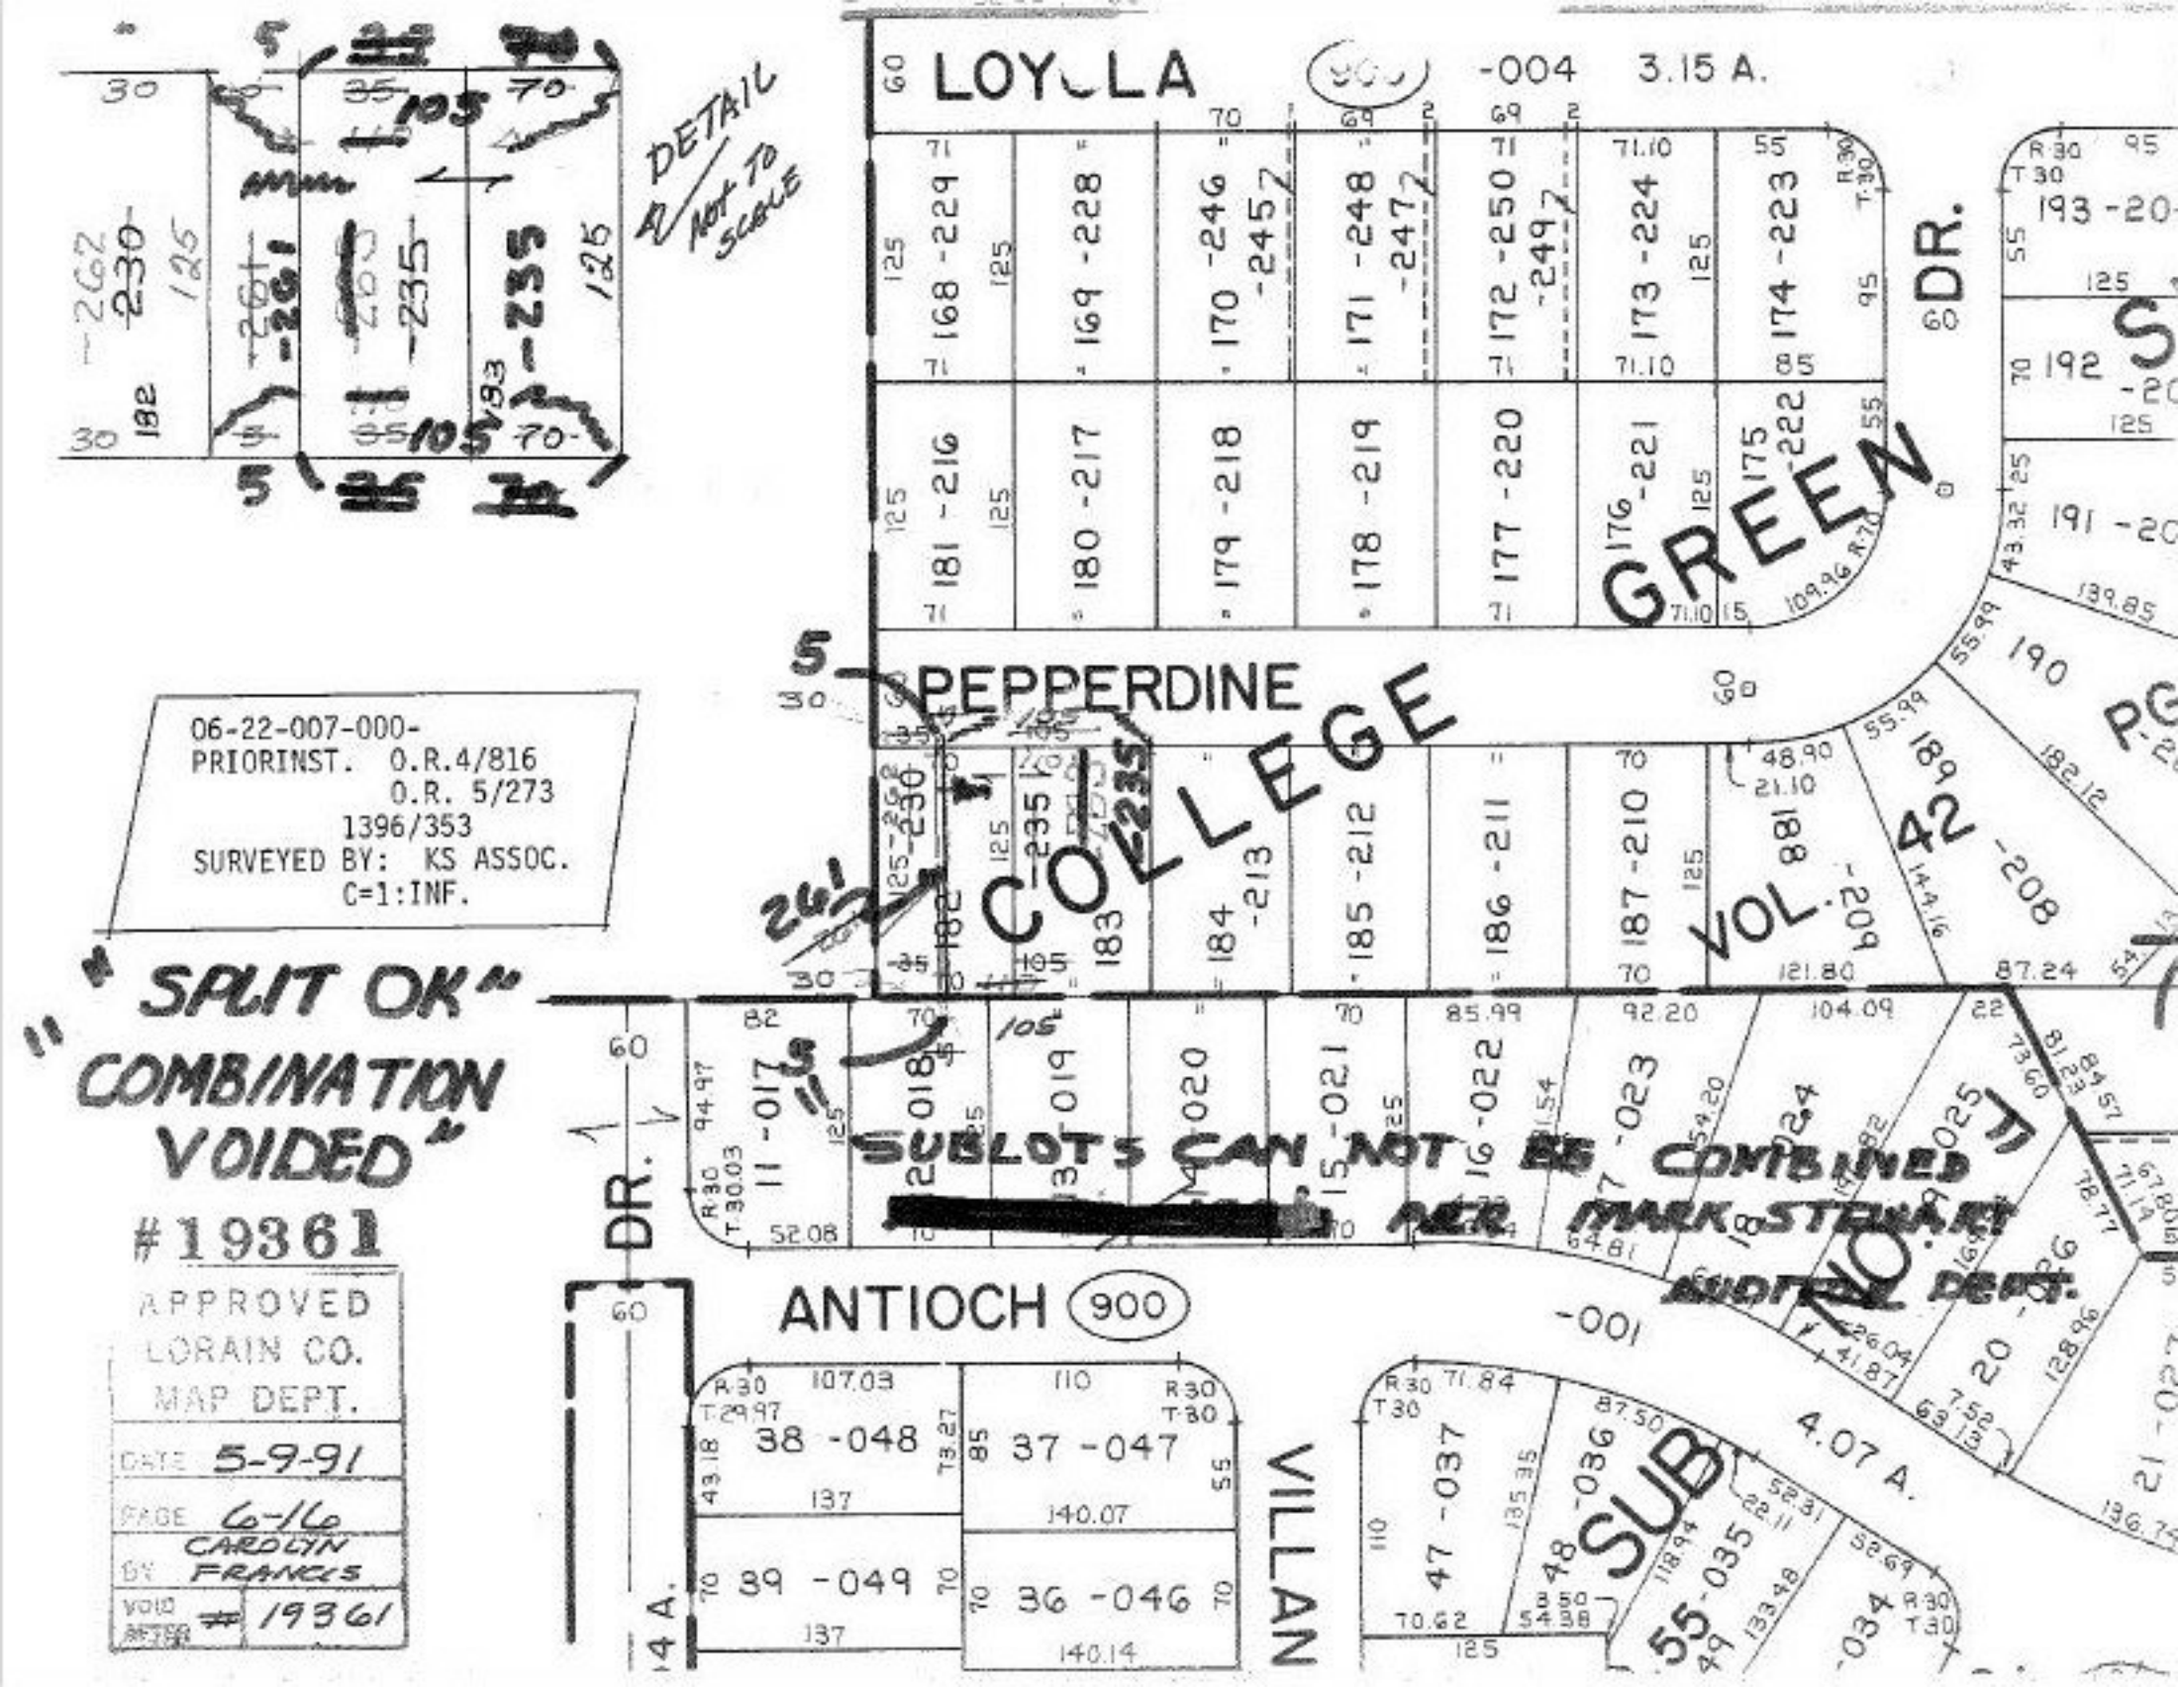

LOYOLA
-004 3.15 A.
PEPPERDINE
COLLEGE
GREEN
DR.
VOL. 42
ANTIOCH 900
VILLAN
SUB
4.07 A.
DETAIL NOT TO SCALE
06-22-007-000-
PRIORINST. O.R.4/816
O.R. 5/273
1396/353
SURVEYED BY: KS ASSOC.
C=1:INF.
"SPLIT OK"
"COMBINATION VOIDED"
#19361
APPROVED
LORAIN CO.
MAP DEPT.
DATE 5-9-91
PAGE 6-16
BY CAROLYN FRANCIS
VOID AFTER # 19361
SUBLOTS CAN NOT BE COMBINED
[redacted] PER MARK STEWART
AUDITOR DEPT.