Pt. 51.88 A.

2.56A
4.60A
7.16A
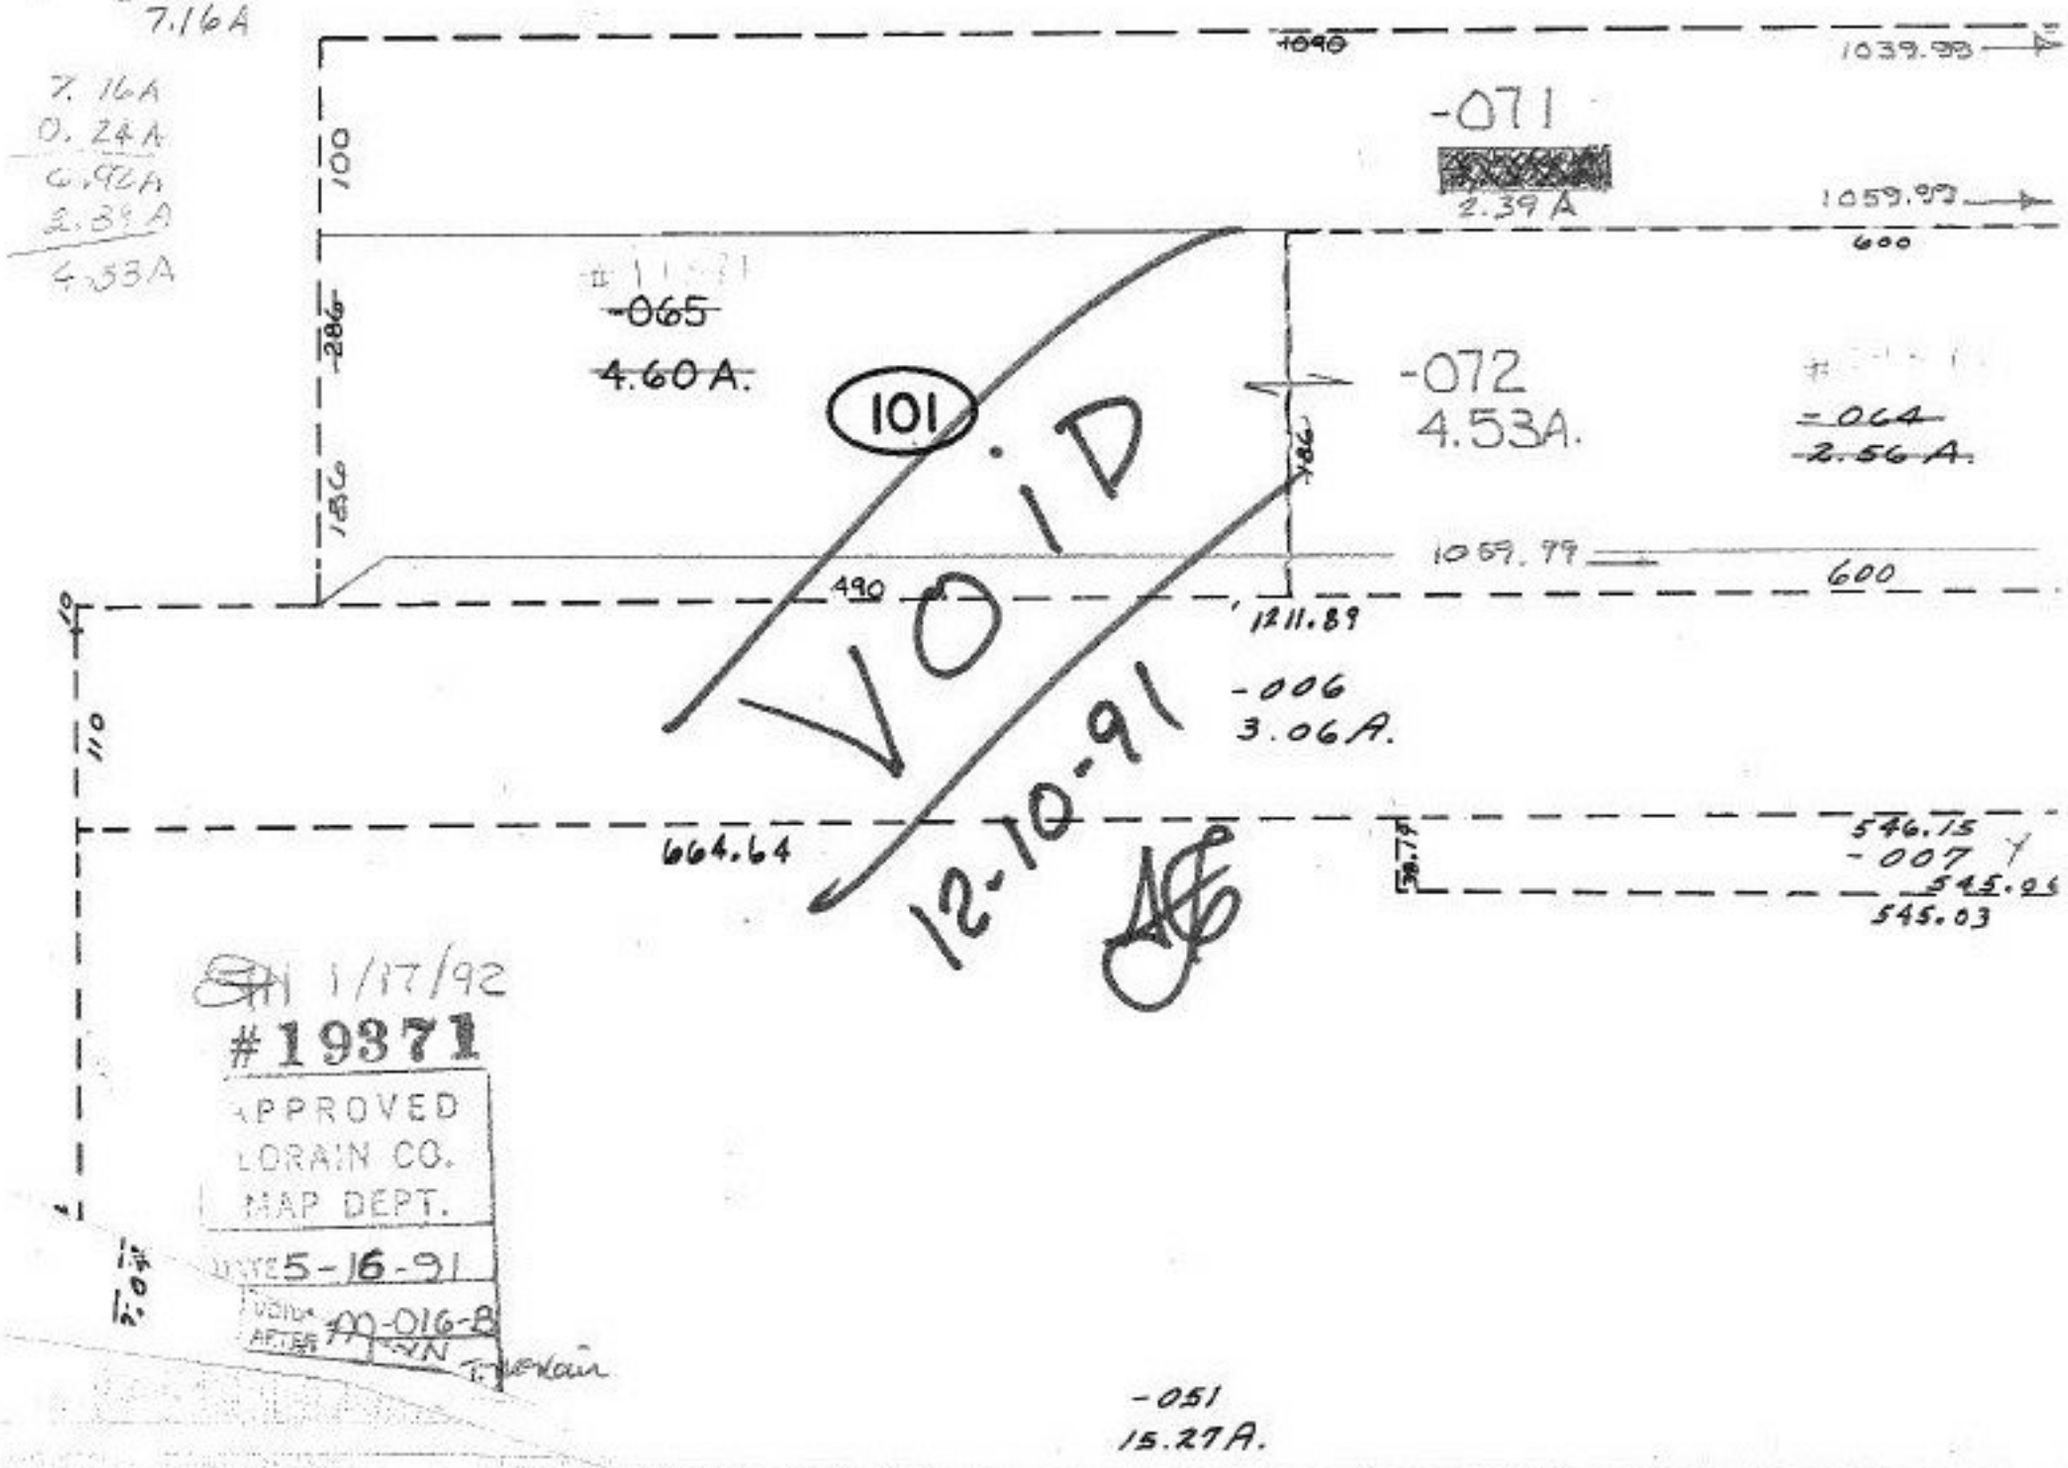
7.16A
0.24A
6.92A
2.39A
4.53A