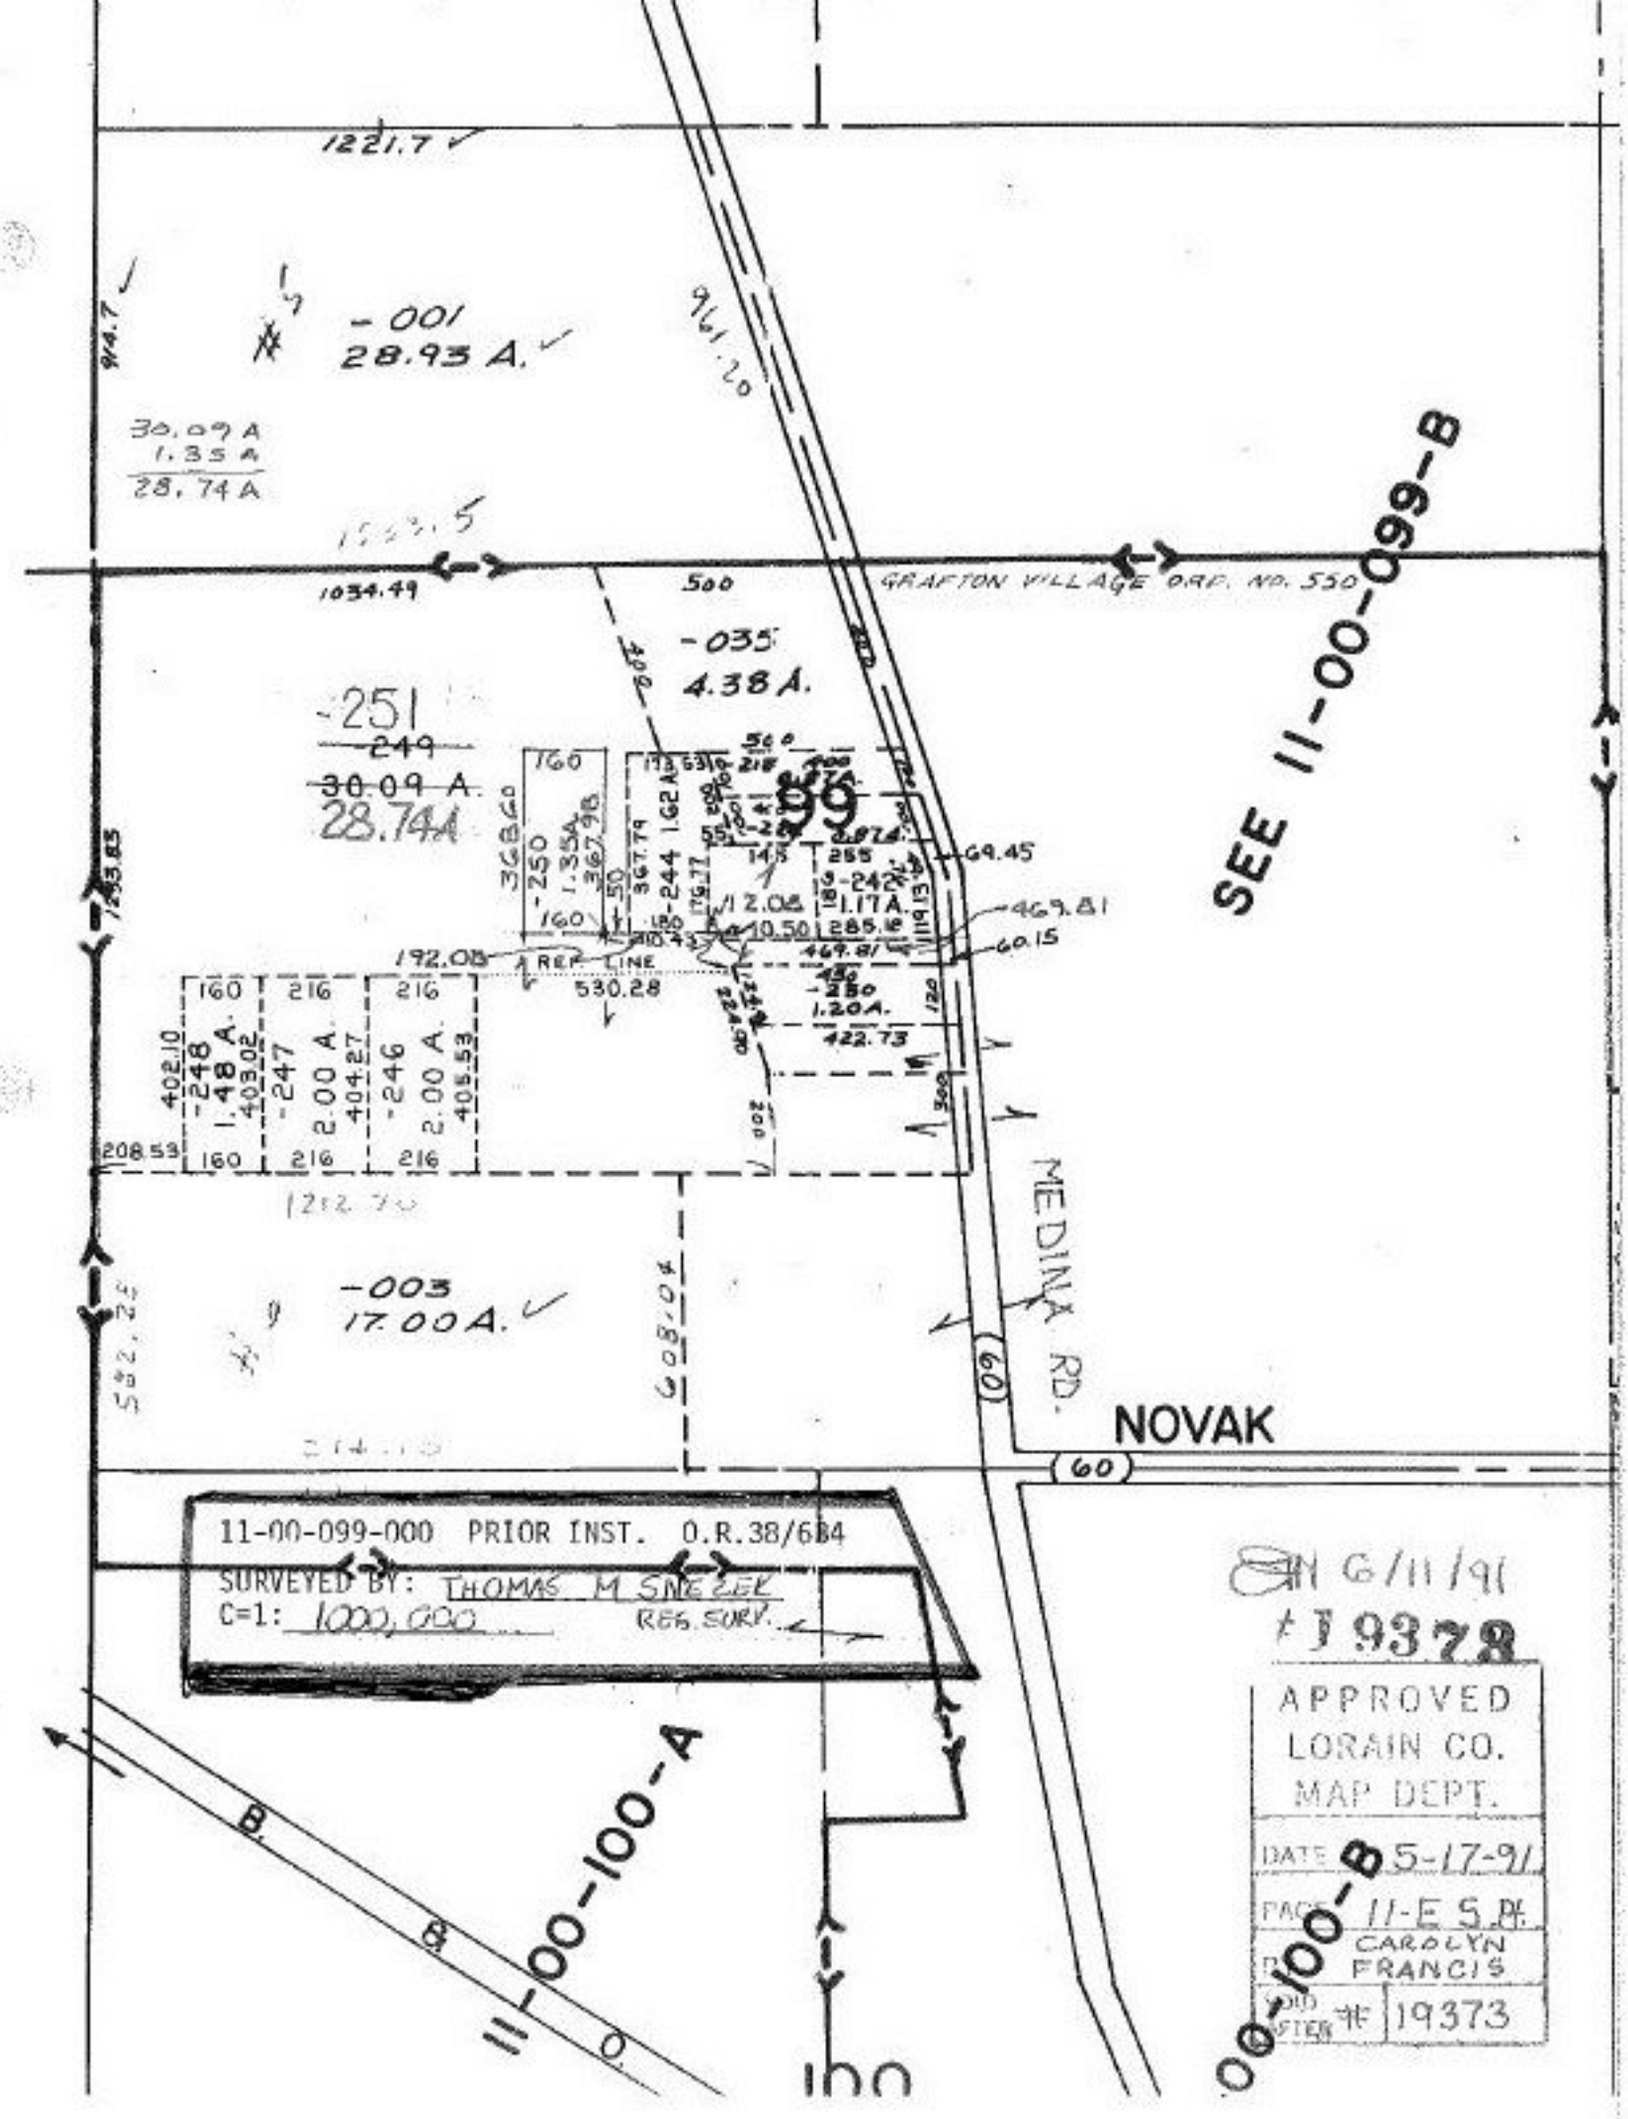
1221.7
-001
28.93 A.
30.09 A
1.35 A
28.74 A
1034.49
500
GRAFTON VILLAGE ORD. NO. 550
-035
4.38 A.
-251
-249
30.09 A.
28.74A
99
SEE 11-00-099-B
69.45
469.81
60.15
192.08
REF. LINE
530.28
-250
1.20A.
422.73
-248
1.48 A.
-247
2.00 A.
-246
2.00 A.
208.53
-003
17.00A.
MEDINA RD.
NOVAK
60
11-00-099-000 PRIOR INST. O.R.38/684
SURVEYED BY: THOMAS M SNEZEK
C=1: 1000,000
REG. SURV.
11-00-100-A
B.
B.
O.
100
6/11/91
#19378
APPROVED
LORAIN CO.
MAP DEPT.
DATE 5-17-91
PAGE 11-E S.Pt.
CAROLYN FRANCIS
SOLD AFTER # 19373