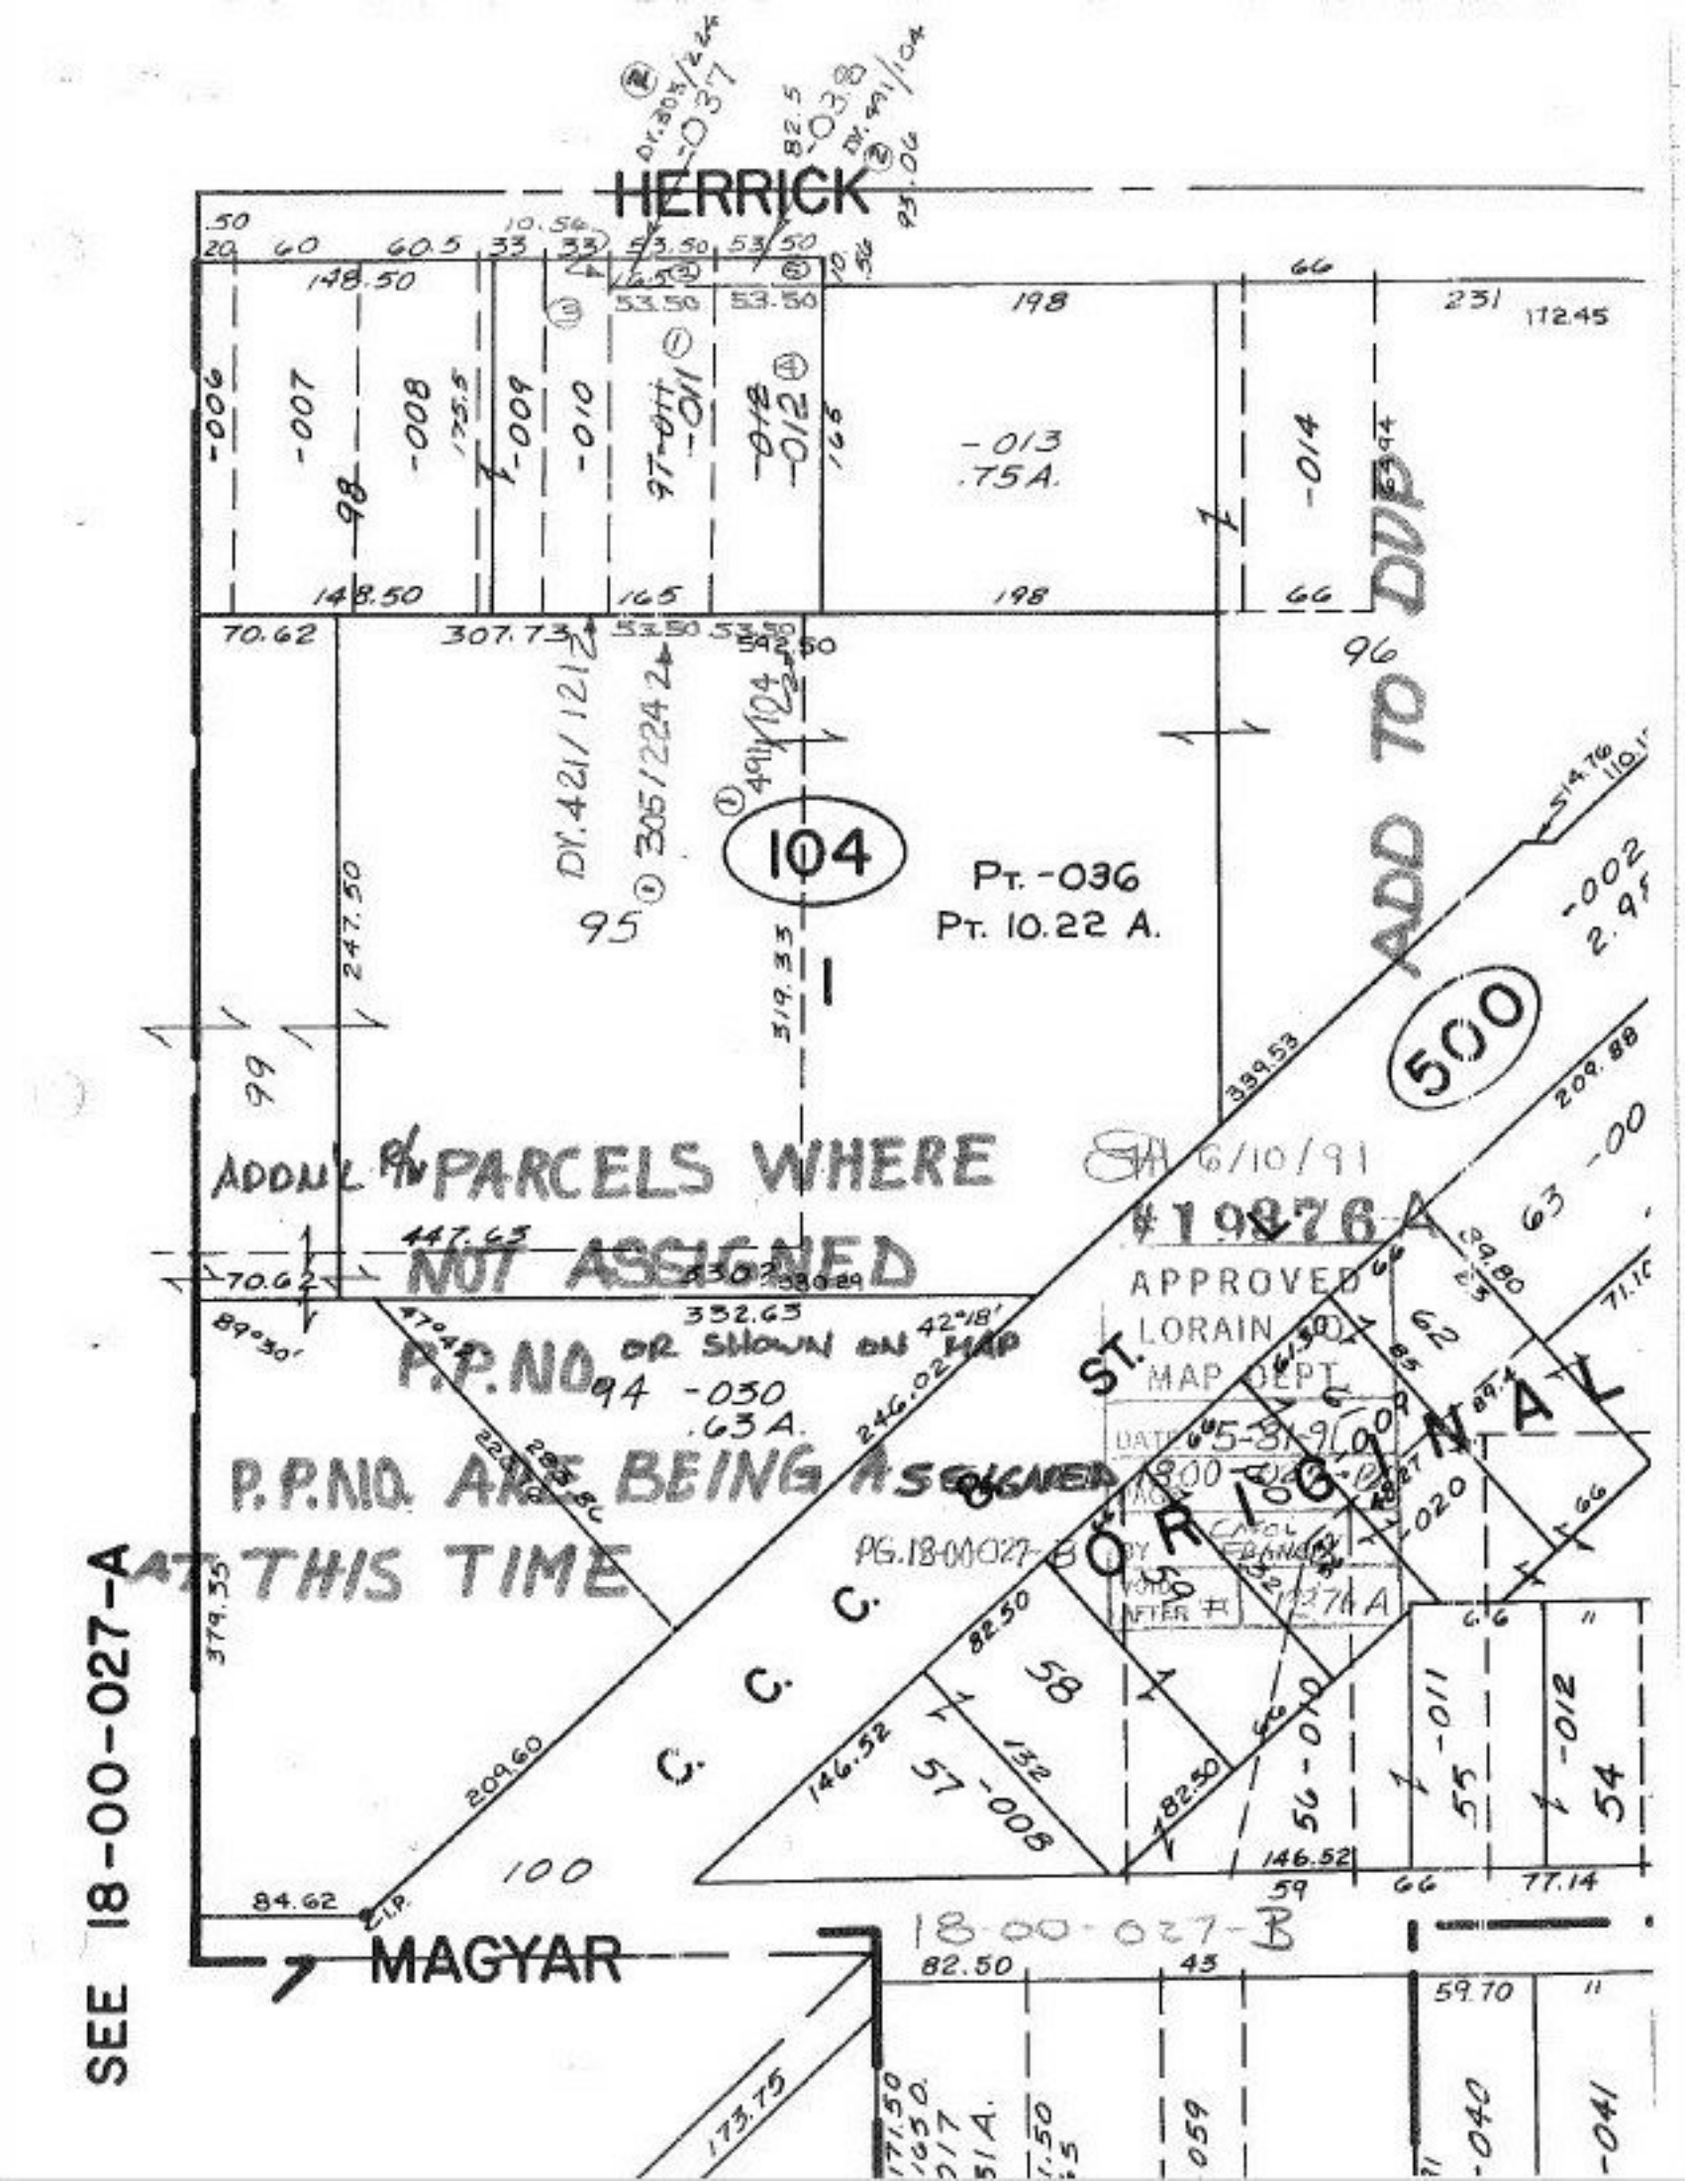
HERRICK
MAGYAR
104
Pt. -036
Pt. 10.22 A.
ADD TO DUP
500
ADDN'L PARCELS WHERE NOT ASSIGNED P.P.NO. OR SHOWN ON MAP
P.P.NO. ARE BEING ASSIGNED AT THIS TIME
6/10/91
#19876 A
APPROVED
LORAIN CO.
MAP DEPT.
DATE 5-31-91
ORIGINAL
C. C. C. ST.
PG. 18-00-027-B
18-00-027-B
SEE 18-00-027-A