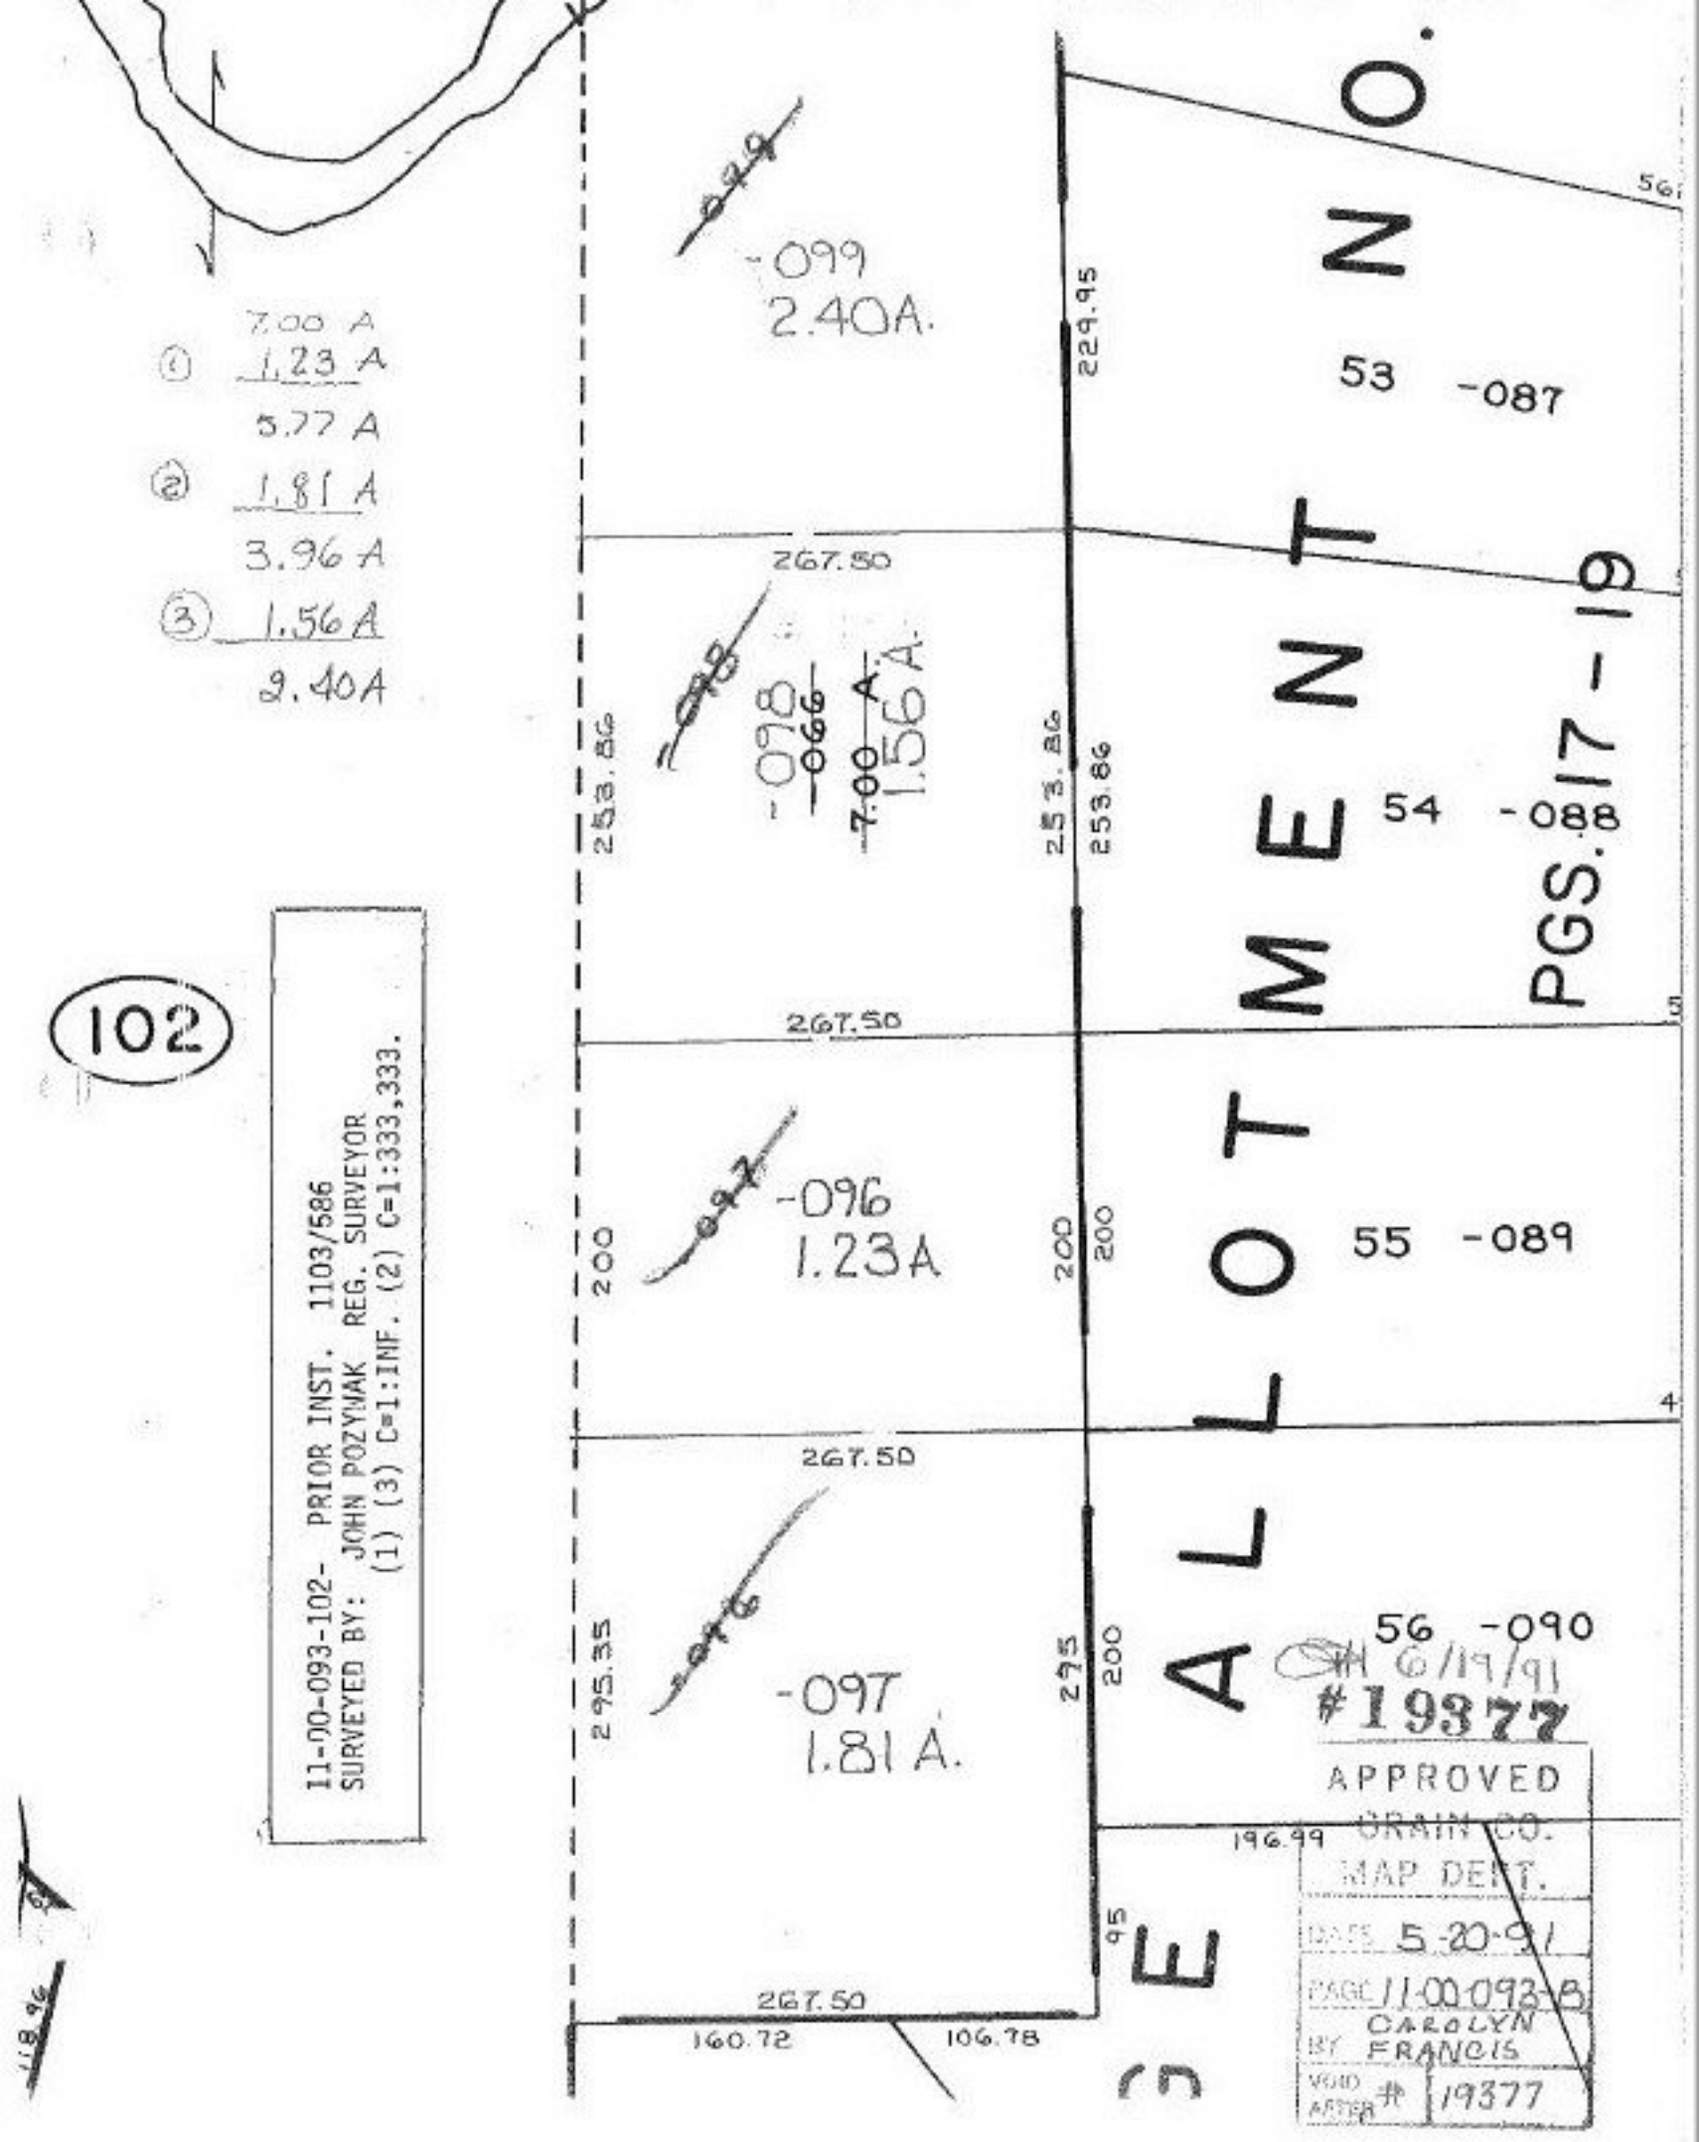

7.00 A
① 1.23 A
5.77 A
② 1.81 A
3.96 A
③ 1.56 A
2.40 A
102
11-00-093-102- PRIOR INST. 1103/586
SURVEYED BY: JOHN POZYWAK REG. SURVEYOR
(1) (3) C=1:INF. (2) C=1:333,333.
-099
2.40A.
53 -087
267.50
-098
-066
7.00 A
1.56 A
253.86
54 -088
PGS. 17-19
267.50
-096
1.23A
200
55 -089
267.50
-097
1.81 A.
295.35
56 -090
6/19/91
#19377
APPROVED
GRAIN CO.
MAP DEPT.
DATE 5-20-91
PAGE 11-00-093-B
BY CAROLYN FRANCIS
VOID AFTER # 19377
196.99
95
267.50
160.72
106.78
ALLOTMENT NO.