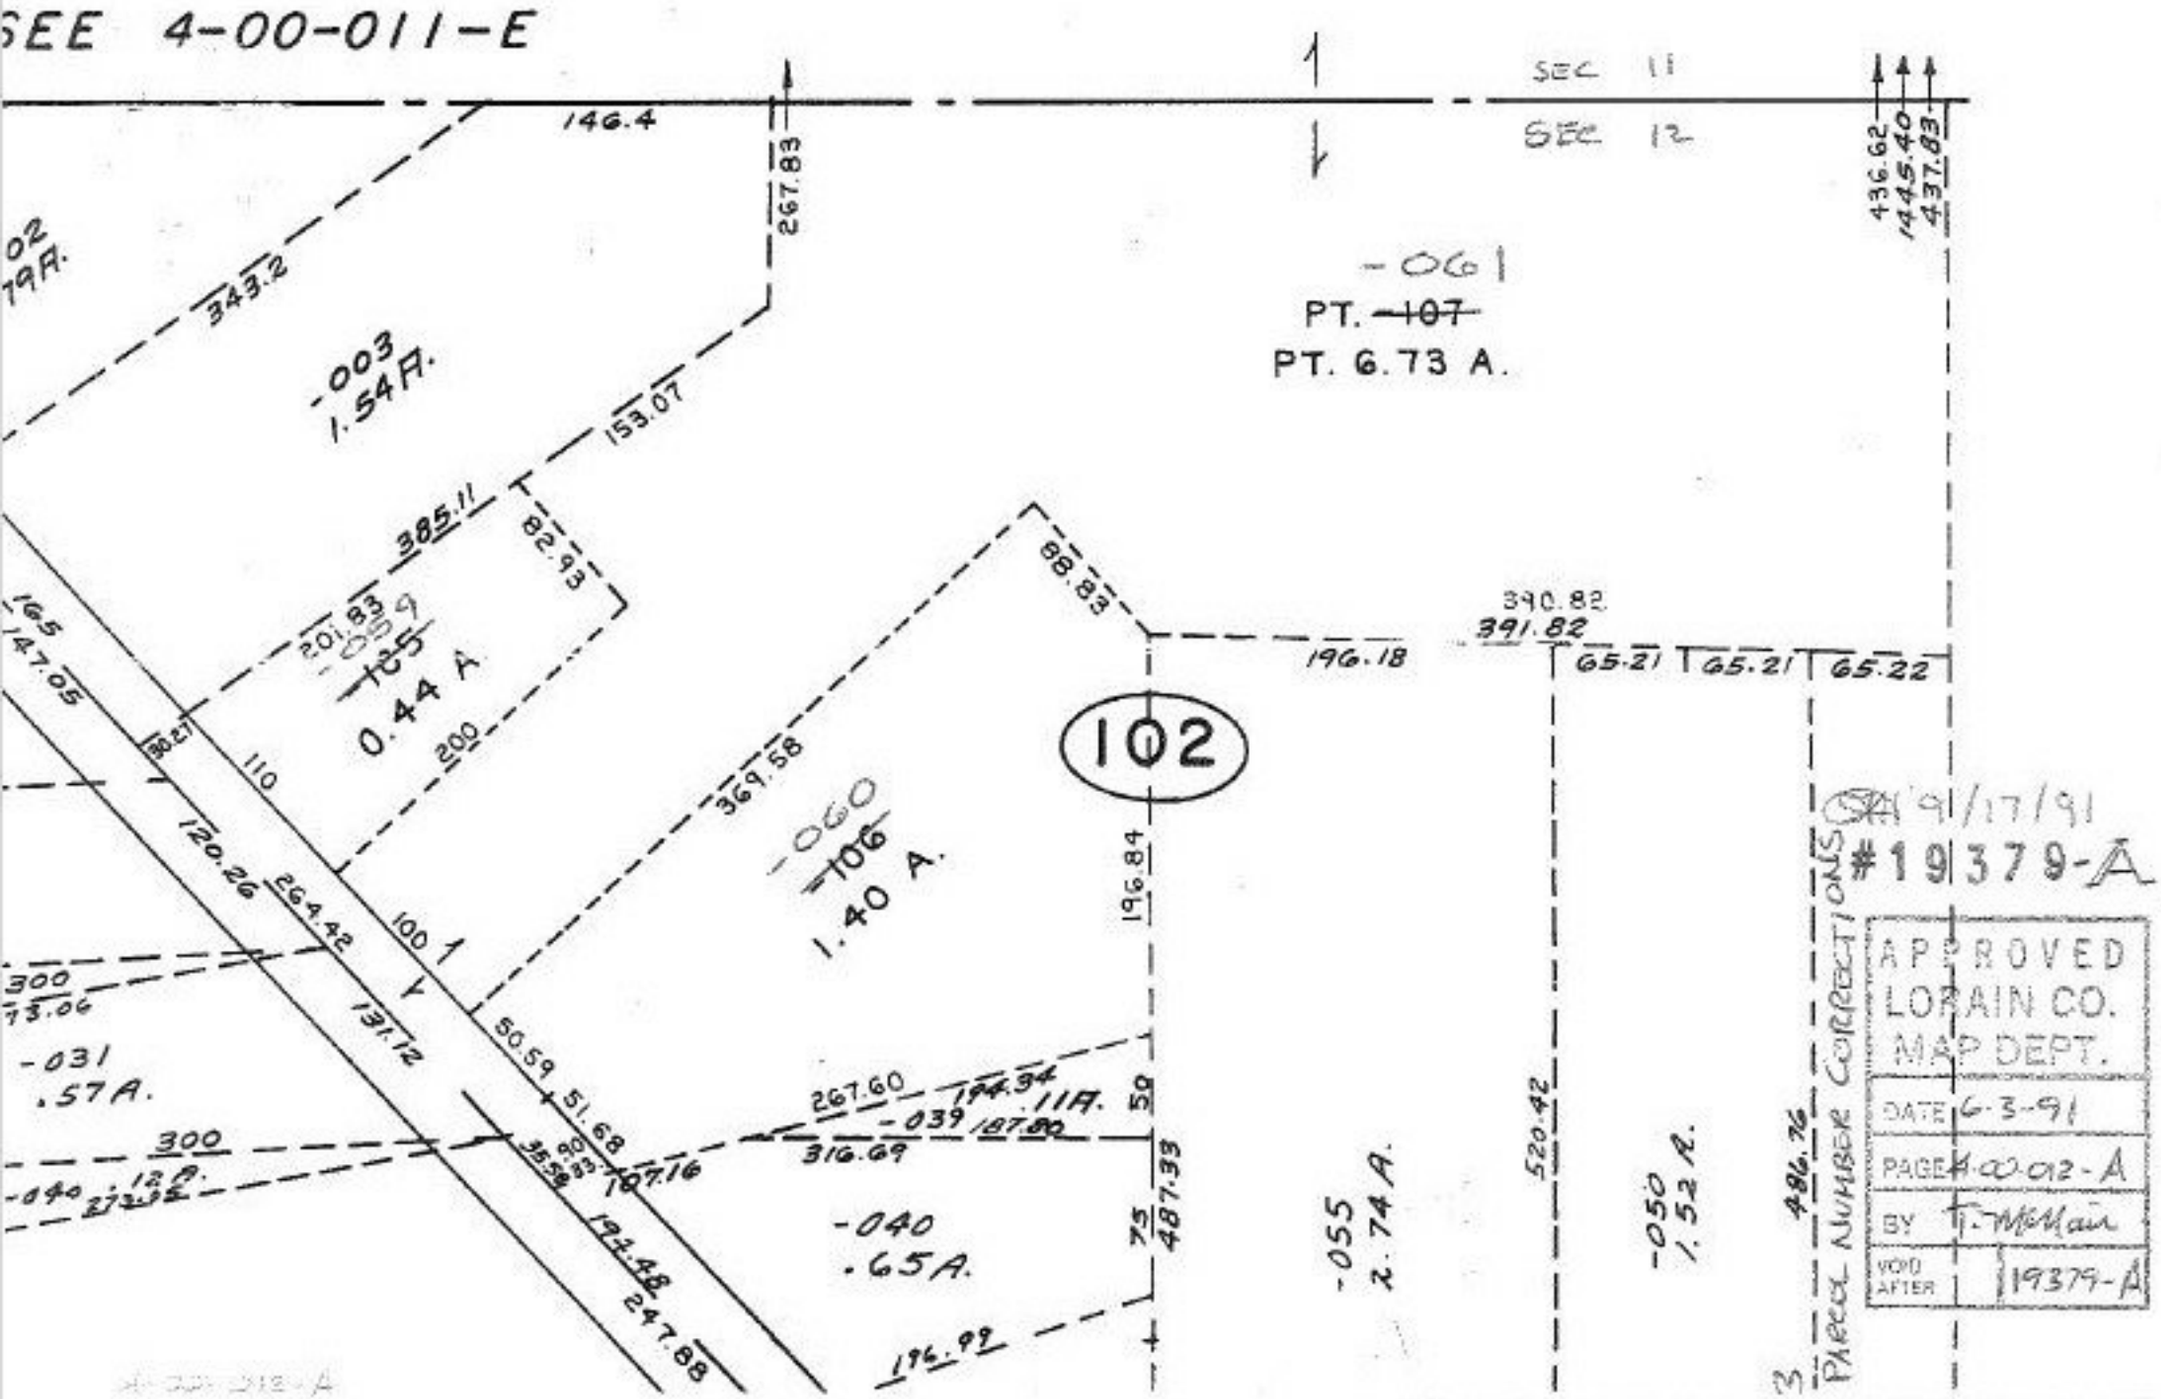
SEE 4-00-011-E
SEC 11
SEC 12
146.4
267.83
436.62
1445.40
437.83
-061
PT. ~~107~~
PT. 6.73 A.
343.2
-003
1.54A.
153.07
385.11
82.93
201.83
-059
~~105~~
0.44 A
200
88.83
390.82
391.82
196.18
65.21
65.21
65.22
102
369.58
-060
~~106~~
1.40 A.
196.84
110
120.26
264.42
100
131.12
50.59
51.68
267.60
194.34
.11A.
-039
187.80
316.69
107.16
-031
.57A.
300
-040
.12A.
194.48
247.88
-040
.65A.
196.99
487.33
-055
2.74 A.
520.42
-050
1.52 A.
486.76
PARCEL NUMBER CORRECTIONS
3
9/17/91
#19379-A
APPROVED
LORAIN CO.
MAP DEPT.
DATE 6-3-91
PAGE 4-00-012-A
BY T. McMain
VOID AFTER 19379-A