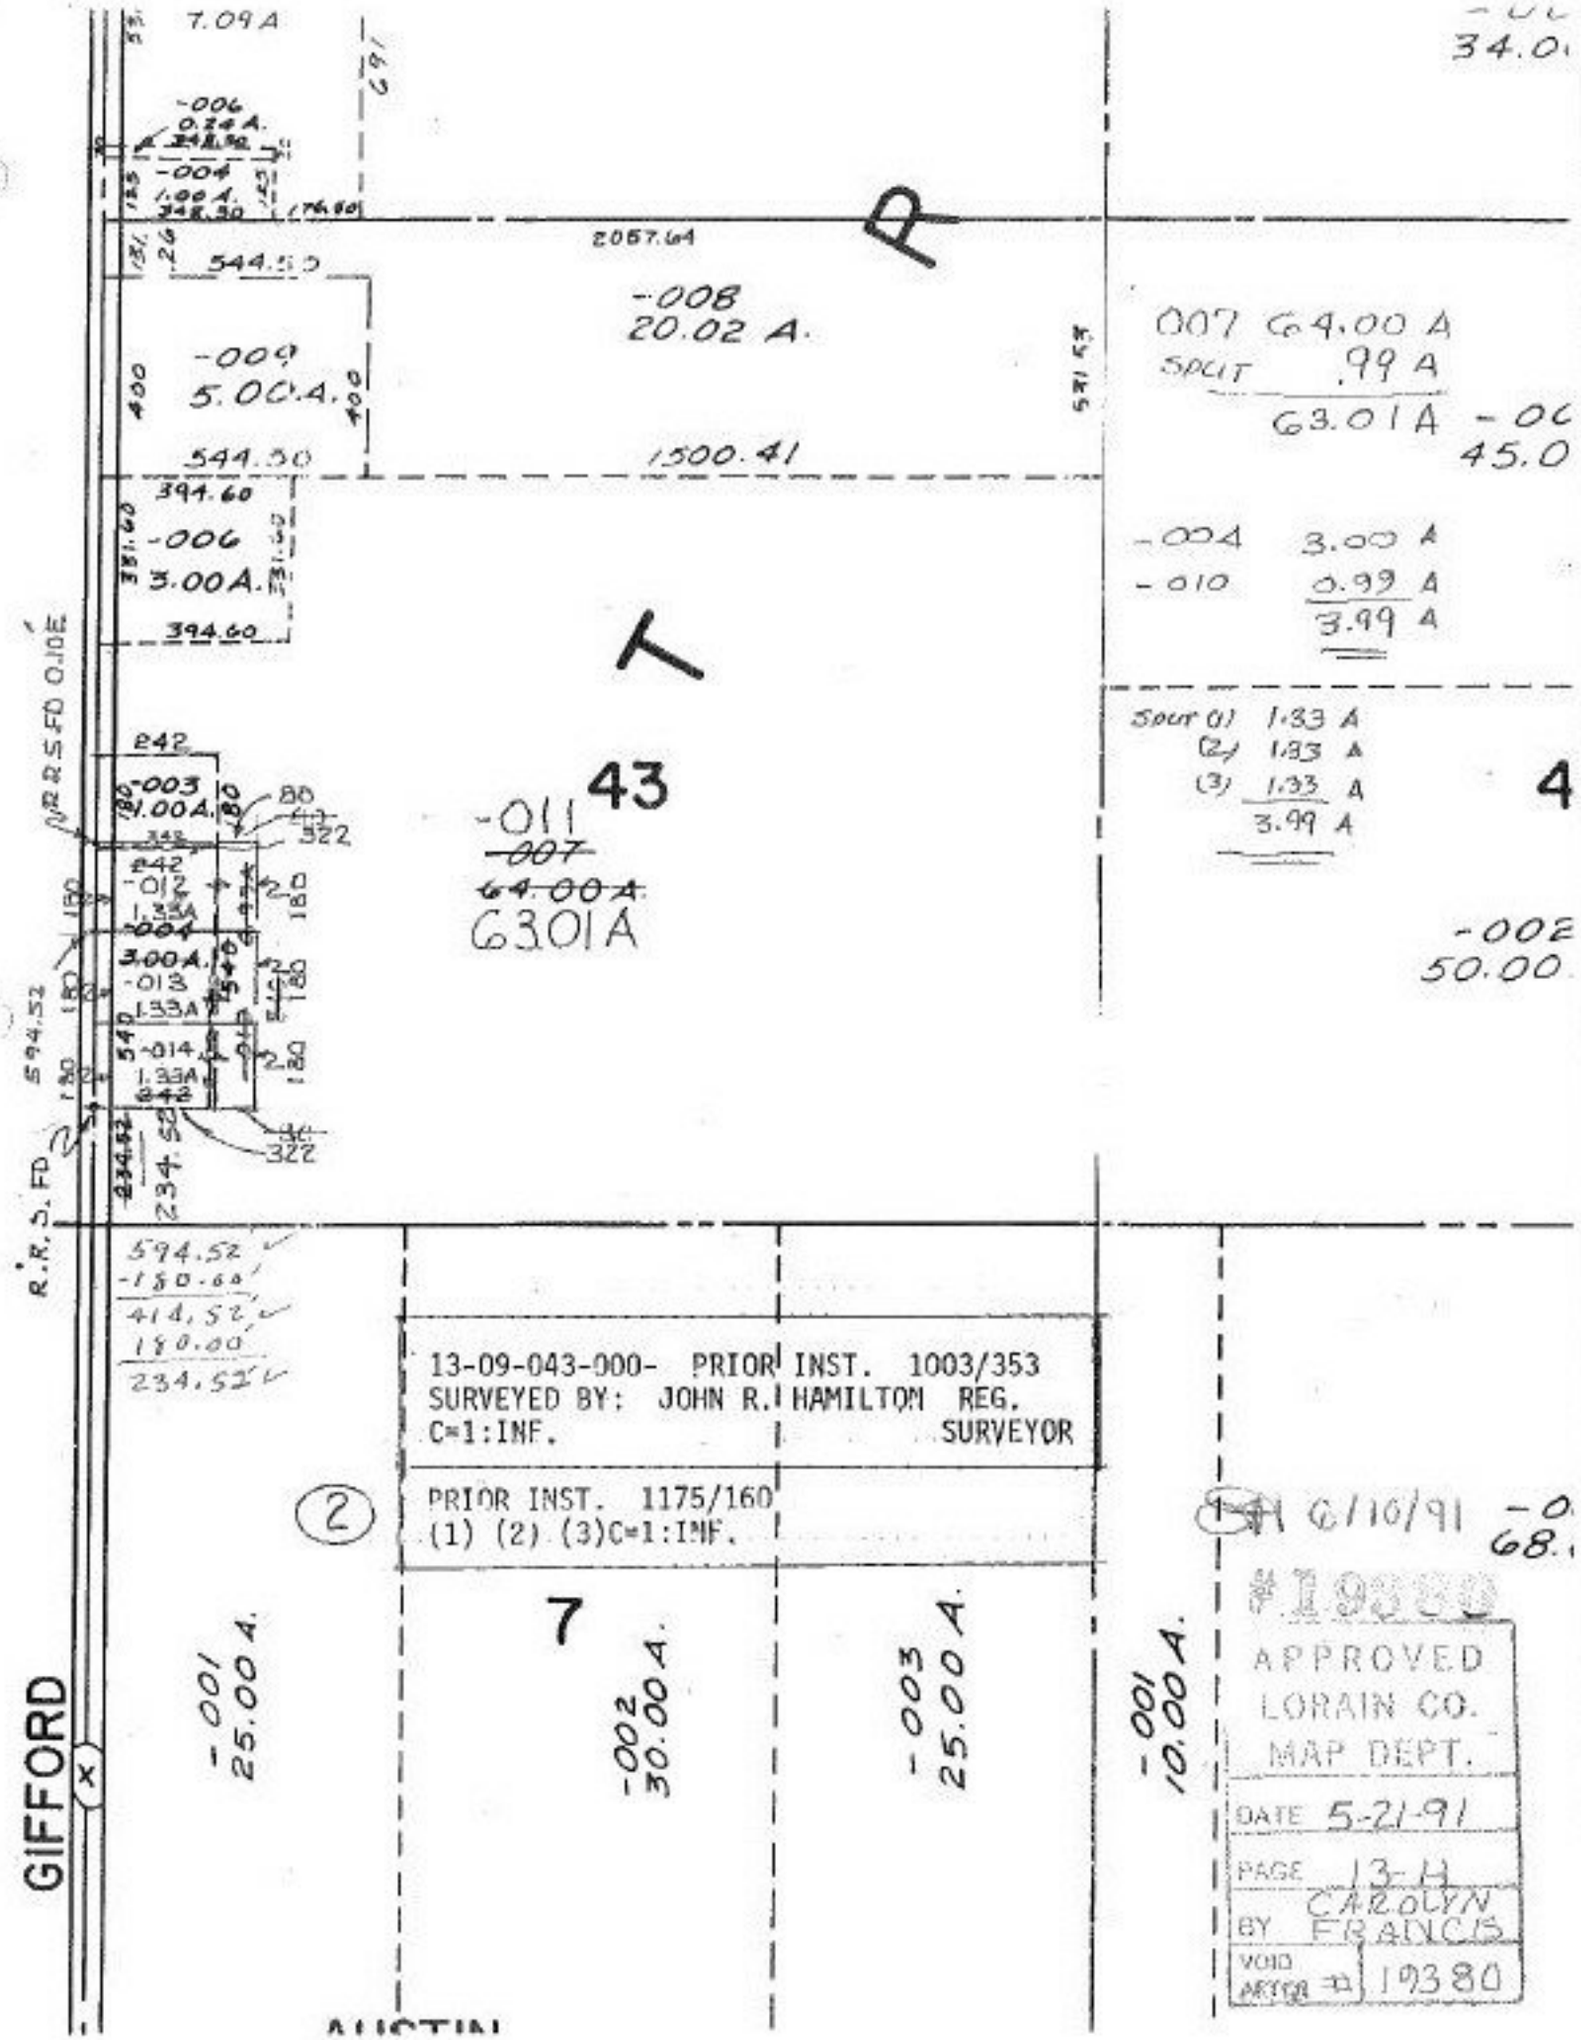

7.09 A
-006
0.24 A.
-004
1.00 A.
2057.64
544.50
-008
20.02 A.
-009
5.00 A.
544.50
1500.41
394.60
-006
3.00 A.
394.60
007 64.00 A
SPLIT .99 A
63.01 A
-004 3.00 A
-010 0.99 A
3.99 A
SPLIT (1) 1.33 A
(2) 1.33 A
(3) 1.33 A
3.99 A
43
-011
~~-007~~
~~64.00 A.~~
63.01 A
-002
50.00
242
-003
1.00 A.
-012
1.33 A
-004
3.00 A.
-013
1.33 A
-014
1.33 A
R.R.S. FD
594.52
-180.00
414.52
180.00
234.52
13-09-043-000- PRIOR INST. 1003/353
SURVEYED BY: JOHN R. HAMILTON REG.
C=1:INF. SURVEYOR
PRIOR INST. 1175/160
(1) (2) (3)C=1:INF.
2
7
-001
25.00 A.
-002
30.00 A.
-003
25.00 A.
-001
10.00 A.
6/10/91
GIFFORD
AUSTIN
APPROVED
LORAIN CO.
MAP DEPT.
DATE 5-21-91
PAGE 13-H
BY CAROLYN FRANCIS
VOID AFTER # 19380