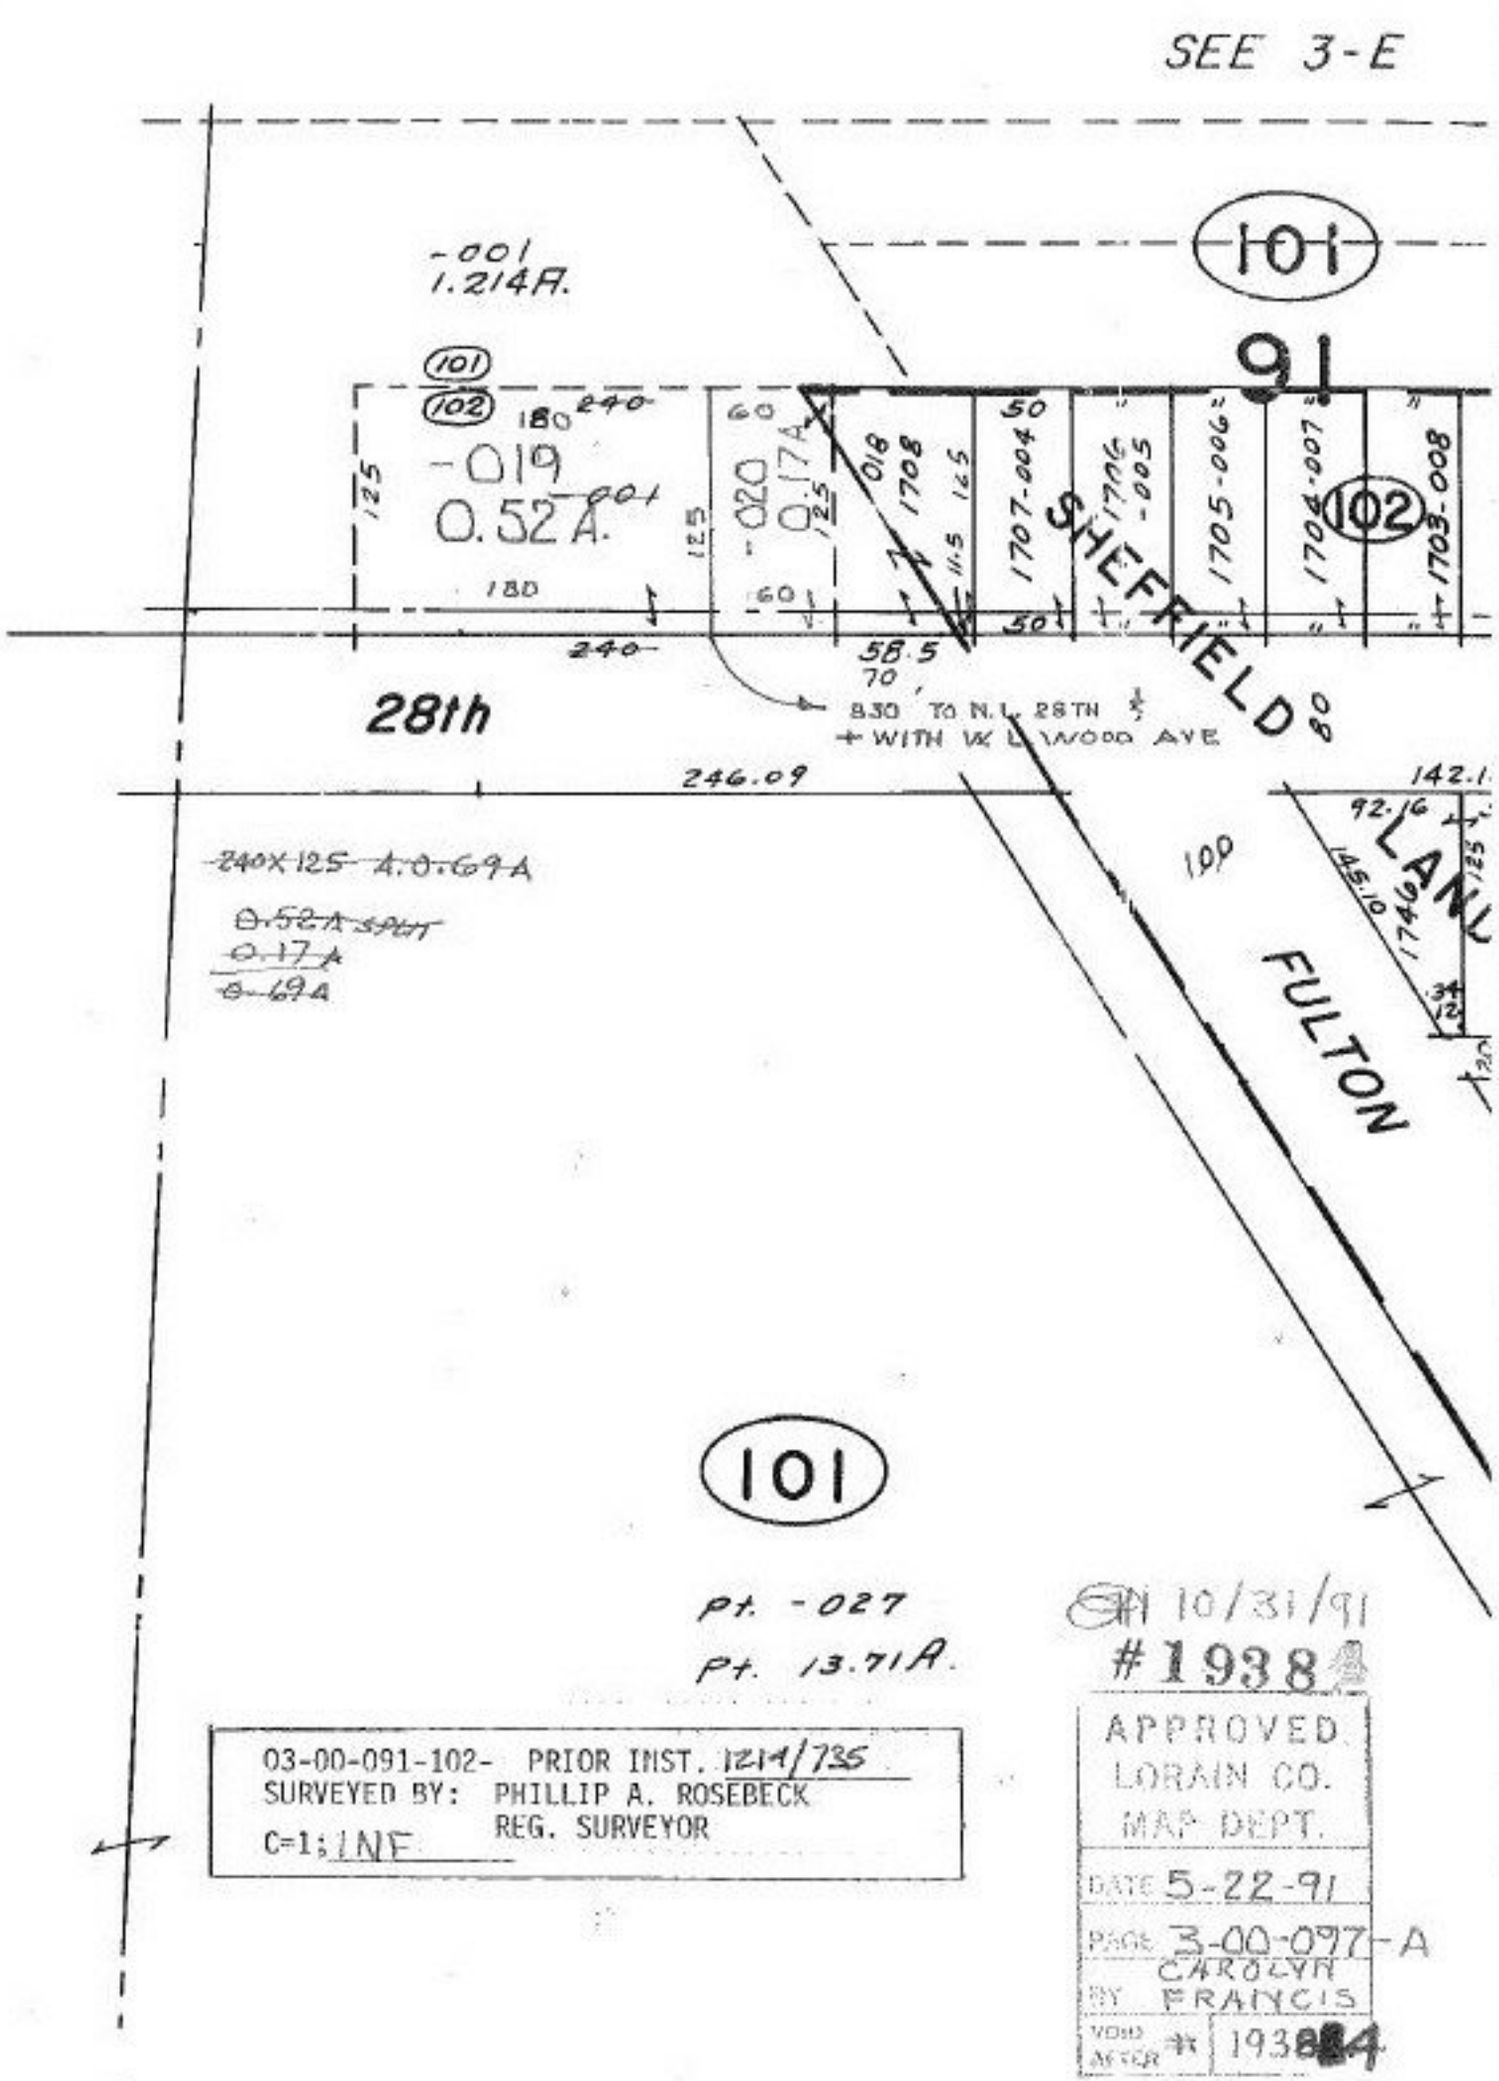
SEE 3-E
101
91
-001
1.214A.
101
102
180
240
-019
0.52A.
-001
125
180
240
-020
0.17A
125
60
60
018
1708
115
125
1707-004
50
50
1706
-005
1705-006
1704-007
102
1703-008
SHEFFIELD
80
28th
58.5
70
830 TO N.L. 28TH
+ WITH W. LAKEWOOD AVE
246.09
142.1
92.16
145.10
125
34
12
100
LANY
FULTON
240X125 4.0.69A
0.52A SPLIT
0.17A
0.69A
101
pt. -027
pt. 13.71A.
10/31/91
#1938
APPROVED
LORAIN CO.
MAP DEPT.
DATE 5-22-91
PAGE 3-00-097-A
BY CAROLYN FRANCIS
VOID AFTER # 1938
03-00-091-102- PRIOR INST. 1214/735
SURVEYED BY: PHILLIP A. ROSEBECK
REG. SURVEYOR
C=1; INF