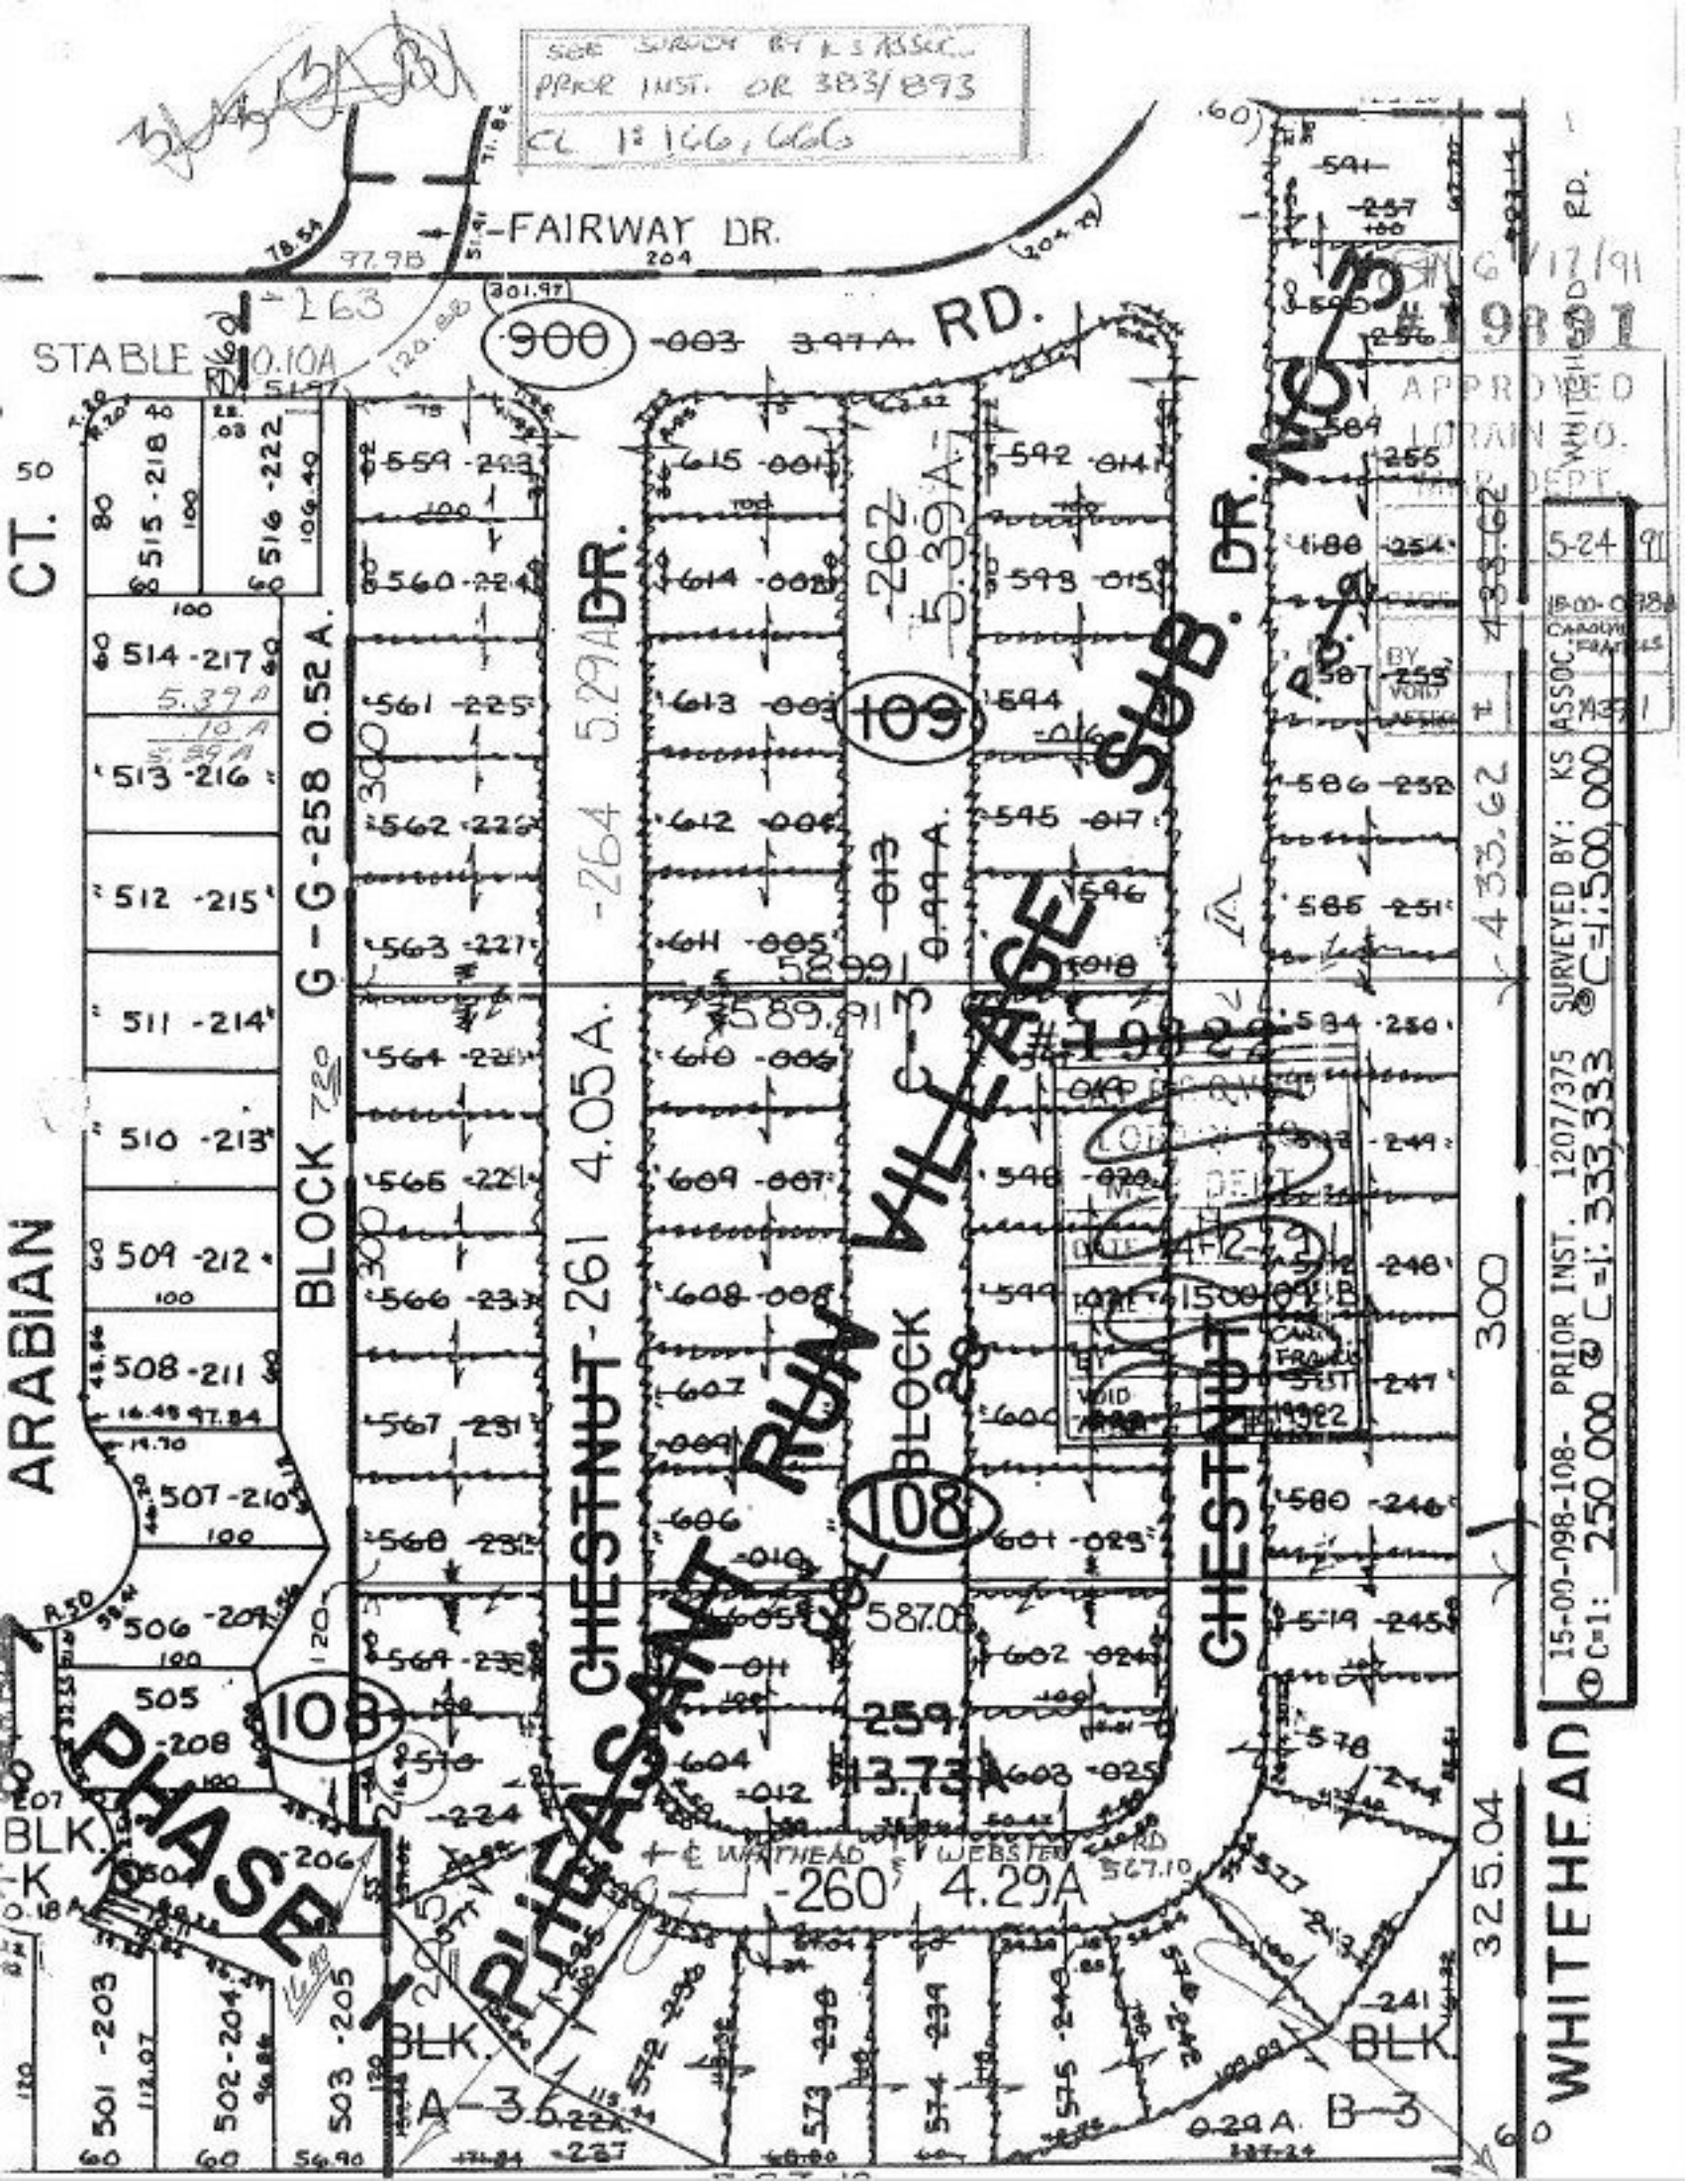
SEE SURVEY BY K S ASSOC.
PRIOR INST. OR 383/893
CL 1: 166,666
FAIRWAY DR.
STABLE 0.10A
900
003
3.97A
RD.
WHITEHEAD
RD.
CT.
ARABIAN
BLOCK G-G-258 0.52 A.
514 -217
513 -216
512 -215
511 -214
510 -213
509 -212
508 -211
507 -210
506 -209
505 -208
504 -207
501 -203
502 -204
503 -205
BLK. K
BLK. A
BLK. B
PHASE I
PHASE II
CHESTNUT
261
4.05A.
264
5.29A
DR.
109
108
262
5.39A
VILLAGE
SUB.
DR. NO. 5
CHESTNUT
RUN
259
3.73A
260
4.29A
WEBSTER
325.04
300
433.62
589.91
587.08
567.10
0.29A
APPROVED
LORAIN CO.
ENGINEER DEPT.
5-24
91
15-00-098-108- PRIOR INST. 1207/375 SURVEYED BY: KS ASSOC.
C=1: 250.000 @ C=1: 333.333 @ C=1: 1,500.000