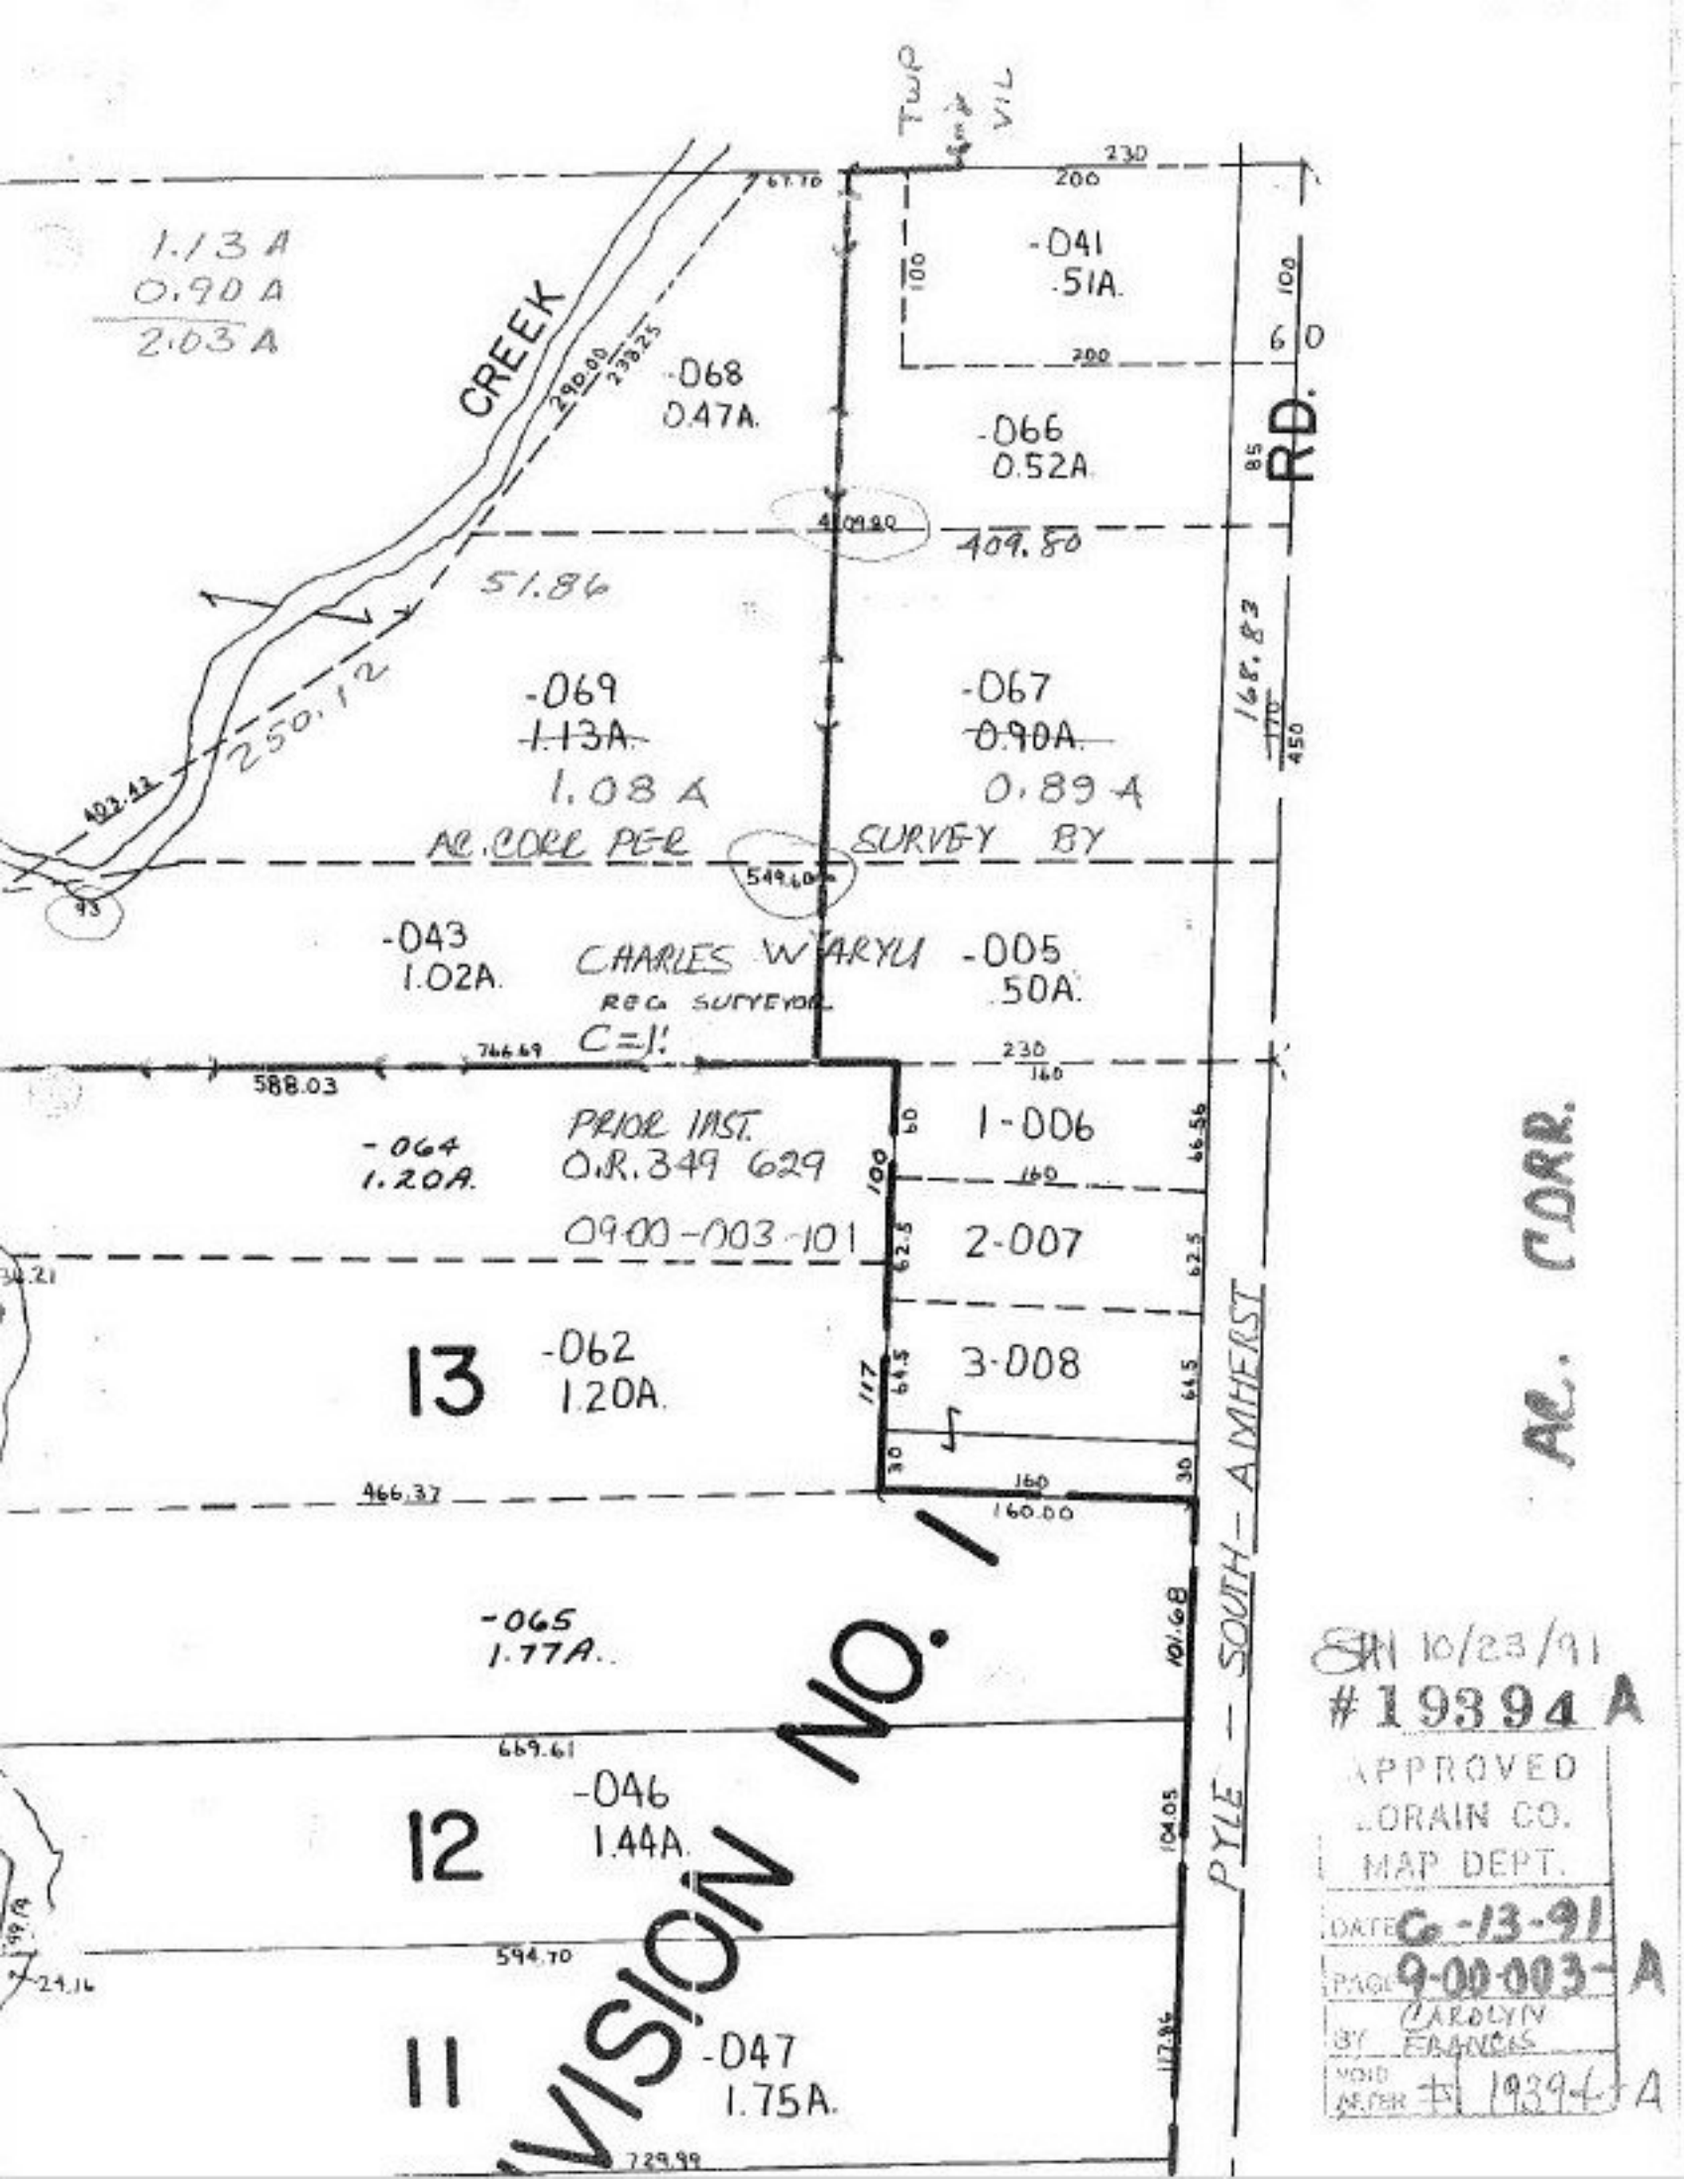

SUBDIVISION NO. 1

SM 10/23/91
#19394 A
APPROVED
LORAIN CO.
MAP DEPT.
DATE 6-13-91
PAGE 9-00-003-A
BY CAROLYN FRANCAS
VOID AFTER # 19394-A