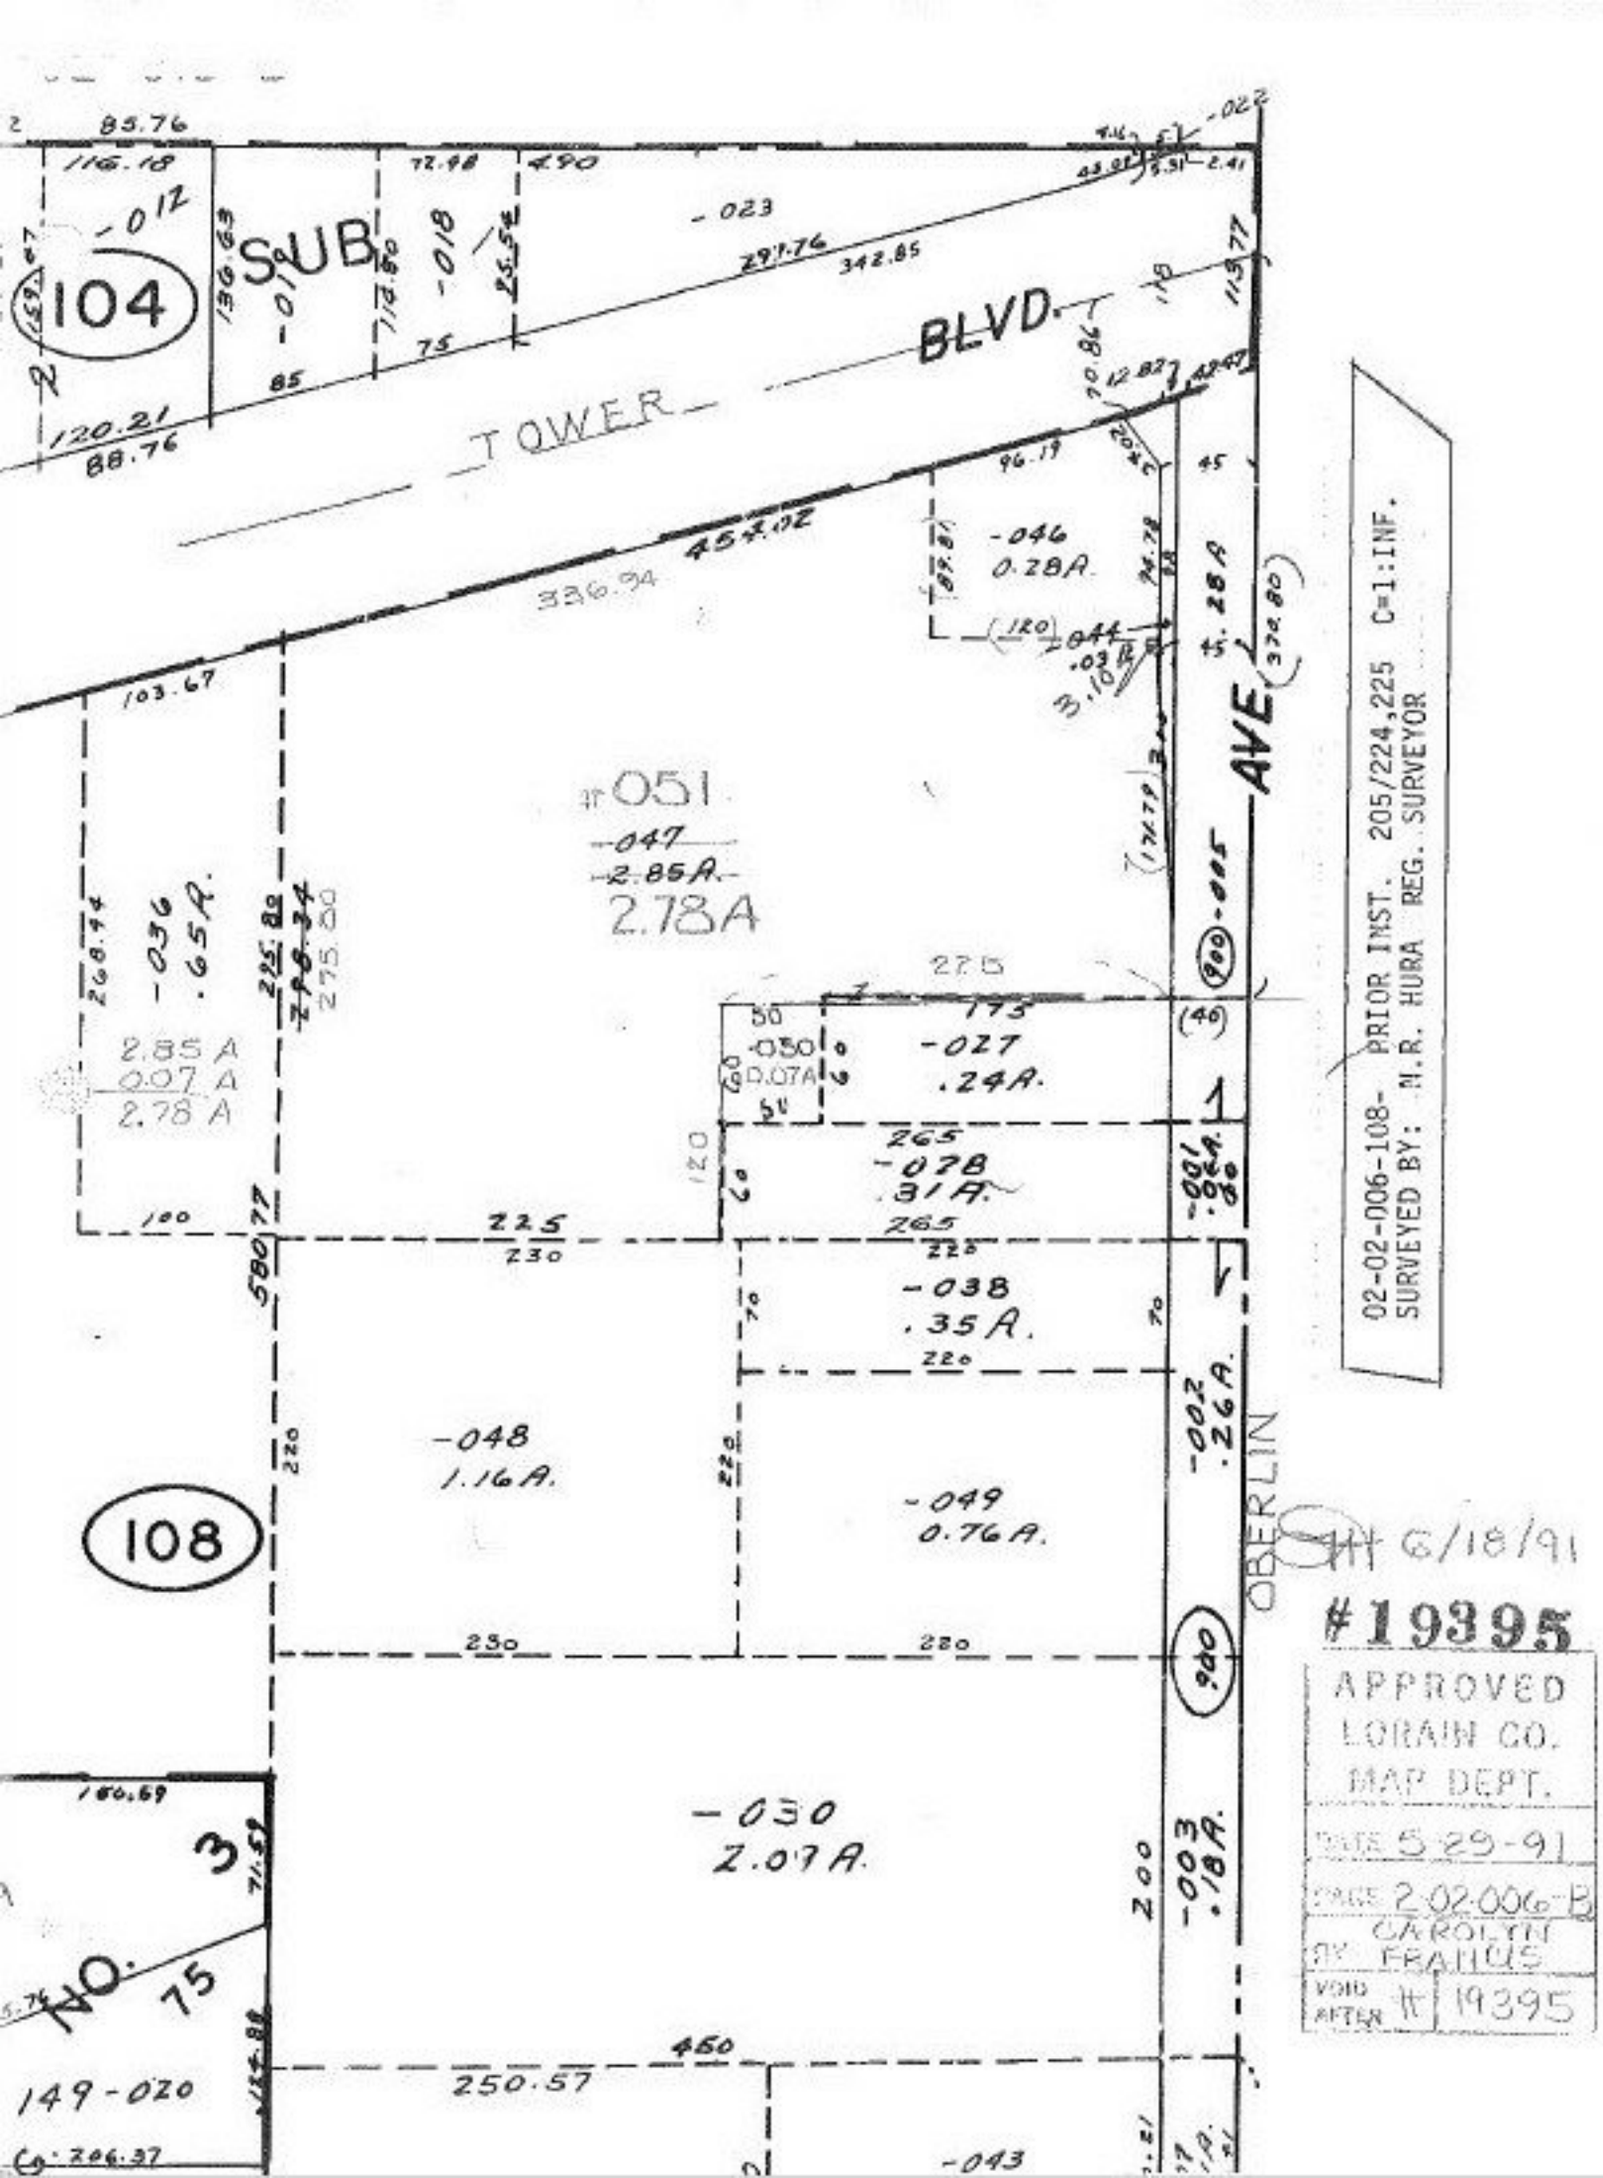
104
SUB
-012
-018
-023
TOWER BLVD.
-046
0.28A.
-044
.03A.
-051
-047
2.78A
-036
.65A.
2.85 A
0.07 A
2.78 A
-027
.24A.
-035
-038
.35A.
-048
1.16A.
-049
0.76A.
-030
2.07A.
-003
.18A.
-002
.26A.
-001
.80
108
3
149-020
AVE
OBERLIN
02-02-006-108- PRIOR INST. 205/224,225 C=1:INF.
SURVEYED BY: M.R. HURA REG. SURVEYOR
6/18/91
#19395
APPROVED
LORAIN CO.
MAP DEPT.
DATE 5-29-91
PAGE 2-02-006-B
CAROLYN
BY FRANUS
VOID AFTER # 19395