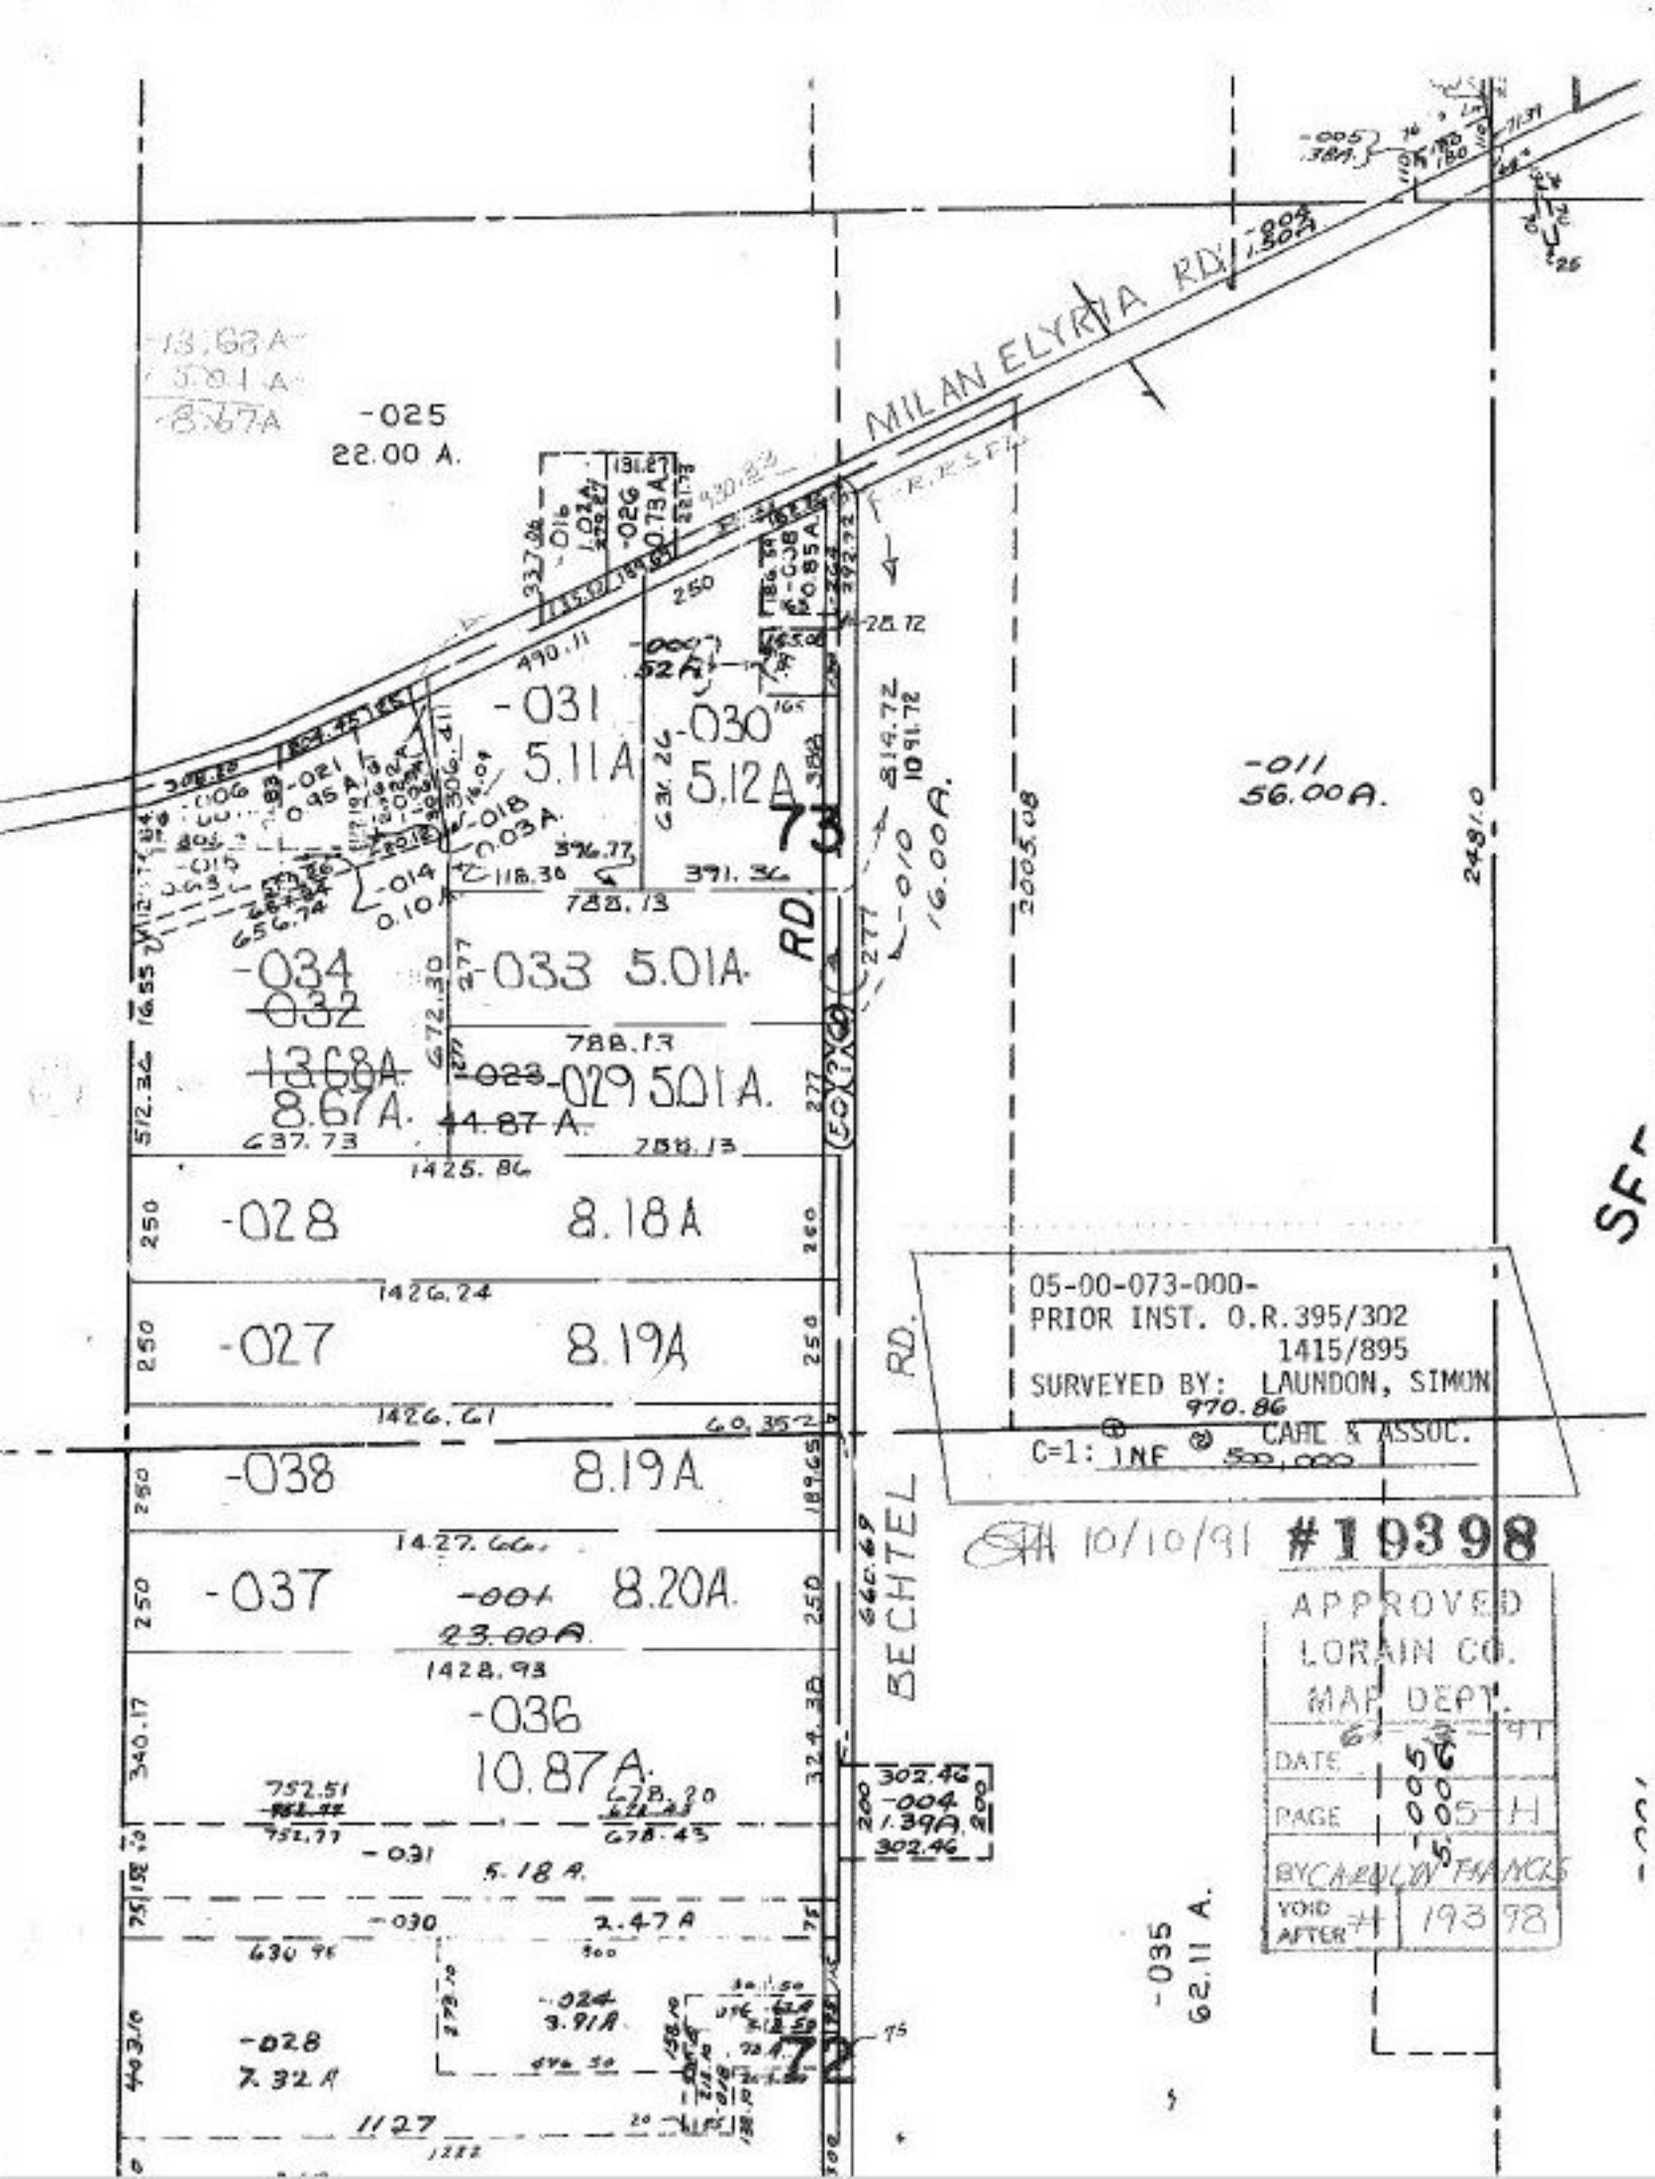
MILAN ELYRIA RD.
-025
22.00 A.
-031
5.11A
-030
5.12A
-011
56.00A.
-034
-032
13.68A
8.67A.
-033 5.01A.
-023
-029 5.01A.
44.87 A.
-028
8.18A
-027
8.19A
-038
8.19A
-037
-001
8.20A.
23.00A.
-036
10.87A.
-031
5.18 A.
-030
2.47 A
-024
3.91A
-028
7.32 A
-035
62.11 A.
-004
1.39A.
BECHTEL RD.
05-00-073-000-
PRIOR INST. O.R. 395/302
1415/895
SURVEYED BY: LAUNDON, SIMON
CARL A ASSOC.
C=1: INF @ 500,000
10/10/91 #19398
APPROVED
LORAIN CO.
MAP DEPT.
DATE
PAGE
BY CAROLYN THANOS
VOID AFTER 19398