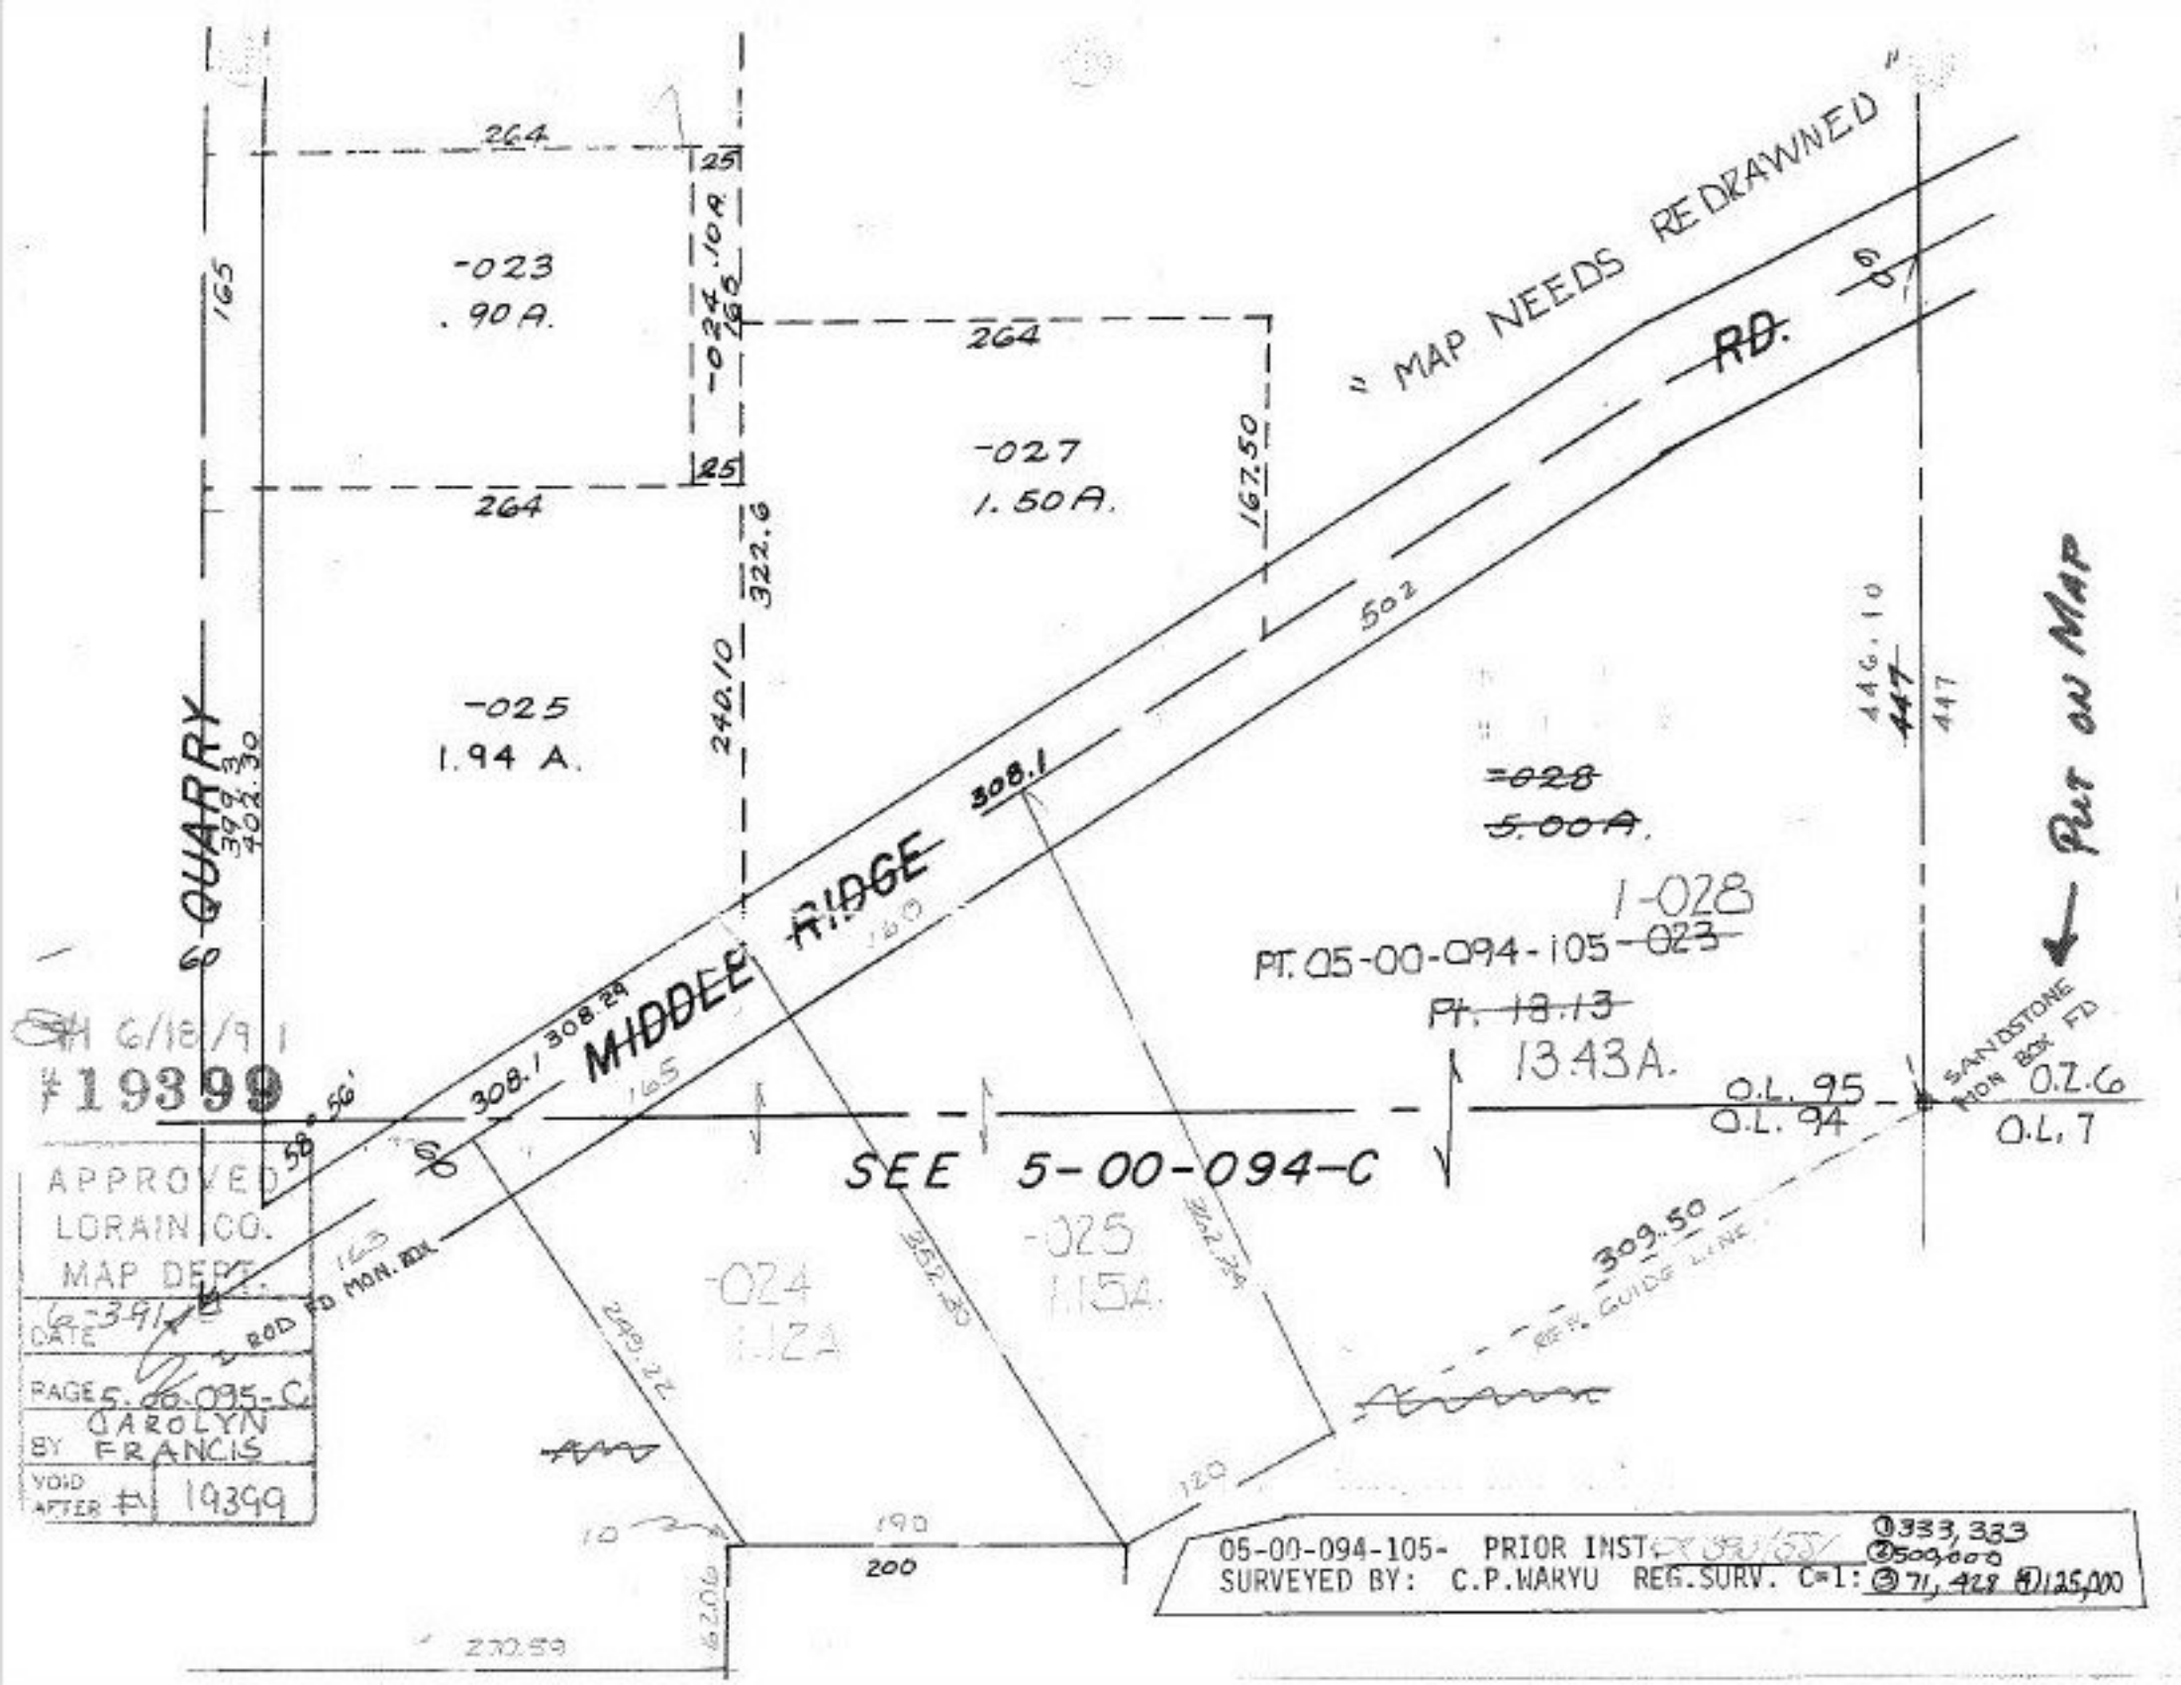
264
25
165
-023
.90 A.
-024 .10 A.
264
-027
1.50 A.
167.50
264
322.6
240.10
-025
1.94 A.
QUARRY
399.30
402.30
60
MIDDLE RIDGE RD.
308.1
308.24
160
165
50
50
SEE 5-00-094-C
-024
1.12A
-025
1.15A.
249.22
257.30
262.24
309.50
REF. GUIDE LINE
120
190
200
10
206.62
270.59
" MAP NEEDS REDRAWNED
502
446.10
447
447
-028
5.00A.
1-028
PT. 05-00-094-105 -023
Pt. 18.13
13.43A.
Put on Map
SANDSTONE MON BOX FD
O.L. 95
O.L. 94
O.L. 76
O.L. 7
6/18/91
#19399
APPROVED
LORAIN CO.
MAP DEPT.
DATE 6-3-91
PAGE 5.00.095-C
BY CAROLYN FRANCIS
VOID AFTER # 19399
ROD FD MON. BOX
05-00-094-105- PRIOR INST. OR 389/653
SURVEYED BY: C.P.WARYU REG.SURV. C=1:
①333,333
②509,000
③71,428 ④125,000