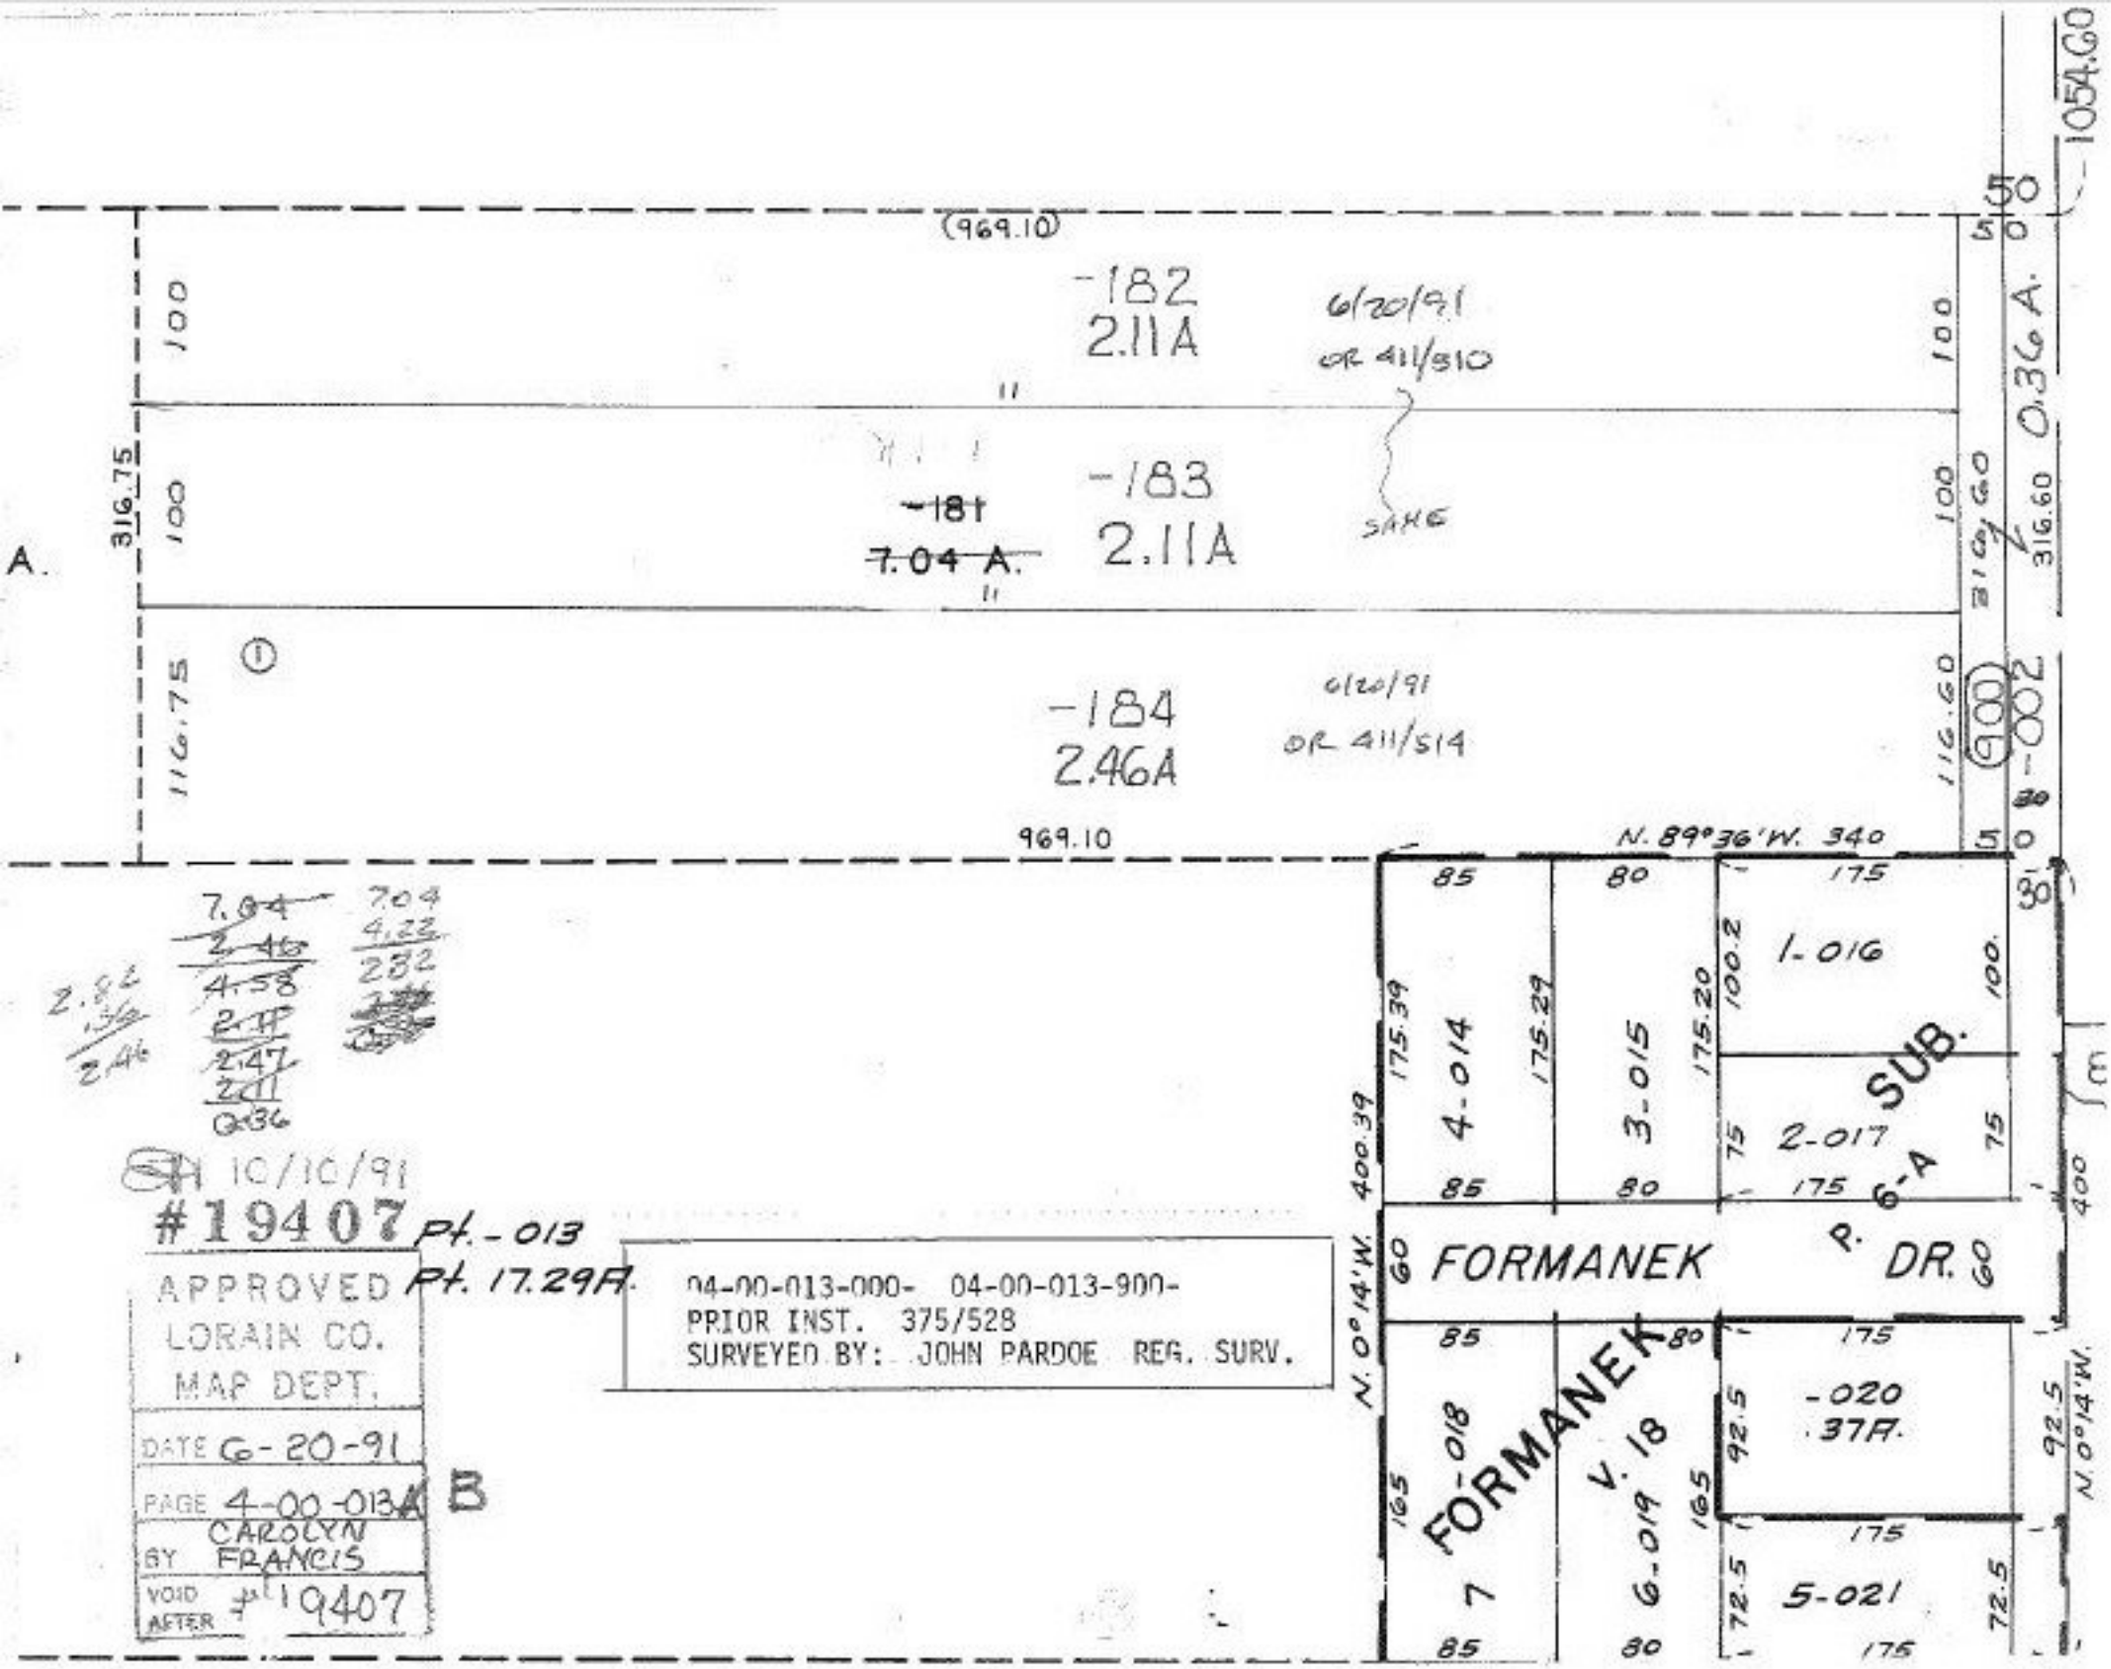

7.04 — 2.46 — 4.58 — 2.11 — 2.47 — 2.11 — 0.36

7.04 — 4.23 — 2.32

2.82 — 1.36 — 2.46

10/10/91

#19407 Pt. -013

Pt. 17.29A.

APPROVED
LORAIN CO.
MAP DEPT.
DATE 6-20-91
PAGE 4-00-013A
BY CAROLYN FRANCIS
VOID AFTER # 19407

B

04-00-013-000- 04-00-013-900-
PRIOR INST. 375/528
SURVEYED BY: JOHN PARDOE REG. SURV.