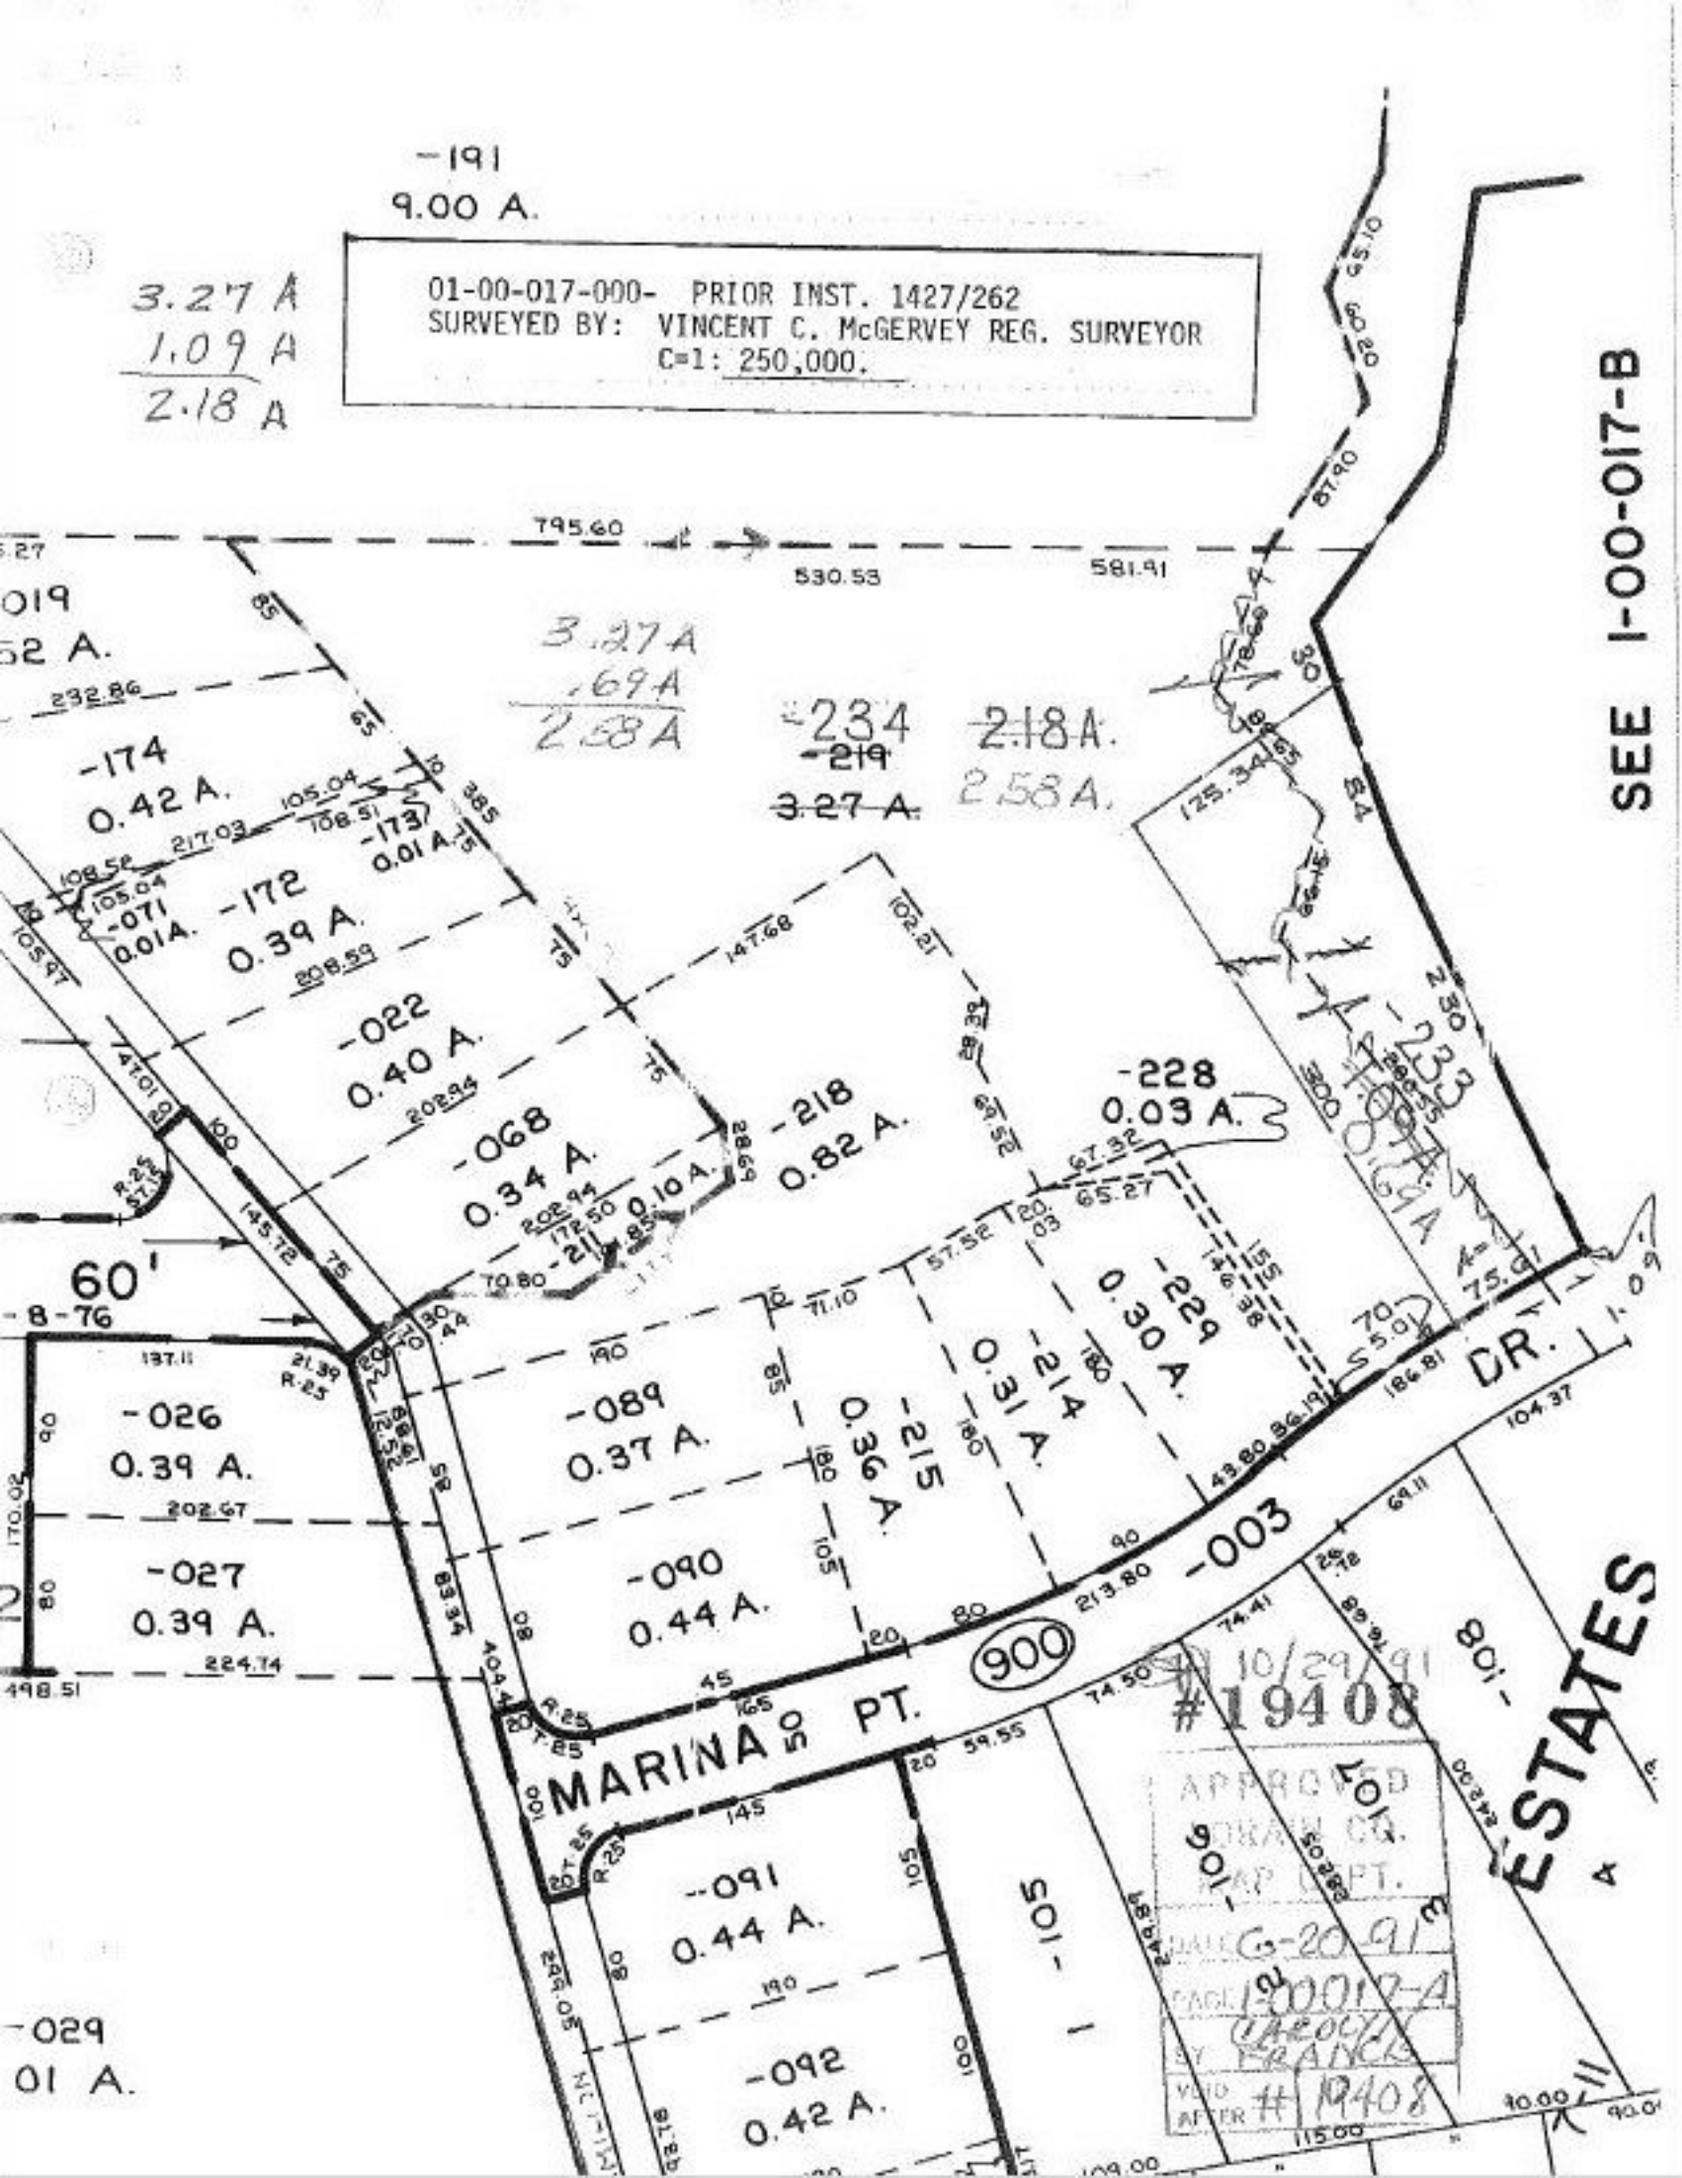
-191
9.00 A.
3.27 A
1.09 A
2.18 A
01-00-017-000- PRIOR INST. 1427/262
SURVEYED BY: VINCENT C. McGERVEY REG. SURVEYOR
C=1: 250,000.
SEE 1-00-017-B
795.60
530.53
581.91
3.27A
.69A
2.58A
-234
-219
3.27 A.
2.18A.
2.58A.
-174
0.42 A.
-173
0.01 A.
-172
0.39 A.
-071
0.01A.
-022
0.40 A.
-068
0.34 A.
-218
0.82 A.
-228
0.03 A.
-233
-089
0.37 A.
-215
0.36 A.
-214
0.31 A.
-229
0.30 A.
-026
0.39 A.
-027
0.39 A.
-090
0.44 A.
-091
0.44 A.
-092
0.42 A.
-003
-029
01 A.
60'
MARINA PT.
900
DR.
ESTATES
10/29/91
#19408
APPROVED
DRAIN CO.
MAP DEPT.
DATE 6-20-91
PAGE 1-00017-A
BY FRANCES
VOID AFTER # 19408