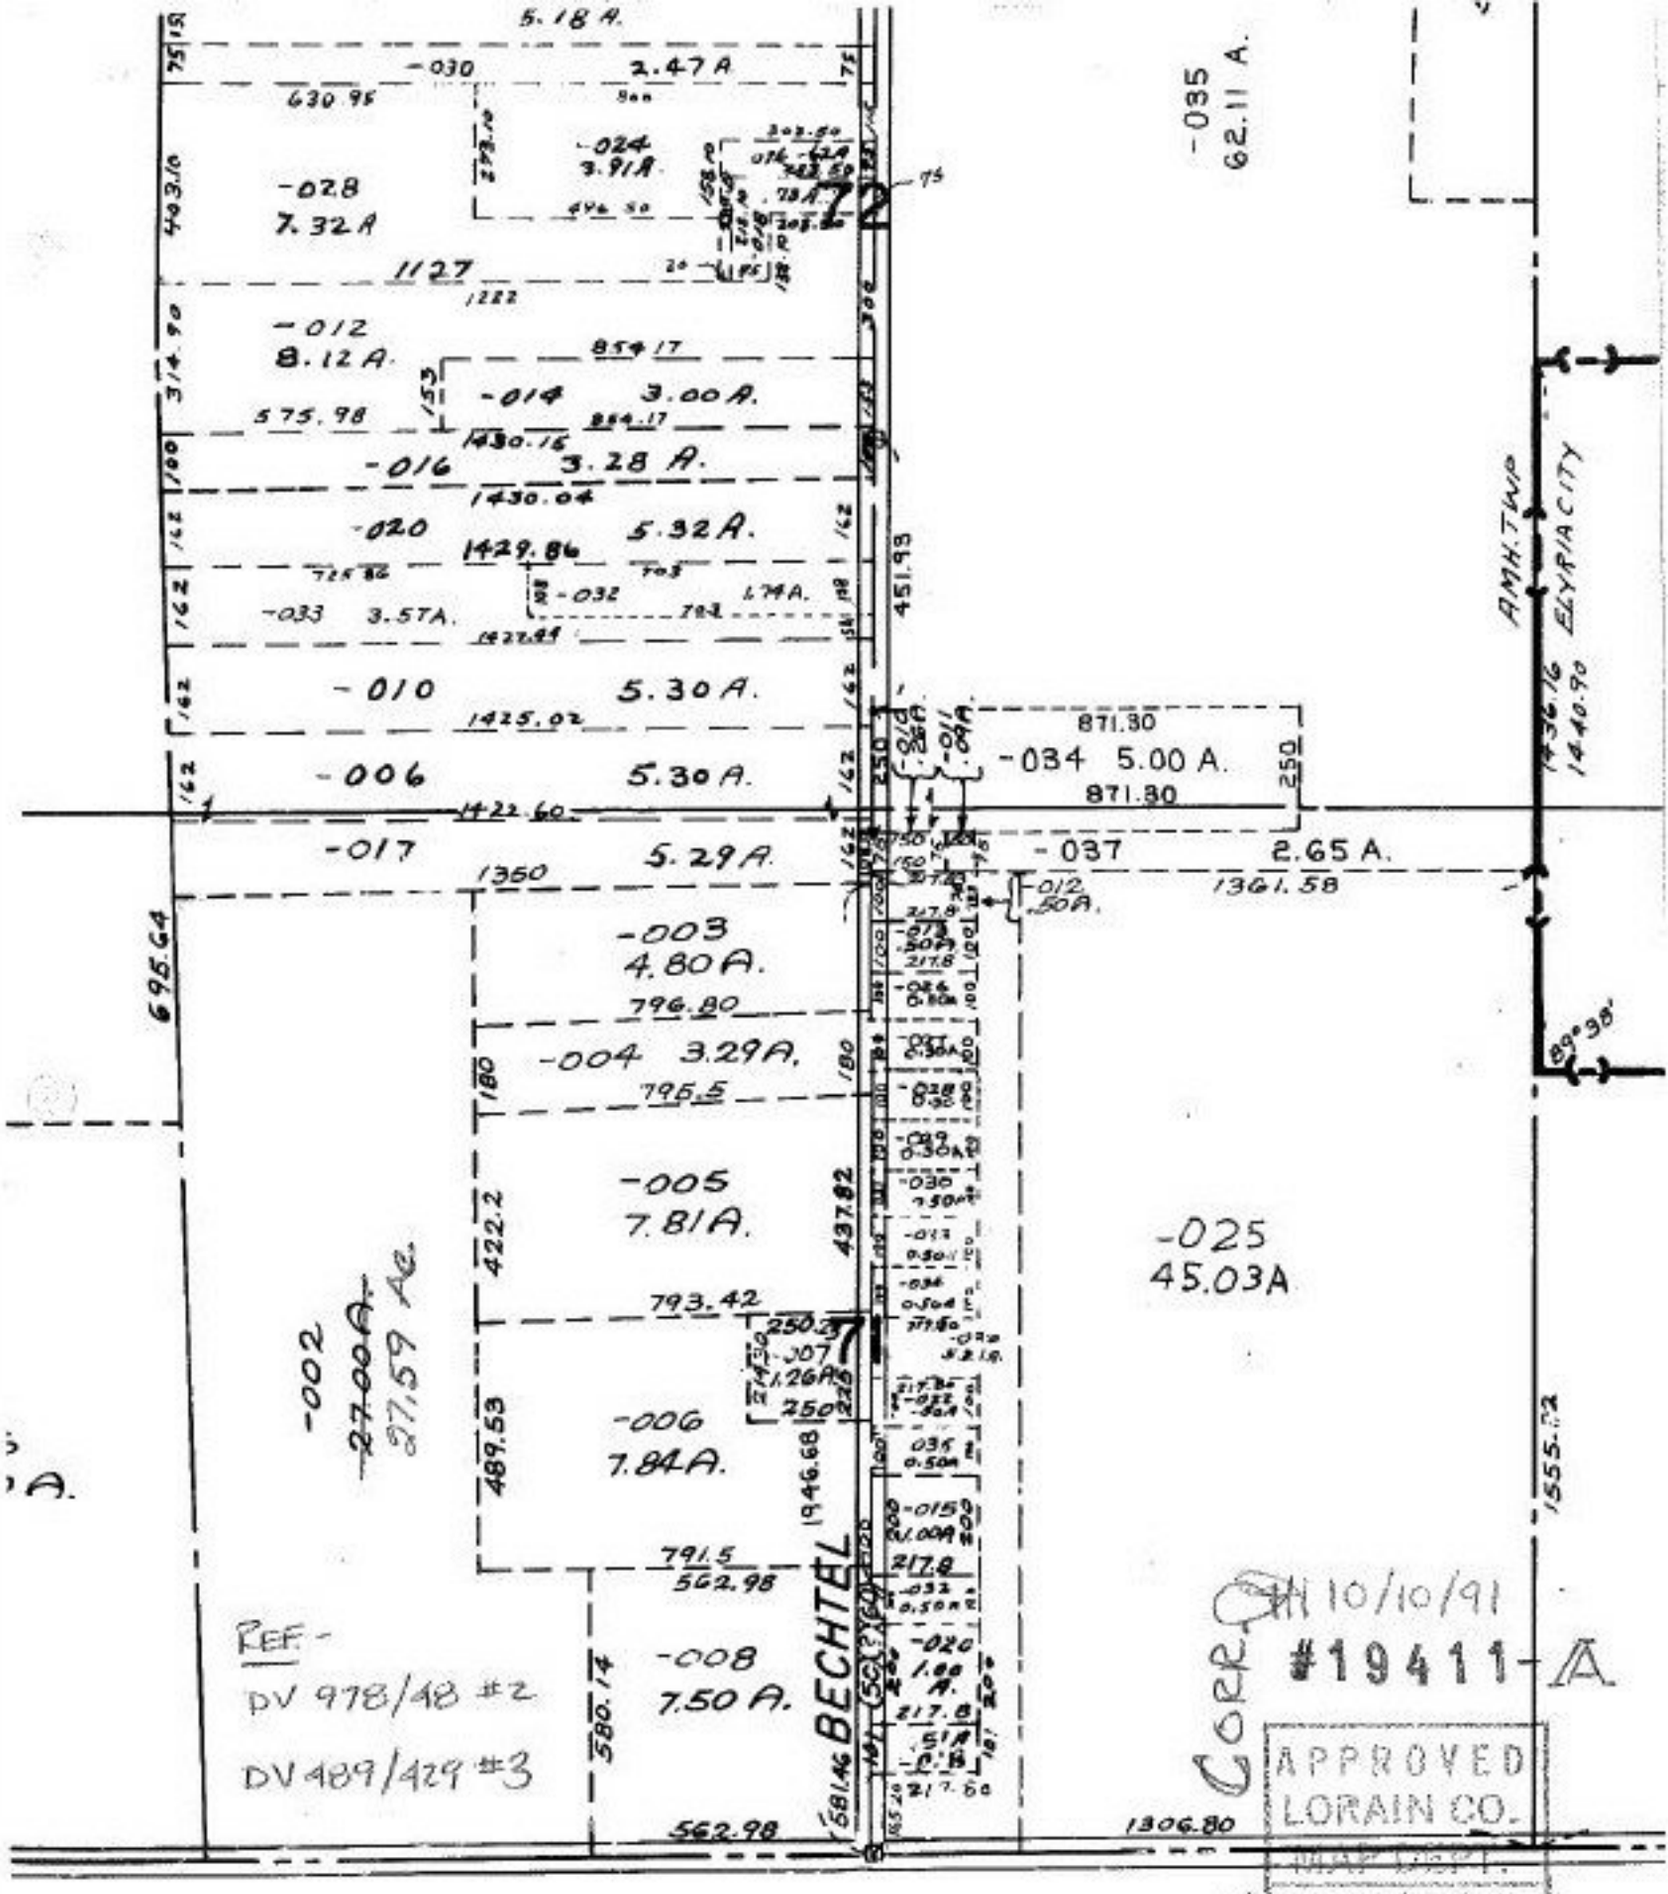
5.18 A.
-030 2.47 A.
630.95
-024 3.91 A.
-028 7.32 A.
403.10
1127
-012 8.12 A.
314.90
-014 3.00 A.
575.98
1430.16
-016 3.28 A.
1430.04
-020 5.32 A.
1429.86
-033 3.57A.
-032 1.44A.
-010 5.30 A.
1425.02
-006 5.30 A.
1422.60
-017 5.29 A.
1350
695.64
-003 4.80 A.
796.80
-004 3.29 A.
795.5
-005 7.81 A.
422.2
793.42
-002 27.00A. 27.59 Ac.
489.53
-007 1.26A.
-006 7.84 A.
791.5
562.98
-008 7.50 A.
580.14
562.98
BECHTEL
1946.68
437.82
451.98
-035 62.11 A.
AMH. TWP
1436.16 ELYRIA CITY
1440.90
871.30
-034 5.00 A.
871.30
-037 2.65 A.
1361.58
-012 .50A.
-025 45.03A
1555.12
1306.80
89°38'
REF -
DV 978/48 #2
DV 489/429 #3
ACRE.
CORR. 10/10/91
#19411-A
APPROVED
LORAIN CO.
MAP DEPT.
DATE 6/26/91
PAGE 5-H
BY T. McMain
VOID AFTER 19411-A