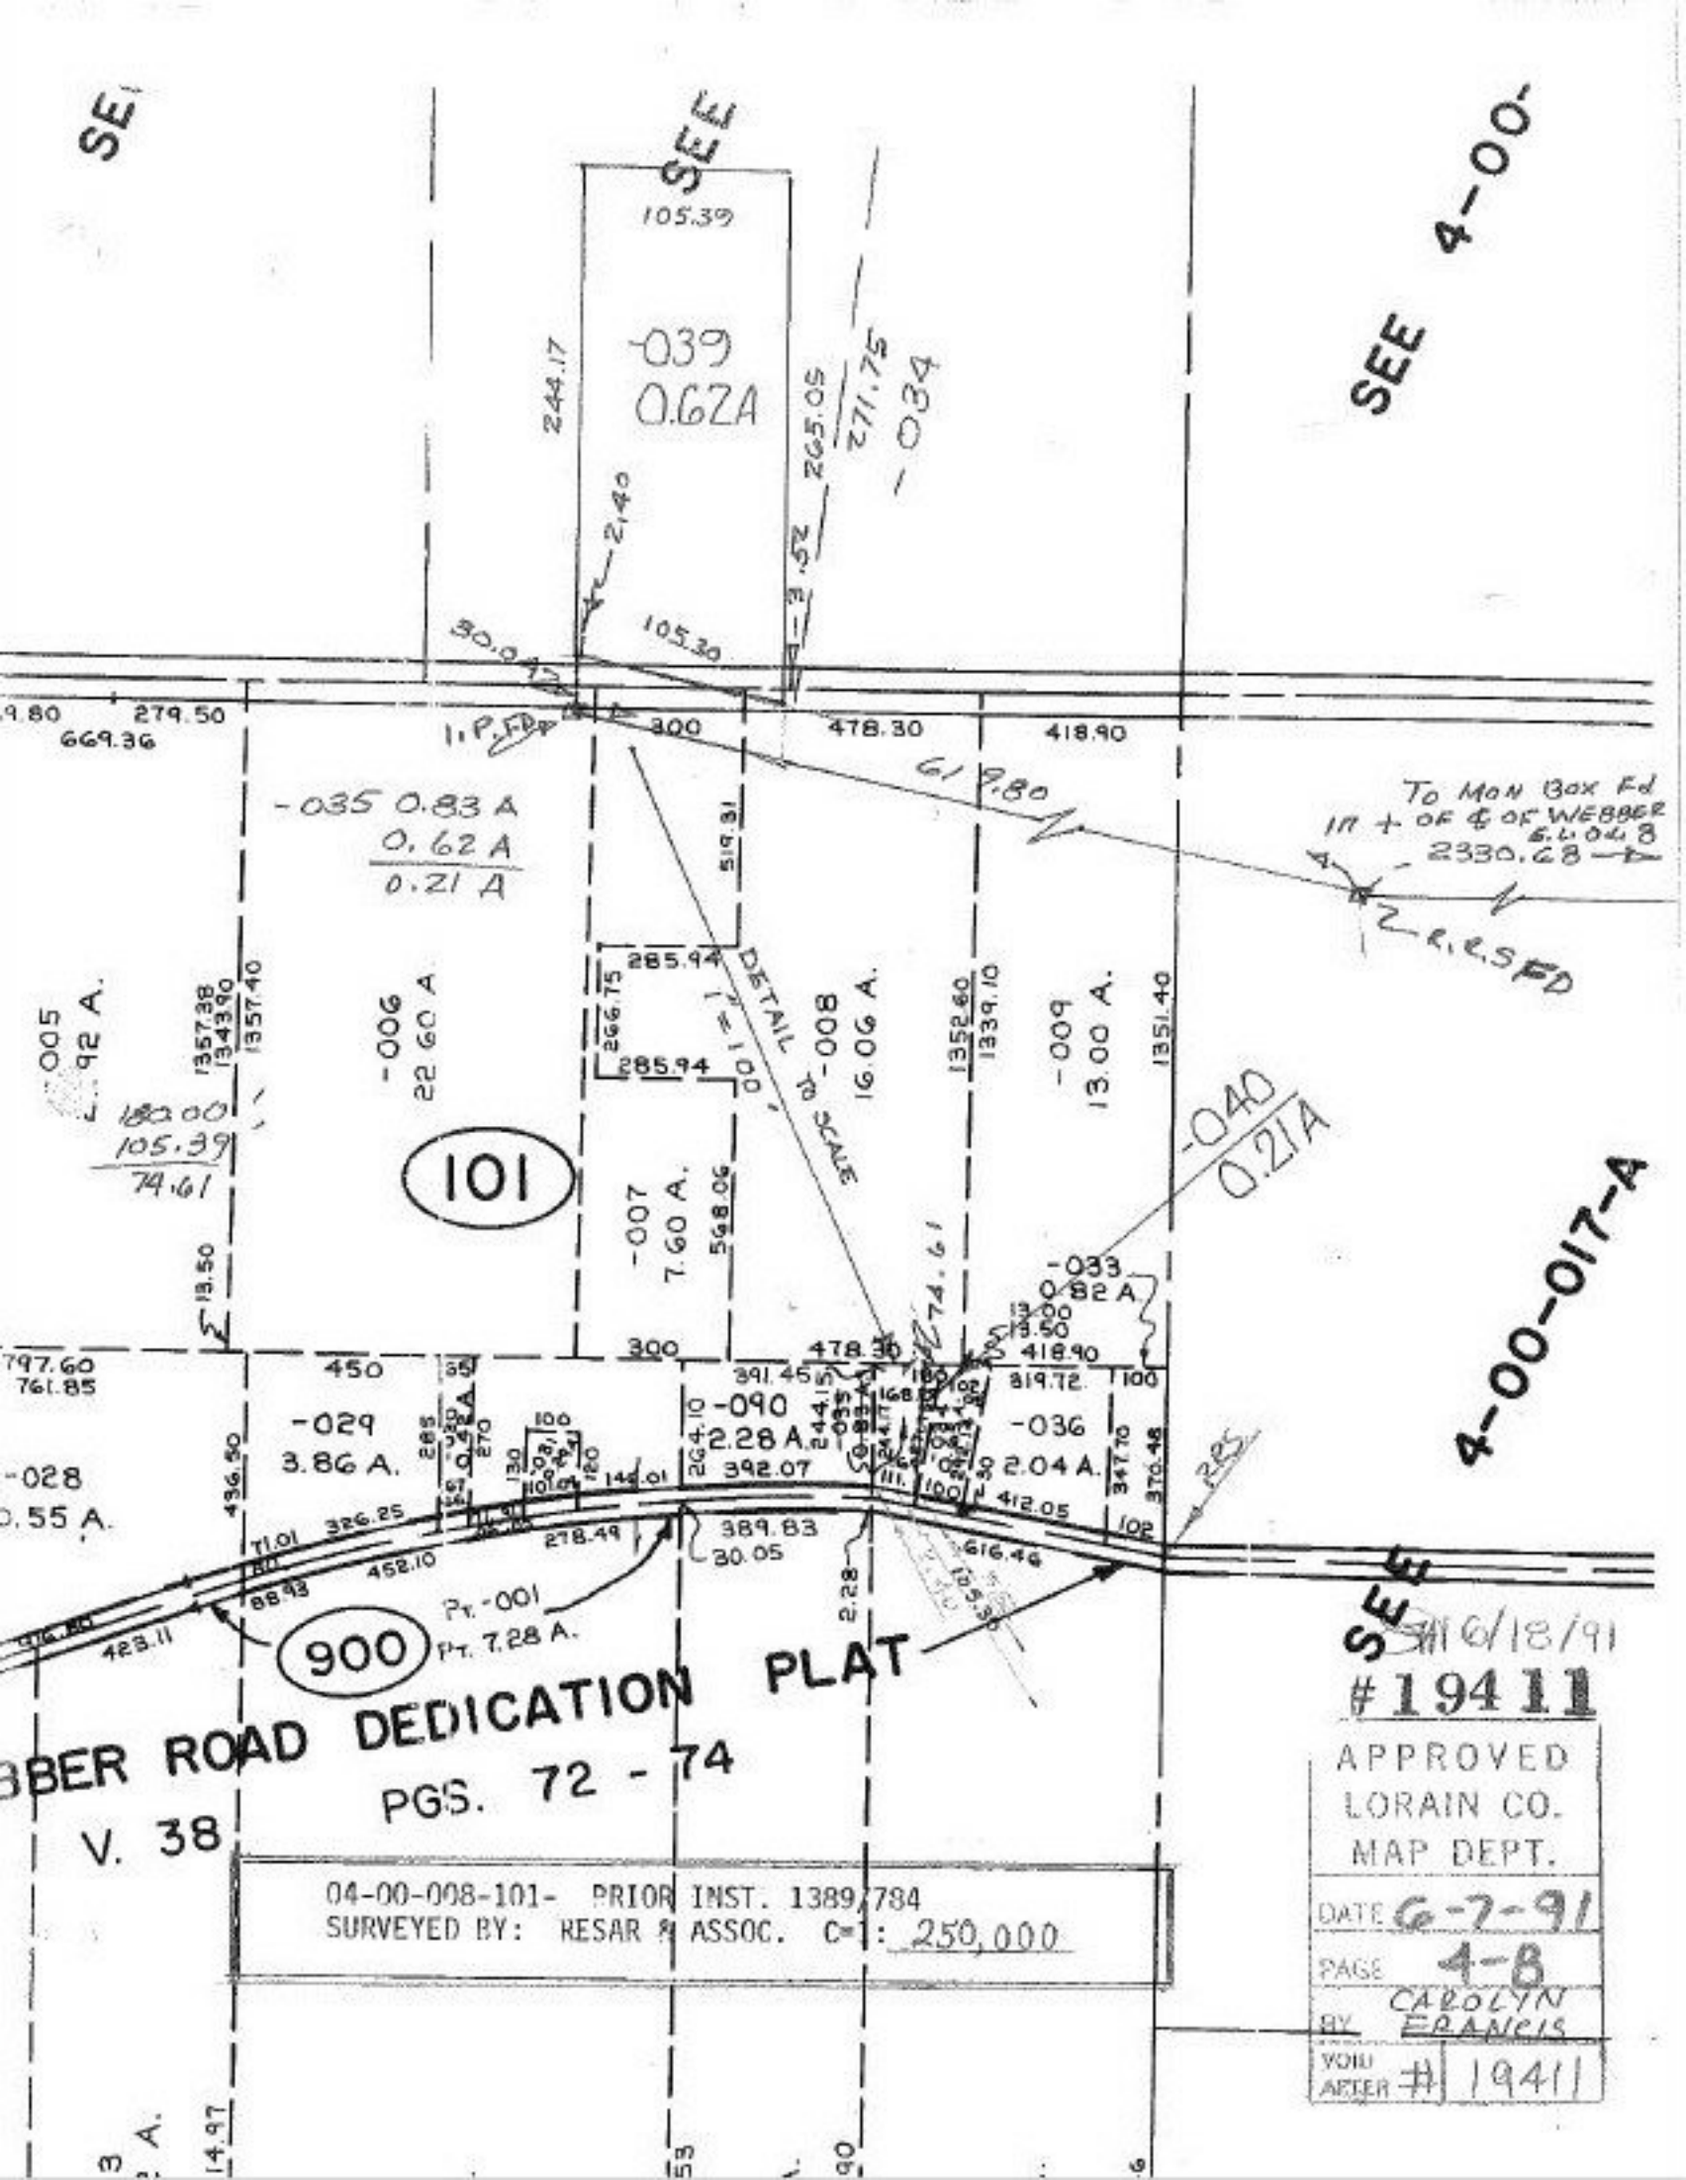
SEE
SEE
SEE 4-00-
105.39
-039
0.62A
244.17
265.05
271.75
-034
2.40
3.52
105.30
30.04
279.50
669.36
300
478.30
418.90
619.80
To Mon Box Fd
in + of ℄ of Webber
2330.68
R.R.S FD
-035 0.83 A
0.62 A
0.21 A
519.31
285.94
266.75
285.94
DETAIL TO SCALE
1" = 100'
-008
16.06 A.
1352.60
1339.10
-009
13.00 A.
1351.40
-006
22.60 A
1357.38
1343.90
1357.40
180.00
105.39
74.61
101
-007
7.60 A.
568.06
-040
0.21A
-033
0.82 A
13.00
13.50
418.90
797.60
761.85
450
300
478.30
391.45
319.72
-029
3.86 A.
-090
2.28 A.
-036
2.04 A.
-028
0.55 A.
436.50
392.07
347.70
370.48
412.05
326.25
278.49
389.83
30.05
616.46
452.10
88.93
423.11
Pt. -001
Pt. 7.28 A.
900
4-00-017-A
SEE
BBER ROAD DEDICATION PLAT
PGS. 72 - 74
V. 38
04-00-008-101- PRIOR INST. 1389/784
SURVEYED BY: RESAR & ASSOC. C=1: 250,000
6/18/91
#19411
APPROVED
LORAIN CO.
MAP DEPT.
DATE 6-7-91
PAGE 4-8
BY CAROLYN FRANCIS
VOID AFTER # 19411